


RECORD DRAWING
SHOWN PICTORALLY. MAY NOT BE TO SCALE.
THESE AS-BUILT OR RECORD DRAWINGS HAVE BEEN PREPARED IN PART ON THE BASIS OF INFORMATION COMPILED AND FURNISHED BY OTHERS. THE ENGINEER WILL NOT BE RESPONSIBLE FOR ANY ERRORS OR OMISSIONS WHICH HAVE BEEN INCORPORATED INTO THIS DOCUMENT AS A RESULT OF INFORMATION BY OTHERS.



NO.	DATE	REVISIONS	DSM	KAS	DRWN	CHKD
1	12/09	AS-BUILT INFORMATION ADDED	DSM	KAS	DRWN	CHKD

TIMOTHY D. SMITH & ASSOCIATES, PC ARCHITECTS OLD RAILROAD STATION 802-442-8184 NORTH BENNINGTON, VERMONT 05257 FAX 802-442-8241		ROBERT W. HALL T.J. BOYLE AND ASSOCIATES LANDSCAPE ARCHITECTS 301 COLLIER STREET BURLINGTON, VERMONT 05401 802-868-8005 FAX 802-868-1582	
PROJECT NO. IM 091-1 (30) SOUTHEAST VERMONT WELCOME CENTER GUILFORD, VERMONT		DESIGN BY: JAC DRAWN BY: DSM CHECKED BY: JAC DATE: 1-16-98	
SHEET TITLE: RV DUMP STATION PLAN AND DETAILS		STATE OF VERMONT AGENCY OF ADMINISTRATION DEPARTMENT OF BUILDINGS & GENERAL SERVICES	

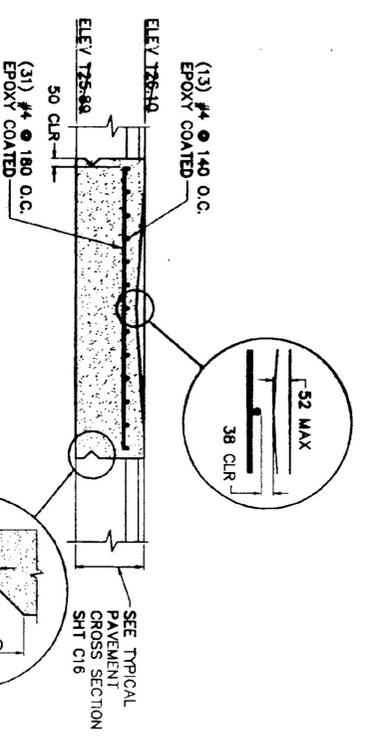