


SANITARY MANHOLE COVER DETAIL
NOT TO SCALE



STORM WATER MANHOLE COVER DETAIL
NOT TO SCALE




DETAIL AT LIGHT POLE/STORM SEWER
NOT TO SCALE

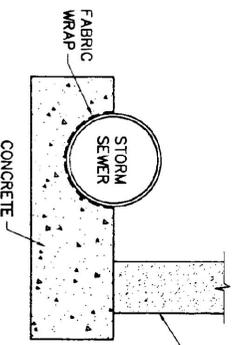


NOTE:
HEIGHT OF CONCRETE ON STORM SEWER PIPE VARIES W/FINISHED GRADE CONDITIONS

RECORD DRAWING
SHOWN PICTORALLY MAY NOT BE TO SCALE
THESE AS-BUILT OR RECORD DRAWINGS HAVE BEEN PREPARED, IN PART, ON THE BASIS OF SURVEYING CONTROLLED AND NOT REVISIONED BY OTHERS. THE DRAWER WILL NOT BE RESPONSIBLE FOR ANY DISCREPANCIES WHICH MAY BE FOUND WHEN COMPARED INTO THIS DOCUMENT AS A RESULT OF INFORMATION BY OTHERS.


PARALLEL WATER/SEWER MAIN DETAIL
NOT TO SCALE

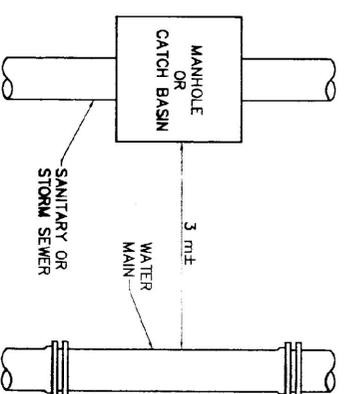


SILT FENCE DETAIL
NOT TO SCALE

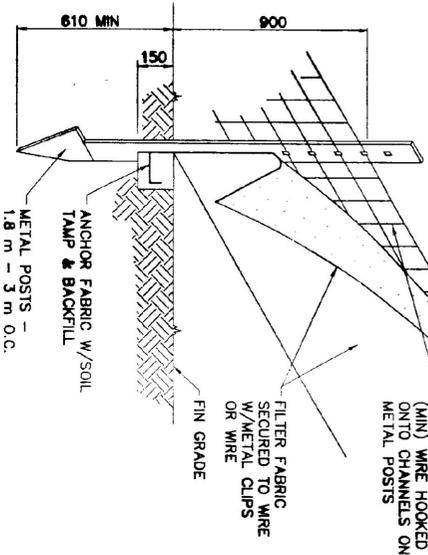


TYPICAL GRAVITY CLEANOUT DETAIL
NOT TO SCALE

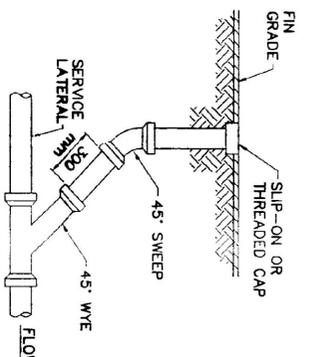



INFILTRATION BASIN OVERFLOW/OUTLET DETAIL
NOT TO SCALE

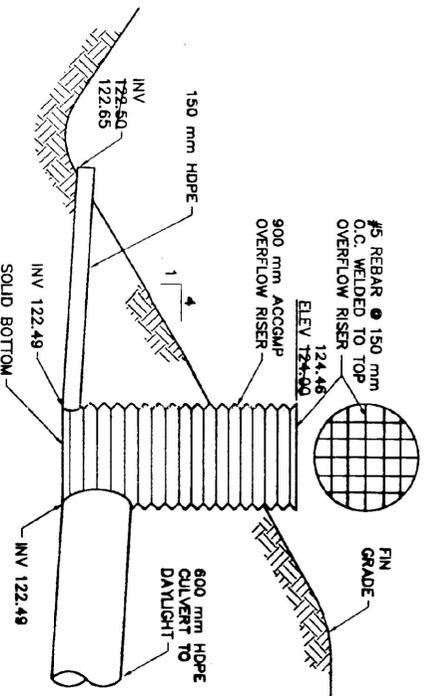

CATCH BASIN DETAIL
NOT TO SCALE

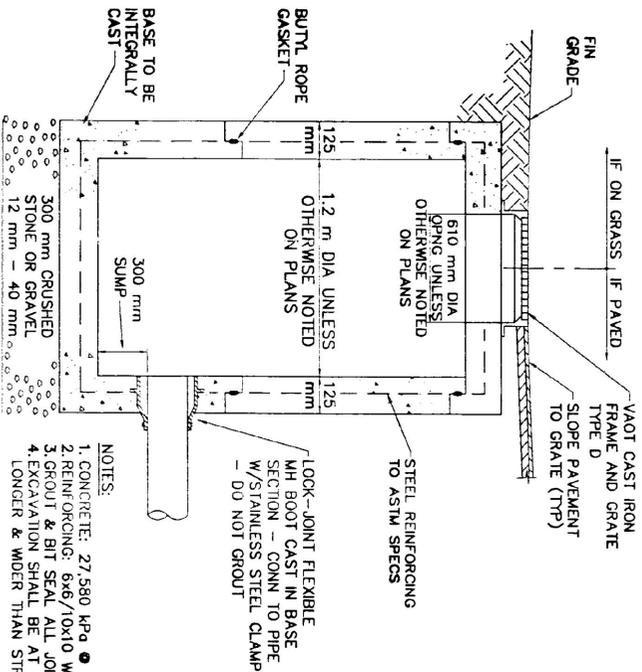


PRECAST MANHOLE/DROP MANHOLE DETAIL
NOT TO SCALE

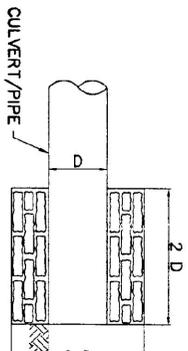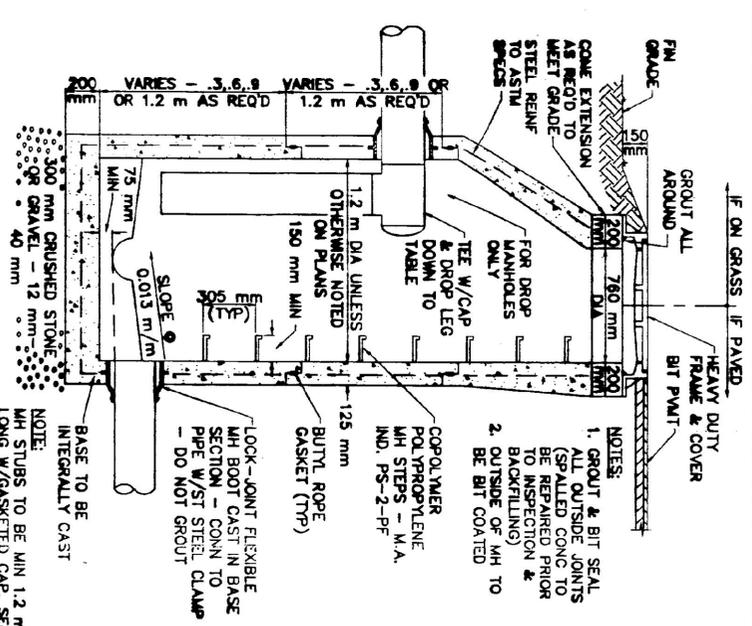

STONE HEADWALL DETAIL
NOT TO SCALE

OVERFLOW TERMINATION DETAIL
NOT TO SCALE

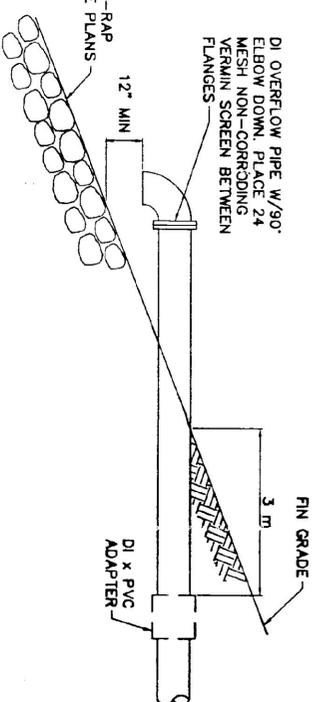

NO.	DATE	AS-BUILT INFORMATION ADDED	REVISIONS
1	12/90	AS-BUILT INFORMATION ADDED	DSM

DRWN	CHKD	DESIGNER	CHECKER
DSM	KAS	DRWN	CHKD

PROJECT NO.	DATE	PROJECT TITLE	DESIGNER
091-1 (30)	1-16-98	SOUTHEAST VERMONT WELCOME CENTER	JAC

STATE OF VERMONT	DEPARTMENT OF ADMINISTRATION
AGENCY OF ADMINISTRATION	DEPARTMENT OF BUILDINGS & GENERAL SERVICES

DESIGNER	DATE	SHEET NO.	OF SHEETS
DSM	1-16-98	33	33



33