
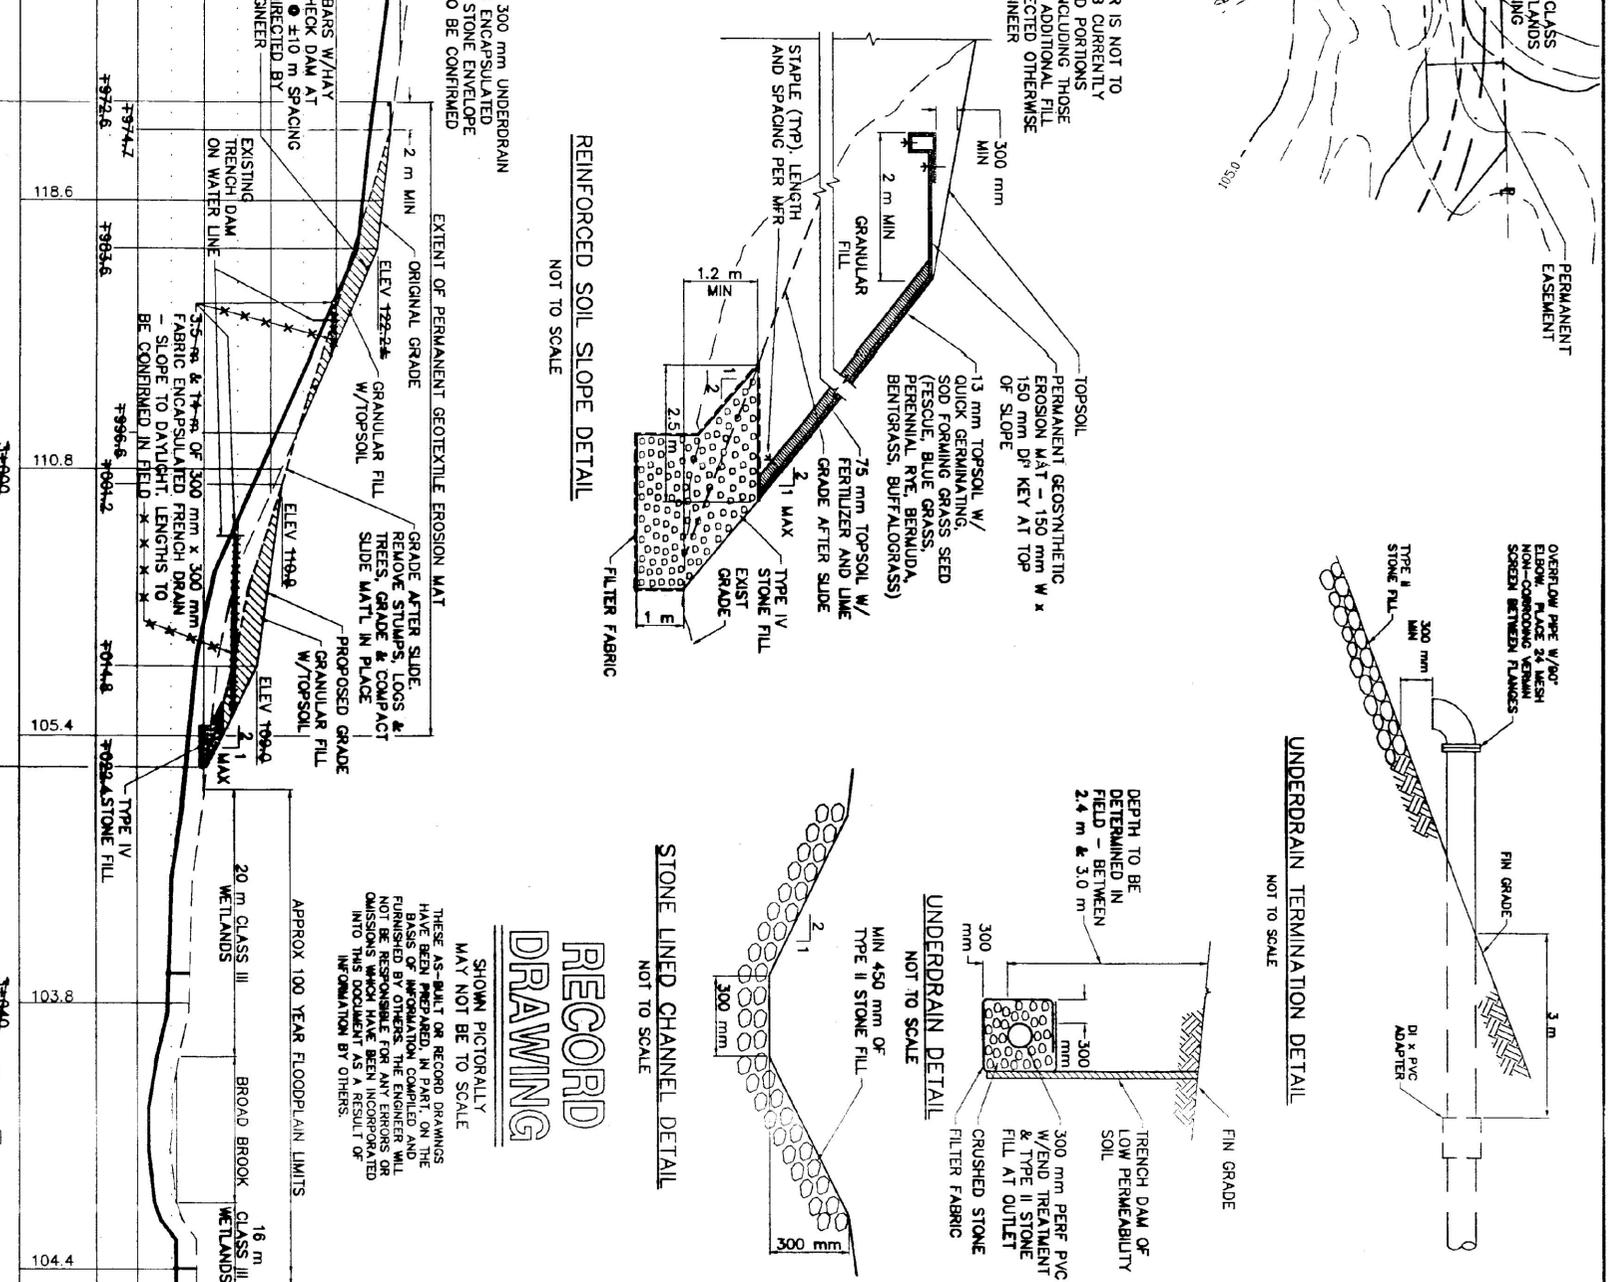


- NOTES
1. WORK INVOLVED TRANSPORT OF GRANULAR MATERIAL ACROSS BROAD BROOK MAY BE NECESSARY TO COMPLETE THIS PROJECT. THE CONTRACTOR SHALL BE RESPONSIBLE FOR THE COST OF SUCH TRANSPORTATION.
  2. ALL MATERIALS SHALL BE TRANSPORTED FROM STOCKPILES ON THE SOUTH SIDE OF BROAD BROOK TO THE NORTH SIDE FOR INSTALLATION ON THE NORTH BANK. ALL MATERIALS SHALL BE ACCUMULATED USING A LARGE FRONT END LOADER.
  3. ALL EQUIPMENT CROSSING BROAD BROOK SHALL BE CLEAN OF ALL CONTAMINANTS AND THE FRONT END LOADER OF ANY ROAD.
  4. THE VAIN STREAM ALTERATION ENGINEER SHALL BE WORKING ON THE SCHEDULE OF WORK AS WELL AS THE PERSONNEL AND EQUIPMENT TO BE USED.
  5. THE PERMANENT GEOSYNTHETIC EROSION MAT SHALL BE MADE OF SYNTHETIC MESH OR WEAVING WHICH RESISTS THE VEGETATIVE ROOT MASS. IT SHALL BE THREE PENETRABLE DEEPER THAN EITHER THE MATING OR THE SOIL. THE CONTRACTOR SHALL BE RESPONSIBLE FOR THE VEGETATION TO BE ESTABLISHED. THE CONTRACTOR SHALL BE RESPONSIBLE FOR THE VEGETATION TO BE ESTABLISHED. THE CONTRACTOR SHALL BE RESPONSIBLE FOR THE VEGETATION TO BE ESTABLISHED. THE CONTRACTOR SHALL BE RESPONSIBLE FOR THE VEGETATION TO BE ESTABLISHED.
  6. 1000 CLAS III WETLANDS OF GRANULAR FILL MATERIAL FOR THE CONTRACTOR'S USE WILL BE PROVIDED AT THE OWNER'S DISCRETION WITHIN 100 METERS OF BROAD BROOK AND ON THE SOUTH BANK OF BROAD BROOK.

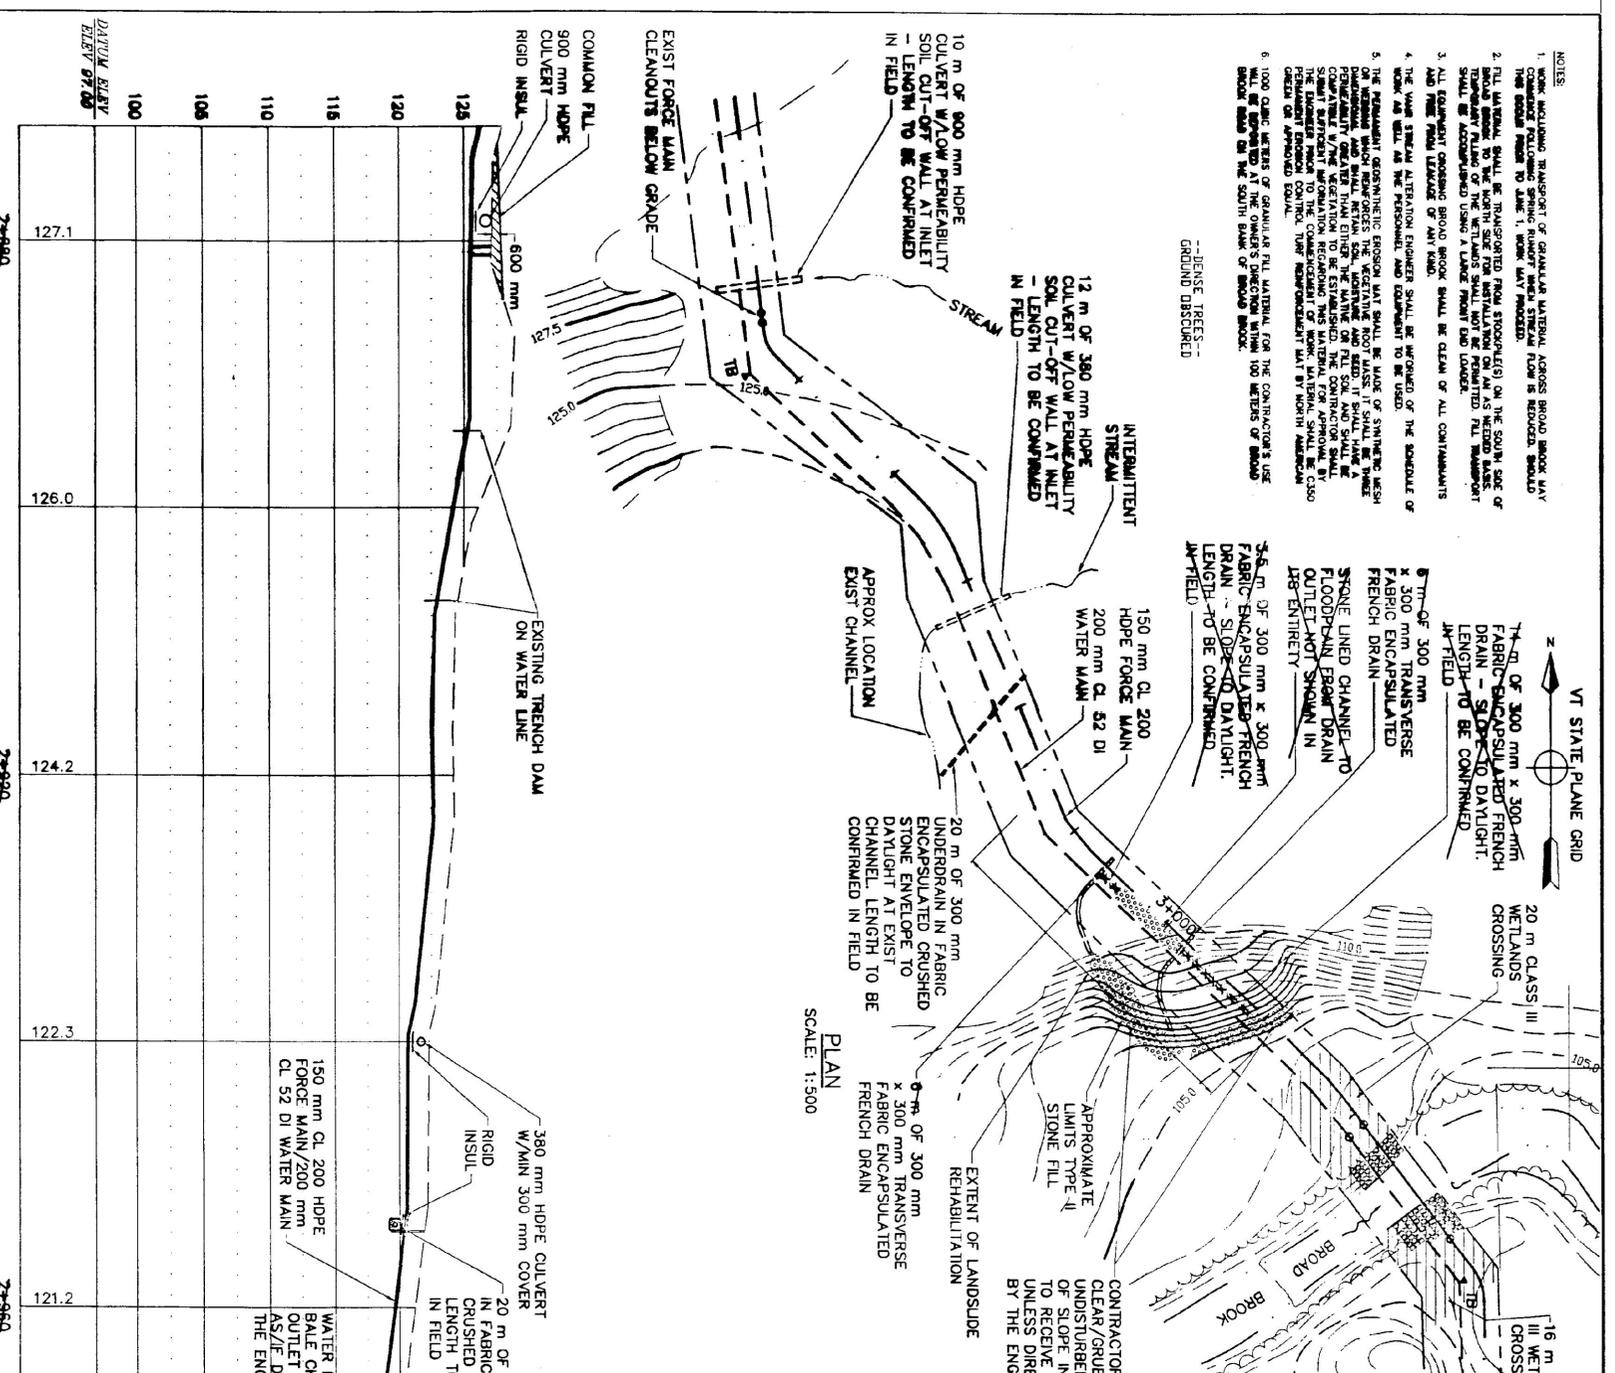

NO.	DATE	REVISIONS	DRAWN	CHECKED
1	12/99	AS-BUILT INFORMATION ADDED	DSM	KAS

TIMOTHY D. SMITH & ASSOCIATES, PC ARCHITECTS OLD RAILROAD STATION 802-442-8184 NORTH BENNINGTON, VERMONT 05257 FAX 802-442-6241	BRIGHT ENGINEERING, LTD. CIVIL ENGINEERS 20 N. MAIN ST. BRATTLEBORO, VERMONT 05743 TEL 802-253-1111	ROBT W. HALL CONSULTING ENGINEERS, INC. 415-789-0900 BRATTLEBORO, VERMONT 05743 TEL 802-888-3595	T.J. BOYLE AND ASSOCIATES LANDSCAPE ARCHITECTS 50 COLLEGE STREET BRATTLEBORO, VERMONT 05743 TEL 802-883-1062
---	---	--	--

PROJECT NO. IM 091-1 (30) SOUTHEAST VERMONT WELCOME CENTER GULFORD, VERMONT	DSGN BY: KAS DRAWN BY: DSM CHECK BY: KAS	STATE OF VERMONT AGENCY OF ADMINISTRATION DEPARTMENT OF BUILDINGS & GENERAL SERVICES
---	--	---

SHEET TITLE: SLOPE FAILURE NORTH OF BROAD BROOK	CHECKED BY: KAS	DATE: 3-27-98	SHEET NO. CF
---	-----------------	---------------	--------------



RECORD DRAWING

SHOWN PICTORALLY MAY NOT BE TO SCALE

THESE AS-BUILT OR RECORD DRAWINGS HAVE BEEN PREPARED, IN PART, ON THE BASIS OF INFORMATION, OBSERVATION, AND MEASUREMENT. THE ENGINEER WILL NOT BE RESPONSIBLE FOR ANY ERRORS OR OMISSIONS WHICH HAVE BEEN INCORPORATED INTO THIS DOCUMENT AS A RESULT OF INFORMATION BY OTHERS.

C51