




Apple Tree Plantings - 1:100

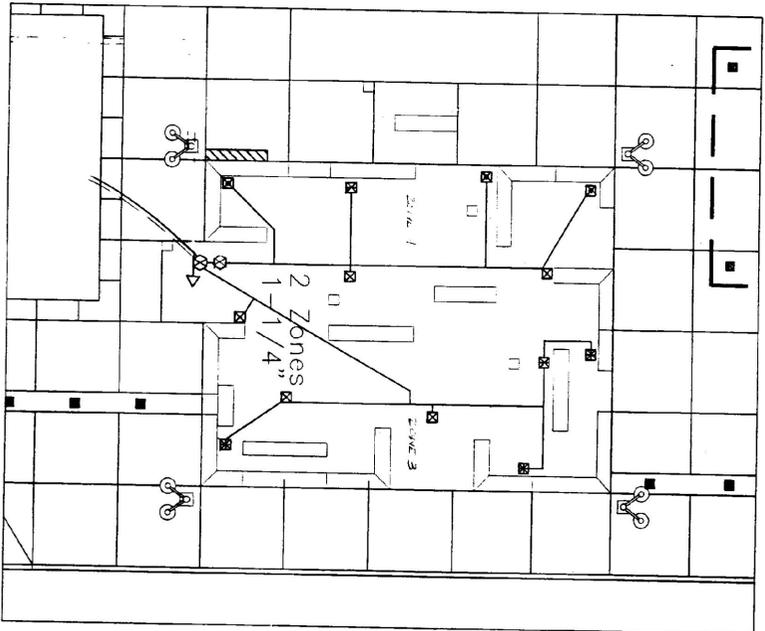

West Planter - 1:100

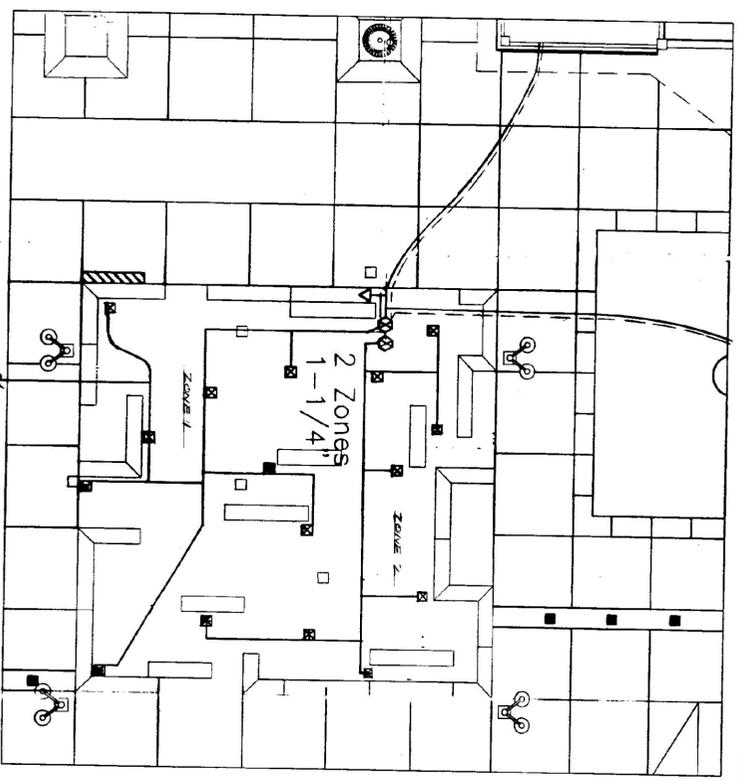

East Planter - 1:100

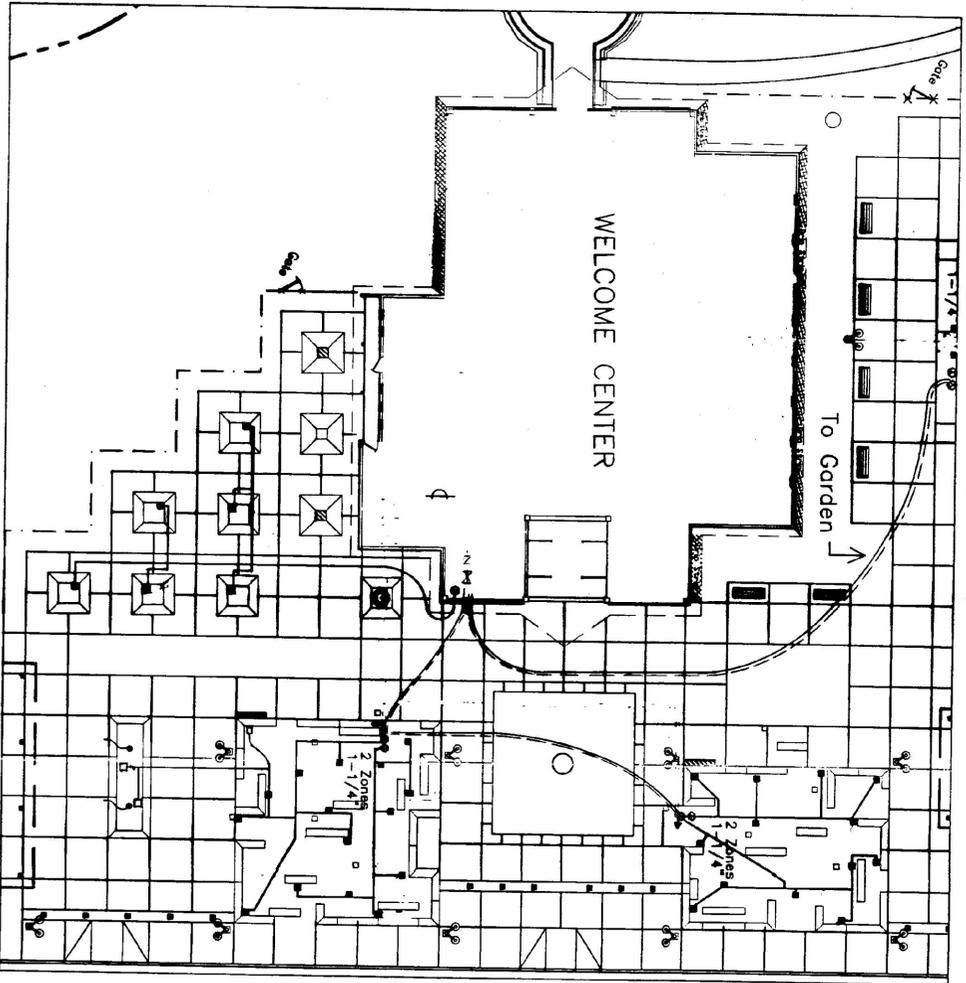

Overview Map - 1:200


- △ Remote Hose Bibb GULLA COUNTERS
- ⊗ Valve - Electric
- Pipe w/ 7/8" 9" ZEPHYRUS CHECKED VALVE
- ⊥ Backflow Prevention
- ⊗ Manual Shut-off Valve
- w/ Air Valve
- ↓ TORO VISION II 9 Station Controller (To Be Located)

- Sprinkler Key
- Apple Trees - TORO 570 6"
- East & West Planters - TORO 570 12"
- Garden - TORO 570 12" 1/4"

- Valves / Backflow
- Electric - TORO #280-06-14 FLO-PRO
- Manual - HARVARD SCH 80 PVC
- Backflow - TORO PVB (Pressure Vacuum-Breaker) #220-14

- 570 Sprinkler Nozzel Key
- ⊗ 10' Full
- ⊗ 10' Quarter
- ⊗ Adjustable Arc
- ⊗ 180'
- ⊗ Side Strip

- Pipe Key
- Pressurized Mains - SCH-40 PVC 1", 1-1/4"
- Non Pressurized Zone - 100 PSI POLY - 1"

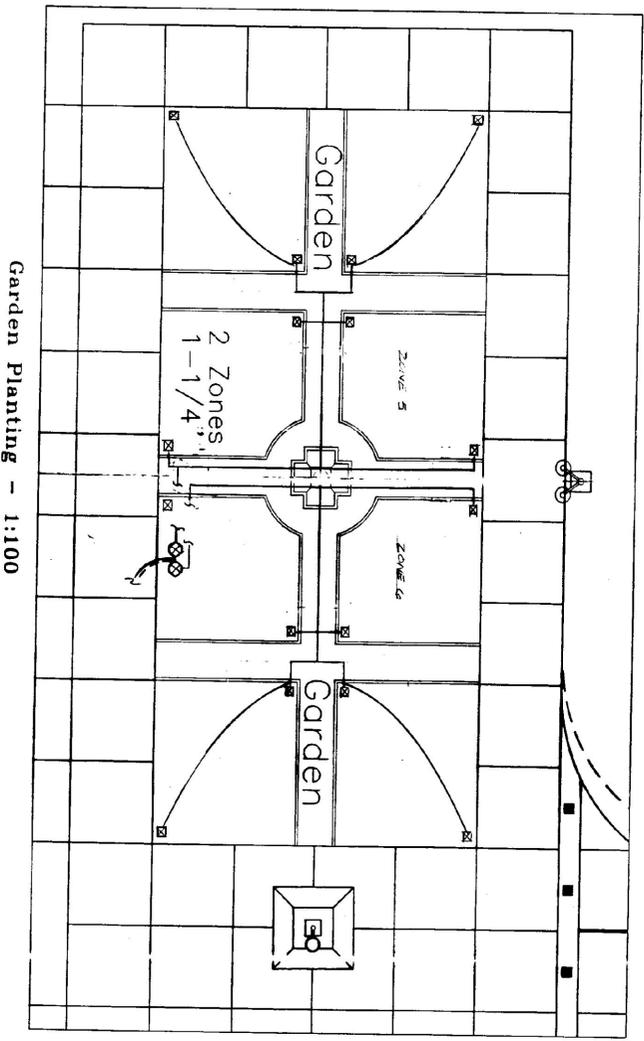

Garden Planting - 1:100

AS BUILT DIMS (NETS): IRRIGATION PIPING & SPRINKLERS LOCATIONS AND DIMENSIONS (UNDIMENSIONED) BASED ON AS BUILT OR PERMISSION PROVIDED BY MEMBERS EMPLOYERS. DIMENSIONS ARE BY VISUAL ESTIMATION.



**Metric** RECORD DRAWING

NO.	DATE	REVISIONS	DRWN CHKD
<p><b>TIMOTHY D. SMITH &amp; ASSOCIATES, PC ARCHITECTS</b>          OLD RAILROAD STATION          802-442-8184          NORTH BENNINGTON, VERMONT 05257          FAX 802-442-5241</p> <p><b>WRIGHT ENGINEERING, LTD.</b>          120 MERRIMAN ST. - P.O. BOX 178          802-738-2511          VERMONT 05401</p> <p><b>ROBT W. HALL</b>          CONSULTING ENGINEERS, INC.          440 BELLOU STREET EXTENSION, STE. 2          440 BELLOU STREET          MASSACHUSETTS 01001-0002          TEL 781-552-5285</p> <p><b>T.J. BOYLE AND ASSOCIATES</b>          LANDSCAPE ARCHITECTS          301 COLLEGE STREET          BURLINGTON, VERMONT 05401          802-488-9288          FAX 802-1502</p>			
<p>PROJECT NO. IM 091-1 (30)          SOUTHEAST VERMONT WELCOME CENTER          FINAL DRAWINGS</p>			
DSGN BY:	DRWN BY:	CHKD BY:	CHKD BY:
	PEB	TJB	PEB
<p>STATE OF VERMONT          AGENCY OF TRANSPORTATION          SOUTHEAST VERMONT WELCOME CENTER          GUILFORD, VERMONT</p>			
DATE:	1/16/98	SHEET NO.	112