


FINISH SCHEDULE - WELCOME CENTER

NO.	NAME	FLOOR	BASE	CEILING	WALLS			REMARKS
					NORTH	EAST	SOUTH	
001	MECH ROOM	100	CONCRETE	CONCRETE	CONCRETE	CONCRETE	CONCRETE	1 - HALL ENCLOSURE
002	DRINK SPACE	100	FL. BK. MASON	CONCRETE	CONCRETE	CONCRETE	CONCRETE	
101	MAIN HALL	100	WOOD PANELING	CONCRETE	CONCRETE	CONCRETE	CONCRETE	PAINT CEILING WALLS
102	LOBBY	100	BRICK PANELING	CONCRETE	CONCRETE	CONCRETE	CONCRETE	PAINT CEILING WALLS
103	RECEPTION	100	BRICK PANELING	CONCRETE	CONCRETE	CONCRETE	CONCRETE	PAINT CEILING WALLS
104	RECEPTION	100	BRICK PANELING	CONCRETE	CONCRETE	CONCRETE	CONCRETE	PAINT CEILING WALLS
105	RECEPTION	100	BRICK PANELING	CONCRETE	CONCRETE	CONCRETE	CONCRETE	PAINT CEILING WALLS
106	H.C. RESTROOM	100	CONCRETE	CONCRETE	CONCRETE	CONCRETE	CONCRETE	PAINT CEILING WALLS
107	H.C. RESTROOM	100	CONCRETE	CONCRETE	CONCRETE	CONCRETE	CONCRETE	PAINT CEILING WALLS
108	STORAGE SPACE	100	CONCRETE	CONCRETE	CONCRETE	CONCRETE	CONCRETE	PAINT CEILING WALLS
109	STORAGE SPACE	100	CONCRETE	CONCRETE	CONCRETE	CONCRETE	CONCRETE	PAINT CEILING WALLS
110	STORAGE SPACE	100	CONCRETE	CONCRETE	CONCRETE	CONCRETE	CONCRETE	PAINT CEILING WALLS
111	HALL	100	CONCRETE	CONCRETE	CONCRETE	CONCRETE	CONCRETE	PAINT CEILING WALLS
112	HALL	100	CONCRETE	CONCRETE	CONCRETE	CONCRETE	CONCRETE	PAINT CEILING WALLS
113	OFFICE	100	CONCRETE	CONCRETE	CONCRETE	CONCRETE	CONCRETE	PAINT CEILING WALLS
114	WOMEN'S REST	100	CONCRETE	CONCRETE	CONCRETE	CONCRETE	CONCRETE	PAINT CEILING WALLS
115	WOMEN'S REST	100	CONCRETE	CONCRETE	CONCRETE	CONCRETE	CONCRETE	PAINT CEILING WALLS
116	MEN'S REST	100	CONCRETE	CONCRETE	CONCRETE	CONCRETE	CONCRETE	PAINT CEILING WALLS
117	MEN'S REST	100	CONCRETE	CONCRETE	CONCRETE	CONCRETE	CONCRETE	PAINT CEILING WALLS
118	STORAGE SPACE	100	CONCRETE	CONCRETE	CONCRETE	CONCRETE	CONCRETE	PAINT CEILING WALLS
201	OFFICE	200	CONCRETE	CONCRETE	CONCRETE	CONCRETE	CONCRETE	PAINT CEILING WALLS
202	OFFICE	200	CONCRETE	CONCRETE	CONCRETE	CONCRETE	CONCRETE	PAINT CEILING WALLS
203	OFFICE	200	CONCRETE	CONCRETE	CONCRETE	CONCRETE	CONCRETE	PAINT CEILING WALLS
204	OFFICE	200	CONCRETE	CONCRETE	CONCRETE	CONCRETE	CONCRETE	PAINT CEILING WALLS
205	OFFICE	200	CONCRETE	CONCRETE	CONCRETE	CONCRETE	CONCRETE	PAINT CEILING WALLS
206	OFFICE	200	CONCRETE	CONCRETE	CONCRETE	CONCRETE	CONCRETE	PAINT CEILING WALLS

LOADING SCHEDULE - WELCOME CENTER

FLOOR	L.L. (psf)	D.L. (psf)	T.L. (psf)
FIRST FLOOR	100	15	115
LOBBY	50	15	65
ROOF	50	15	65

WIND LOADS: 20 15 35

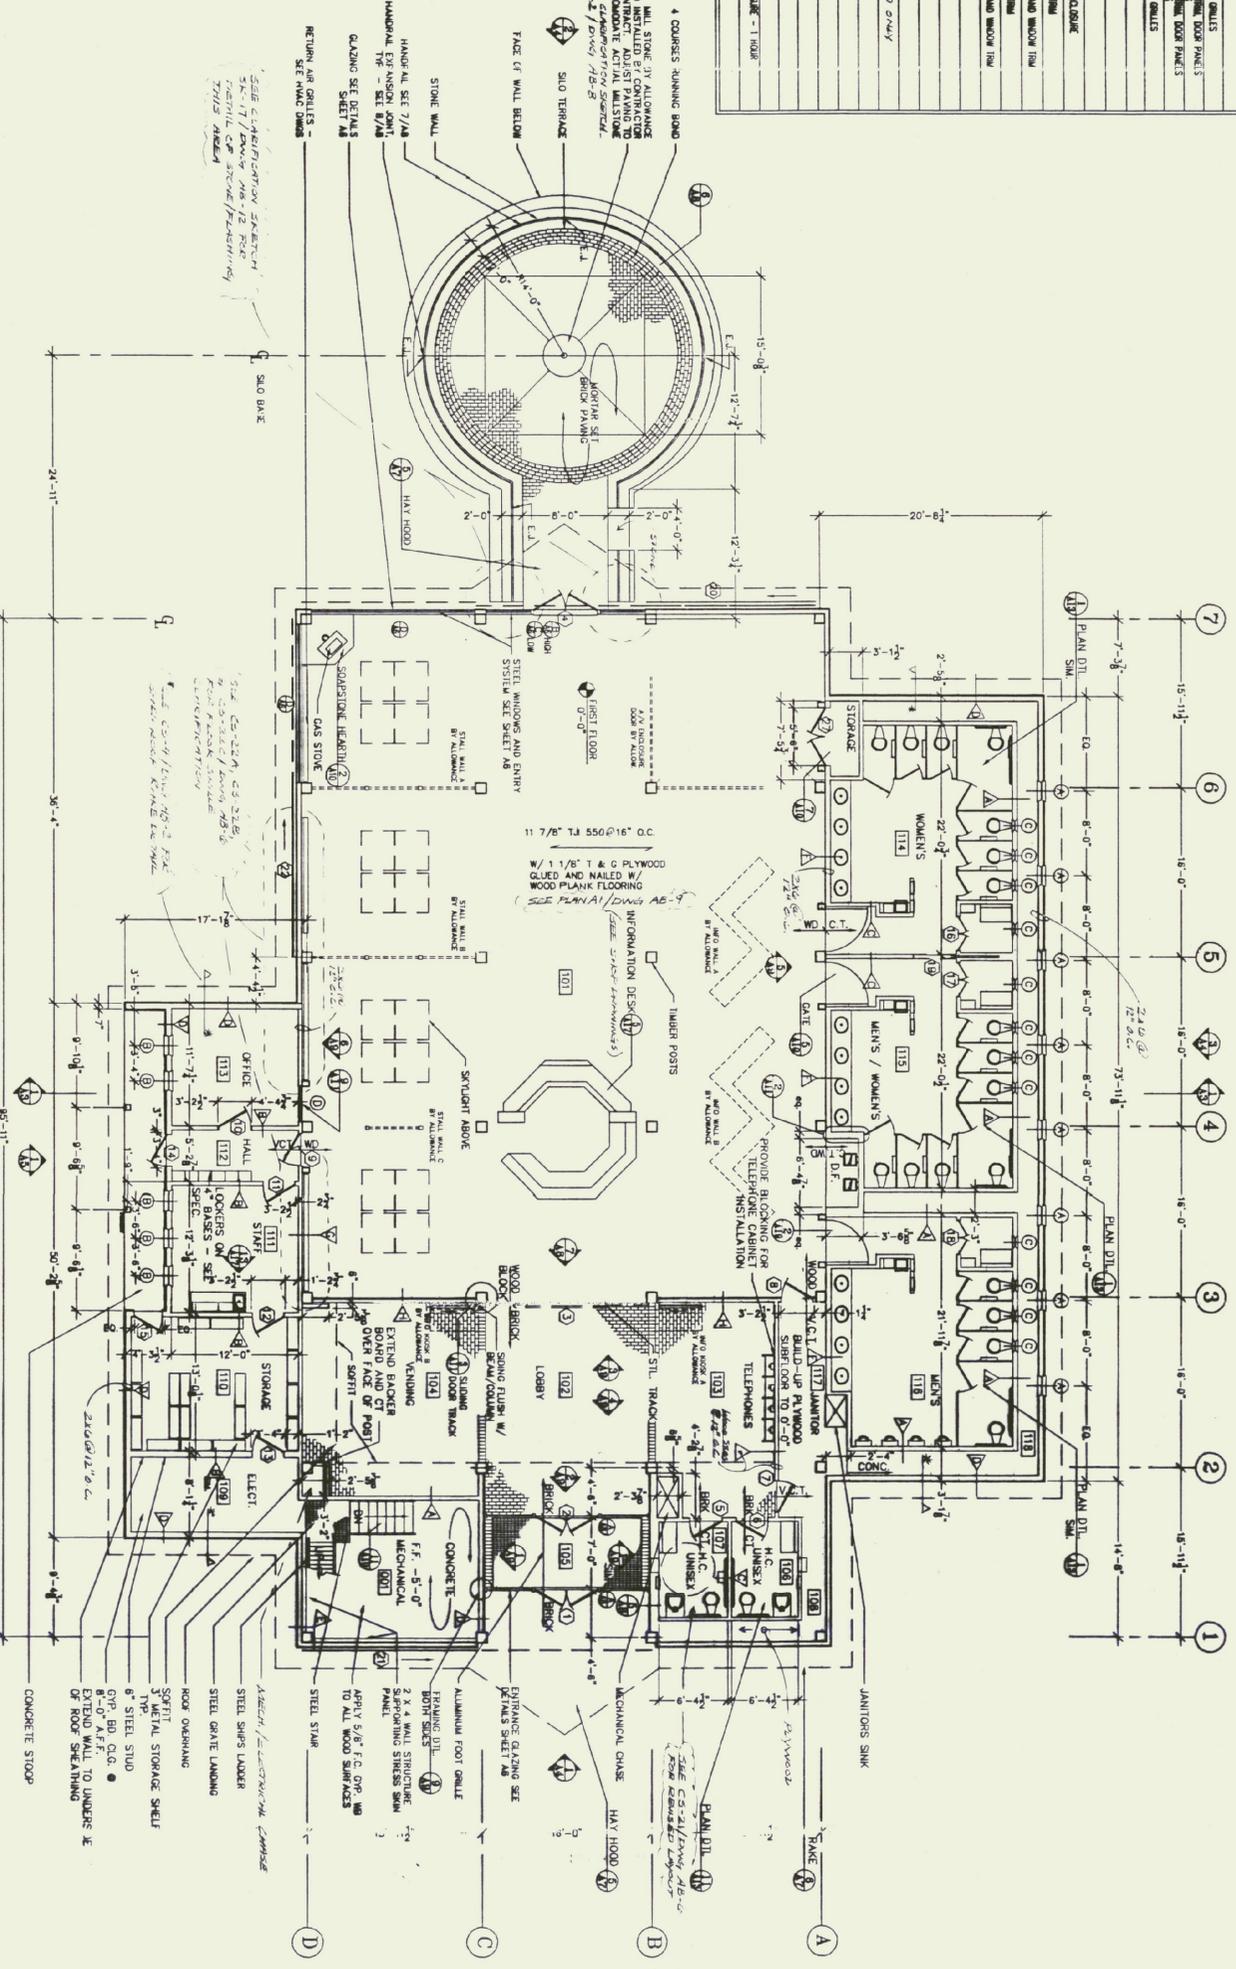

- GENERAL NOTES:**
- The following codes shall apply:
 - A. The BOCA Basic Building Code, 1987 as adopted and adopted by the State of Vermont
 - B. NFPA 101 Life Safety Code, 1994 as adopted and adopted by the State of Vermont
 - C. Code of Standard Practice for Steel Buildings and Steel Decking
 - D. AISC Specification for the design, Fabrication and Erection of Structural Steel for Buildings in case of conflict, the most stringent requirements shall apply.
 - Field measurements shall be taken at the site by the contractor to verify and supplement all dimensions and additions effected by existing work or new work that has already been installed. Any discrepancies from the information shown on plans shall be reported to and coordinated with the architect.
 - Before commencement of any work and/or fabrication, the contractor shall submit to the architect for his approval concrete mix designs for each type of concrete to be used, mill reports for steel and shop drawings for all trades.
 - The contractor shall adequately brace, shore and support the structure during the entire construction period.
 - Dimensions shown on plans, except where otherwise provided, refer to face of framing members or surface of stress-skin panels.

1 WELCOME CENTER PLAN
1/8" = 1'-0"

RECORD DRAWING

FINISH FLOOR 126.42M = 0'-0"

SEE PARTITION DETAILS SHEET A11

NO.	DATE	REVISIONS	DRWN	CHKD

TIMOTHY D. SMITH & ASSOCIATES, PC ARCHITECTS
 OLD RAILROAD STATION
 802-442-8184

ROBT W. HALL
 CONSULTING ENGINEERS, INC.
 125 WASHINGTON ST. - 2ND FL. BOX 178
 802-776-8811

T.J. BOYLE AND ASSOCIATES
 LANDSCAPE ARCHITECTS
 80 W. WASHINGTON ST. - 2ND FL. BOX 178
 802-462-8888

PROJECT NO. JM 091-1 (30)
 SOUTHEAST VERMONT WELCOME CENTER
 GUILFORD, VERMONT

STATE OF VERMONT
 AGENCY OF ADMINISTRATION
 DEPARTMENT OF
 BUILDINGS & GENERAL SERVICES

DESIGN BY: _____
 DRAWN BY: _____
 CHECKED BY: _____

DATE: 1-16-98

SHEET NO. _____ OF _____ SHEETS

A1