




1 REAR DOOR BEAM SECTION
1" = 1'-0"

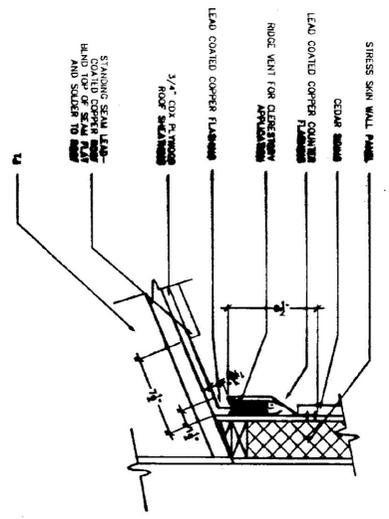


2 CHRISTSTORY VENT SECTION
1 1/2" = 1'-0"

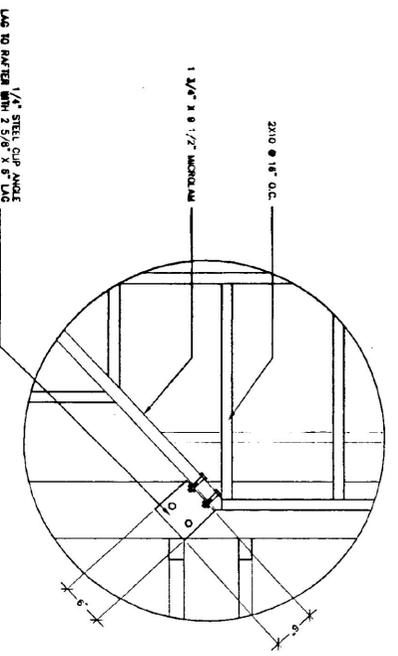


3 STEEL PLATE DETAIL 1
1" = 1'-0"

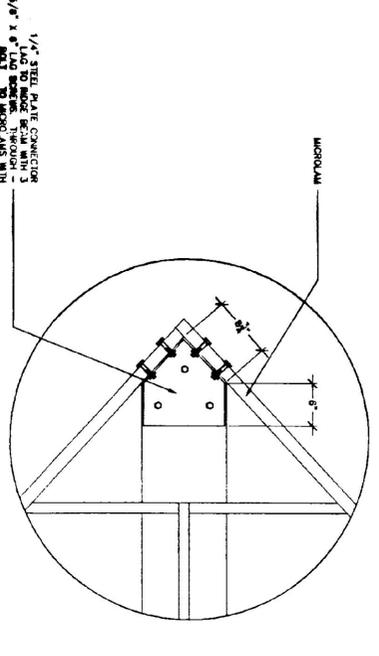


4 STEEL PLATE DETAIL 2
1" = 1'-0"

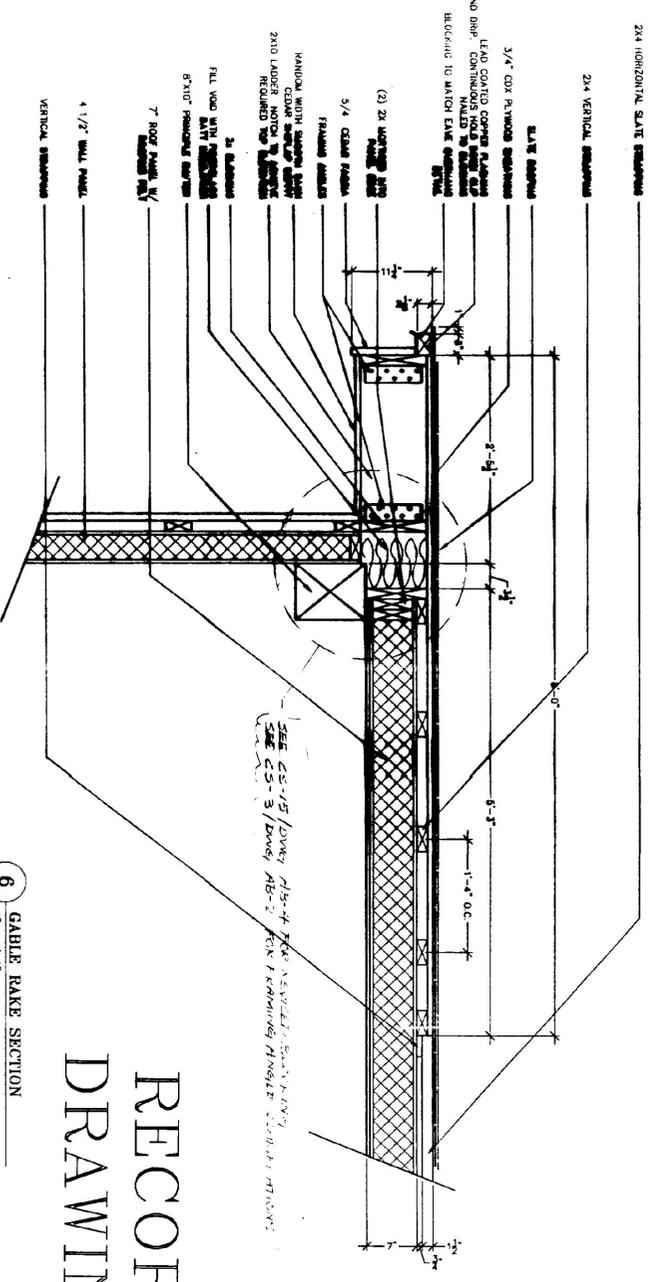


6 GABLE RAKE SECTION
1" = 1'-0"

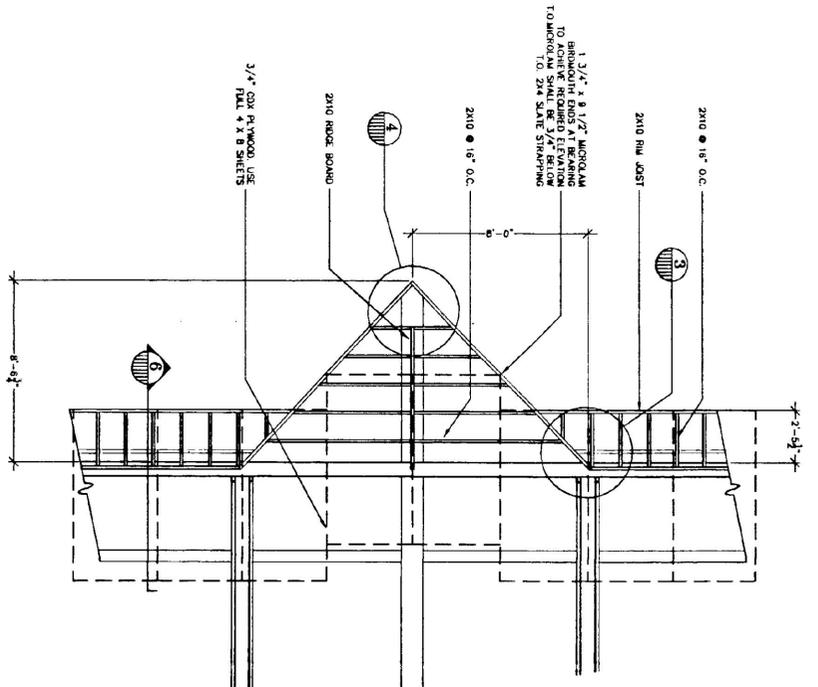


5 HAY HOOD FRAMING PLAN
1/2" = 1'-0"

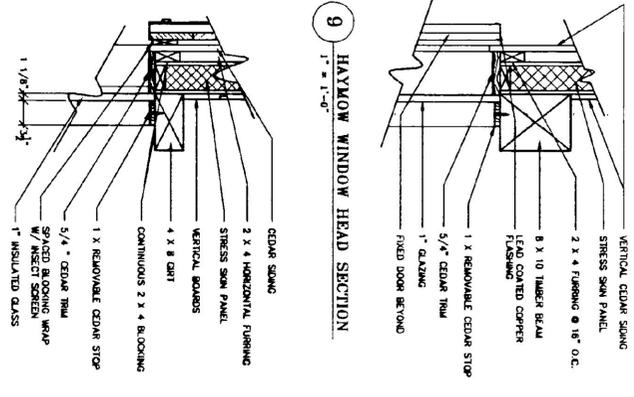


9 HAYNOW WINDOW HEAD SECTION
1" = 1'-0"

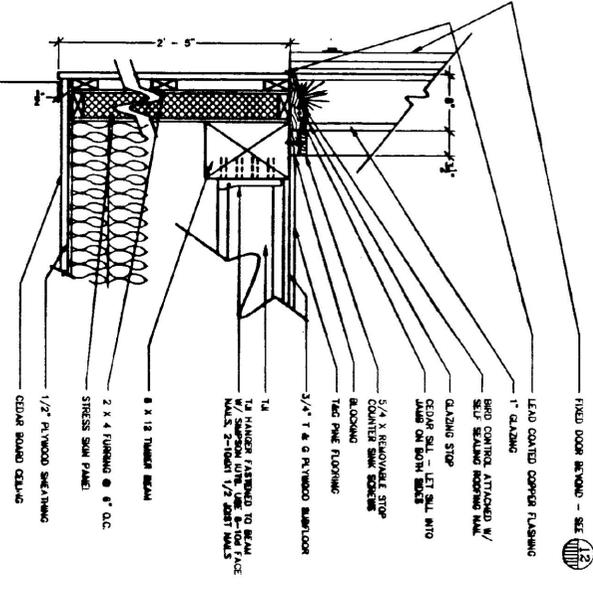


8 HAYNOW WINDOW SILL SECTION
1" = 1'-0"

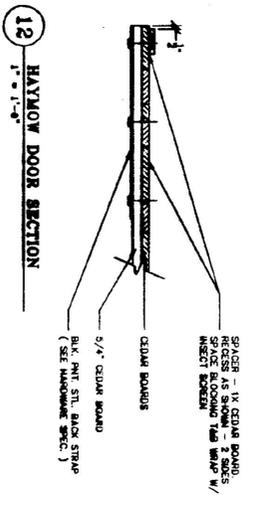

12 HAYNOW DOOR SECTION
1" = 1'-0"

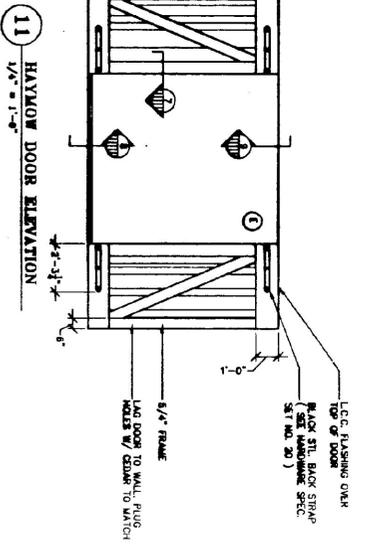

11 HAYNOW DOOR ELEVATION
1/2" = 1'-0"

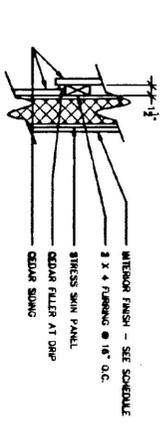

10 SIDING LAP SECTION
1" = 1'-0"

RECORD DRAWING

NO.	DATE	REVISIONS	DRAWN	CHKD
<p>TIMOTHY D. SMITH & ASSOCIATES, PC ARCHITECTS OLD RAILROAD STATION 802-448-8184</p> <p>ROBT W. HALL CONSULTING ENGINEERS, INC. NORTH BENNINGTON VERMONT 05267 FAX 802-442-5241</p> <p>WRIGHT ENGINEERING, LTD. CIVIL ENGINEERS 24 N. W. 130 BIRMINGHAM, VERMONT 05401 802-778-9811</p> <p>T.J. BOYLE AND ASSOCIATES LANDSCAPE ARCHITECTS BURLINGTON, VERMONT 05401 802-688-3055</p>				
<p>PROJECT NO. M 091-1 (30) SOUTHEAST VERMONT WELCOME CENTER GUILDFORD, VERMONT</p>				
<p>STATE OF VERMONT AGENCY OF ADMINISTRATION DEPARTMENT OF BUILDINGS & GENERAL SERVICES</p>				
<p>SHEET TITLE: WELCOME CENTER BLDG EXTERIOR DETAILS</p>				
<p>DESIGN BY: DRAWN BY: CHECK BY:</p>			<p>DATE: 1-16-98</p>	
<p>DATE: 1-16-98</p>			<p>SHEET NO. _____ OF _____ SHEETS</p>	

A7