





1 LAMINAR DETAIL  
1/8" = 1'-0"

2 SOAPSTONE HEARTH DETAIL  
1/8" = 1'-0"

3 DUCT BOX DETAIL  
1/4" = 1'-0"

4 STORAGE BOX DETAIL  
1/4" = 1'-0"

5 BATHROOM GATE DETAIL  
1/8" = 1'-0"

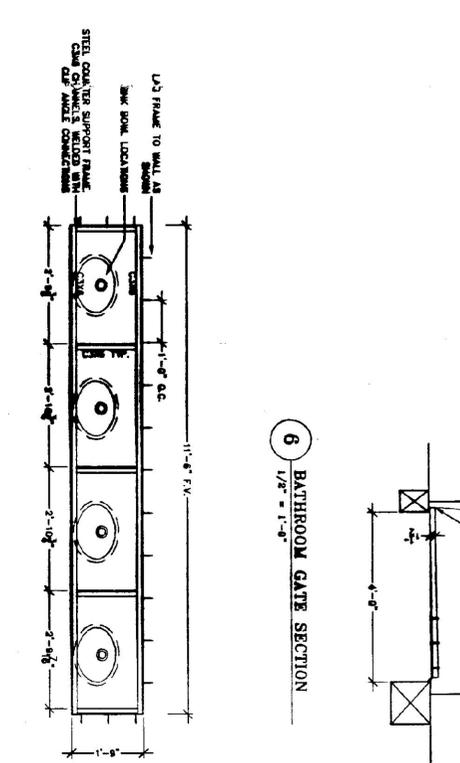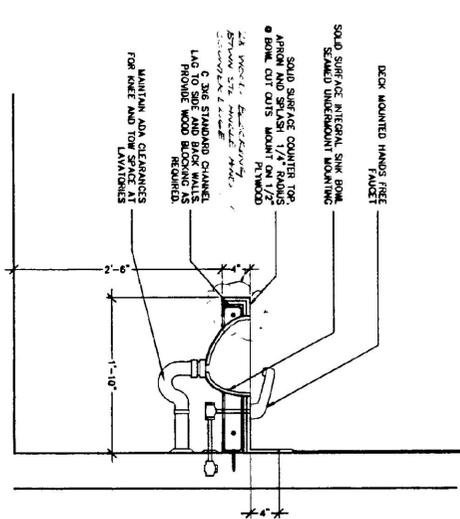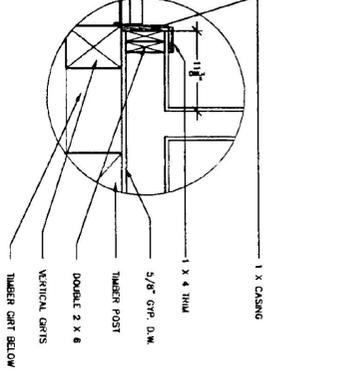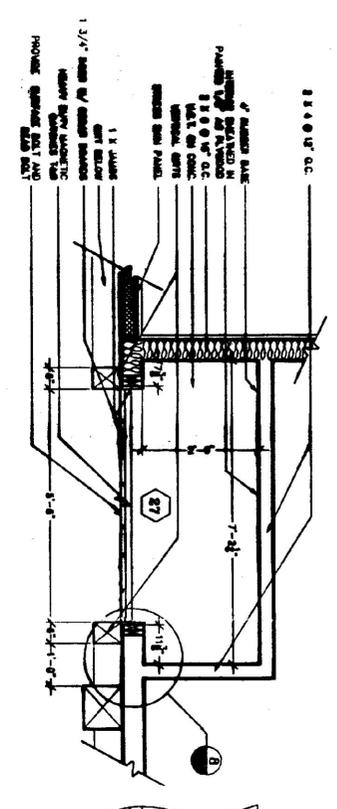






6 BATHROOM GATE SECTION  
1/2" = 1'-0"

7 CONCEALED CLOSET DETAIL  
1/2" = 1'-0"

8 CONCEALED CLOSET DETAIL  
1" = 1'-0"

9 RESTROOM SINK SECTION  
1" = 1'-0"

10 RESTROOM SINK FRAME PLAN  
1/8" = 1'-0"

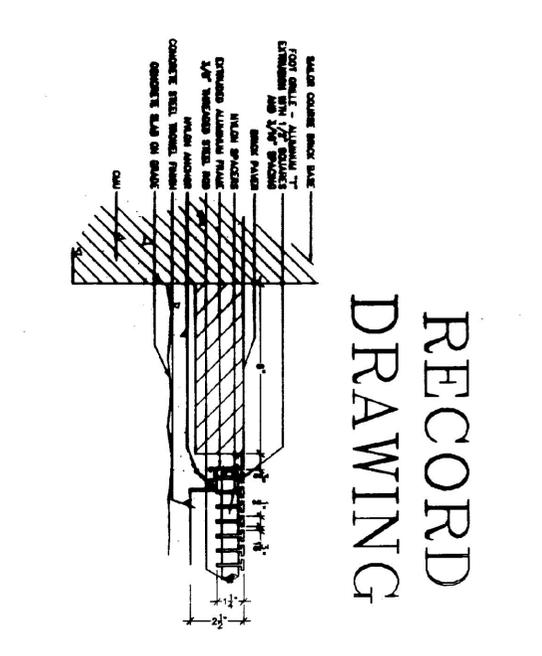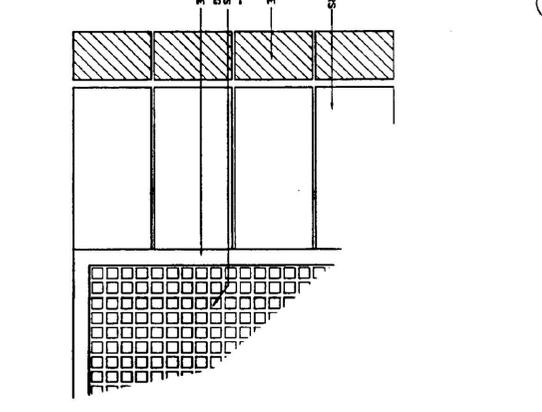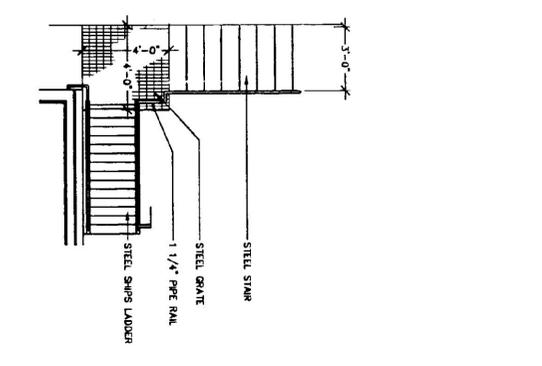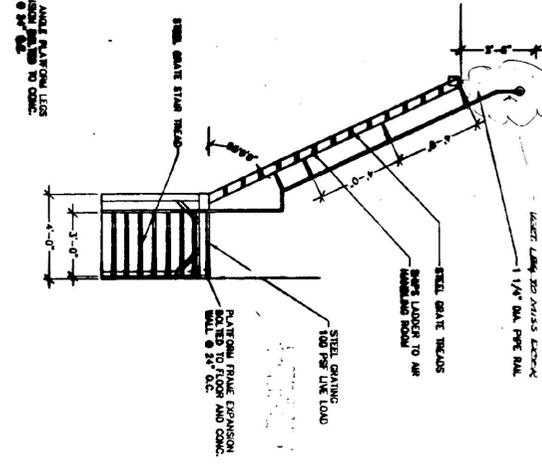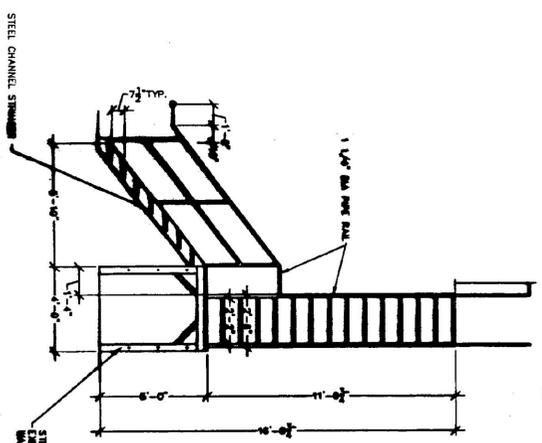

11 STEEL STAIR SECTION  
1/4" = 1'-0"

12 SHIPS LADDER SECTION  
1/4" = 1'-0"

13 STEEL STAIR AND SHIPS LADDER PLAN  
1/4" = 1'-0"

14 FOOT GRILLE DETAIL AT ENTRY  
5" = 1'-0"

15 FOOT GRILLE SECTION  
5" = 1'-0"

# RECORD DRAWING

NO. DATE		REVISIONS		DRAWN CHKD		<b>WYOMT ENGINEERING, LTD.</b> CIVIL ENGINEERS 180 BROADWAY, SUITE 200 BOSTON, MASSACHUSETTS 02109 TEL: 617-552-8811		<b>BOBT W. HALL</b> CONSULTING ENGINEERS, INC. 645 WASHINGTON STREET, SUITE 8 BURLINGTON, VERMONT 05401 TEL: 802-249-2889		<b>T.J. BOYLE AND ASSOCIATES</b> LANDSCAPE ARCHITECTS 301 COLLEGE STREET BURLINGTON, VERMONT 05401 TEL: 802-808-3000	
NO. DATE		REVISIONS		DRAWN CHKD		<b>WYOMT ENGINEERING, LTD.</b> CIVIL ENGINEERS 180 BROADWAY, SUITE 200 BOSTON, MASSACHUSETTS 02109 TEL: 617-552-8811		<b>BOBT W. HALL</b> CONSULTING ENGINEERS, INC. 645 WASHINGTON STREET, SUITE 8 BURLINGTON, VERMONT 05401 TEL: 802-249-2889		<b>T.J. BOYLE AND ASSOCIATES</b> LANDSCAPE ARCHITECTS 301 COLLEGE STREET BURLINGTON, VERMONT 05401 TEL: 802-808-3000	

**TIMOTHY D. SMITH & ASSOCIATES, PC ARCHITECTS**  
 OLD BARR ROAD STATION  
 802-442-8184  
 NORTH BENNINGTON, VERMONT 05267  
 FAX 802-442-5241

PROJECT NO. IM 091-1 (30)  
 SOUTHEAST VERMONT WELCOME CENTER  
 GUILFORD, VERMONT

SHEET TITLE: WELCOME CENTER BUILDING INTERIOR DETAILS

STATE OF VERMONT  
 AGENCY OF ADMINISTRATION  
 DEPARTMENT OF  
 BUILDINGS & GENERAL SERVICES

**A10**