
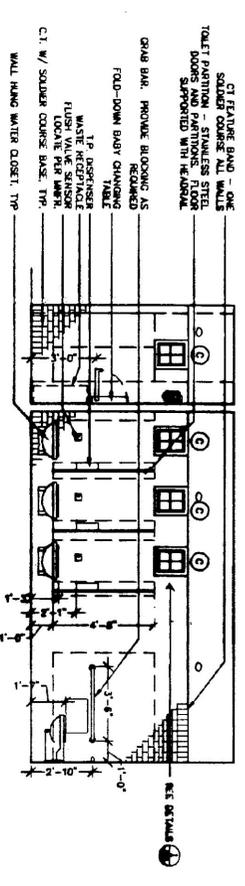
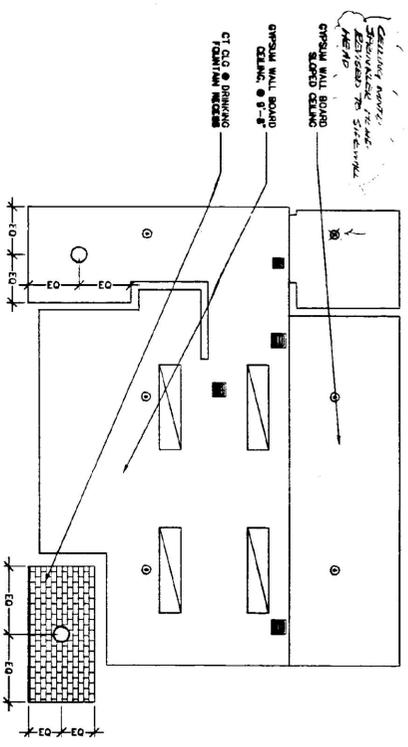






# RECORD DRAWING

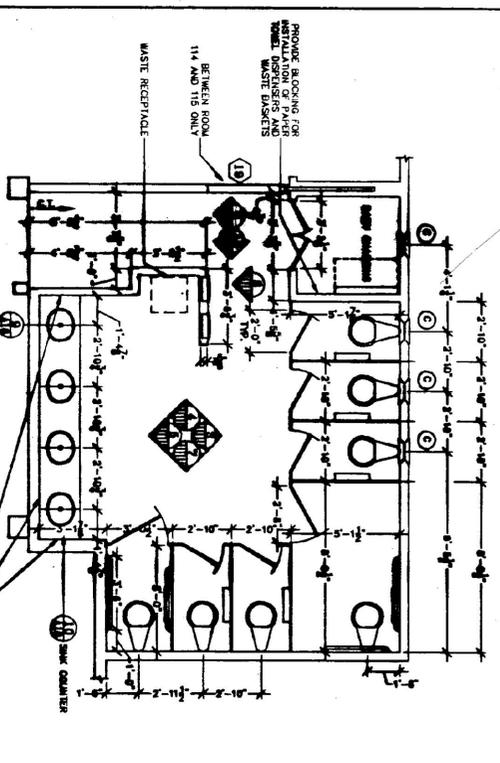

1 TYPICAL RESTROOM PLAN  
1/4" = 1'-0"  
SEE SPECIFICATIONS DIVISION NO. 5 FOR DIMENSIONAL CONVENTIONS

2 RESTROOM REFLECTED CEILING PLAN  
1/4" = 1'-0"

3 RESTROOM INTERIOR ELEVATION FACING WEST  
1/4" = 1'-0"

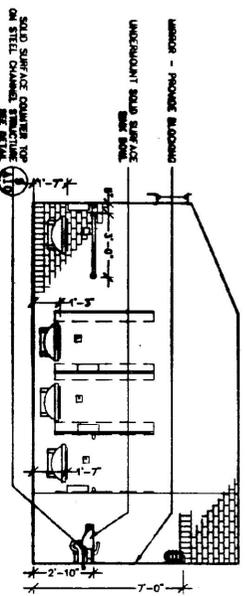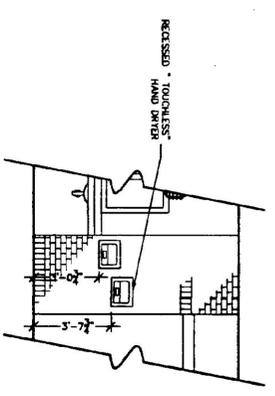
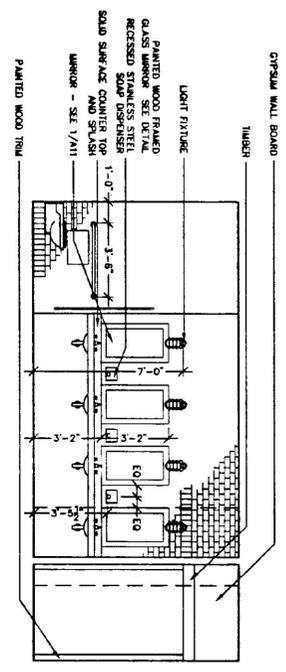
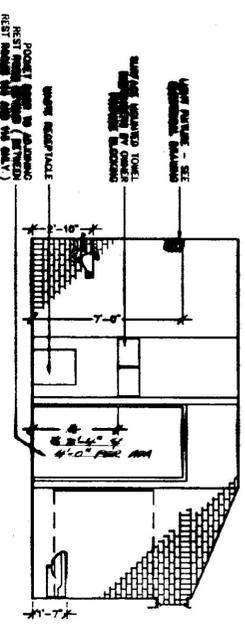


4 RESTROOM INTERIOR ELEVATION FACING SOUTH  
1/4" = 1'-0"

5 RESTROOM INTERIOR ELEVATION FACING EAST  
1/4" = 1'-0"

6 RESTROOM INTERIOR ELEVATION FACING EAST  
1/4" = 1'-0"







7 RESTROOM INTERIOR ELEVATION FACING NORTH  
1/4" = 1'-0"

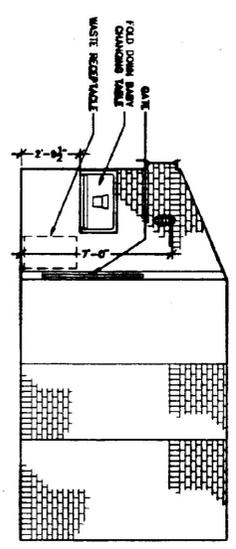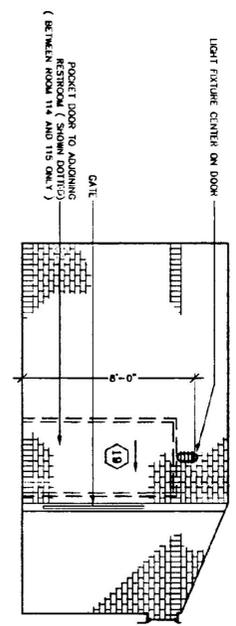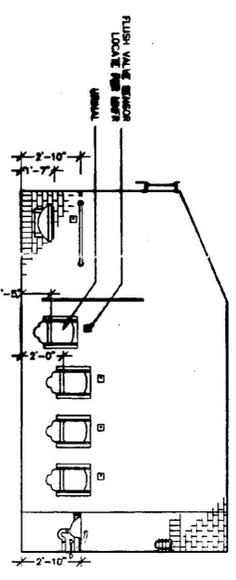

8 RESTROOM INTERIOR ELEVATION FACING NORTH  
1/4" = 1'-0"

9 RESTROOM INTERIOR ELEVATION FACING SOUTH  
1/4" = 1'-0"

10 RESTROOM INTERIOR ELEVATION FACING NORTH  
1/4" = 1'-0"

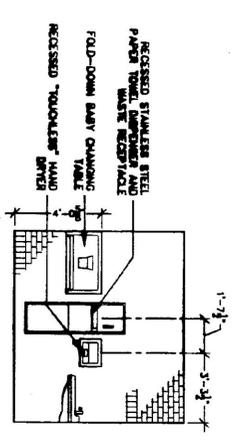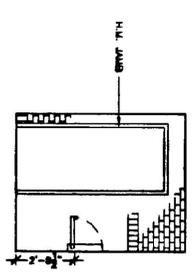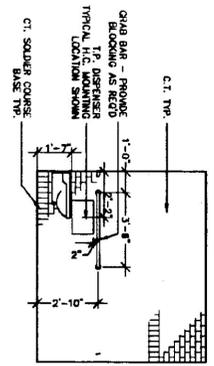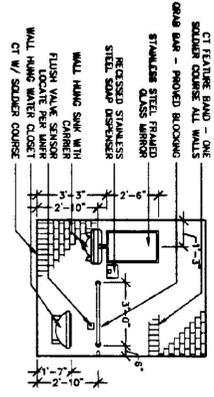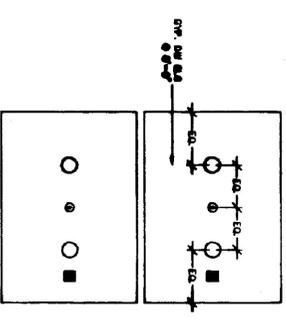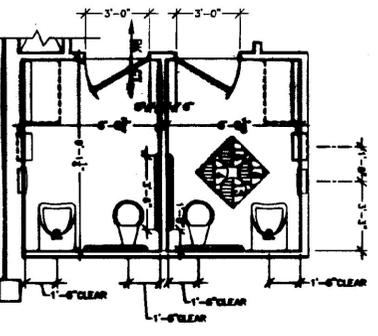

12 HC RESTROOM REFLECTED CEILING PLAN  
1/4" = 1'-0"

13 HC RESTROOM INT. ELEV. FACING NORTH  
1/4" = 1'-0"

14 HC RESTROOM INT. ELEV. FACING EAST  
1/4" = 1'-0"

15 HC RESTROOM INT. ELEV. FACING SOUTH  
1/4" = 1'-0"

16 HC RESTROOM INT. ELEV. FACING WEST  
1/4" = 1'-0"

11 HC RESTROOM PLAN  
1/4" = 1'-0"

NO.	DATE	REVISIONS	DESIGN	CHKD	DATE	SHEET NO.	OF SHEETS
<p>PROJECT NO. IM 091-1 (30) SOUTHEAST VERMONT WELCOME CENTER GUILFORD, VERMONT</p>			<p>STATE OF VERMONT AGENCY OF ADMINISTRATION DEPARTMENT OF BUILDINGS &amp; GENERAL SERVICES</p>		<p>A13</p>		
<p>TIMOTHY D. SMITH &amp; ASSOCIATES, PC ARCHITECTS OLD BARRROAD STATION 802-448-8184 NORTH BENNINGTON, VERMONT 05257 FAX 802-442-5241</p>			<p>BOB W. HALL CONSULTING ENGINEERS, INC. LANDSCAPE ARCHITECTS 201 CANTON STREET BURLINGTON, VT 05401 802-863-3035</p>		<p>WILSON ENGINEERING, LTD. CIVIL ENGINEERS 185 BROADWAY BURLINGTON, VT 05401 802-863-3035</p>		
<p>REGISTERED ARCHITECT STATE OF VERMONT NO. 1000</p>			<p>REGISTERED ARCHITECT STATE OF VERMONT NO. 1000</p>		<p>REGISTERED ARCHITECT STATE OF VERMONT NO. 1000</p>		
