


1 WALL SECTION
1" = 1'-0"

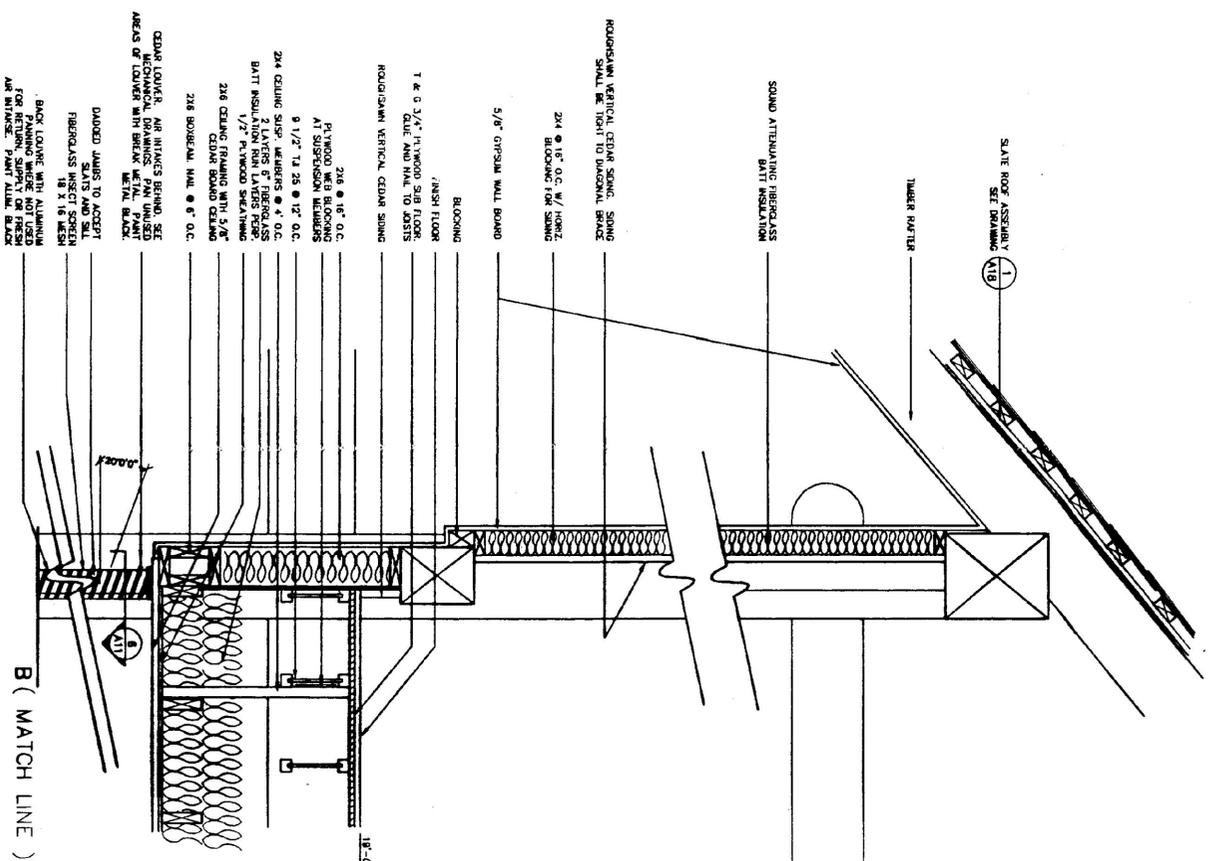

RECORD DRAWING

FINISH FLOOR 0'-0" = 126.42 METERS

NO.	DATE	REVISIONS	DRWN	CHKD
<p>TIMOTHY D. SMITH & ASSOCIATES, PC ARCHITECTS OLD RAILROAD STATION 802-442-8184</p> <p>BOB W. HALL CONSULTING ENGINEERS, INC. 440 JEFFERSON STREET BURLINGTON, VERMONT 05401 802-249-2000</p> <p>T.J. BOYLE AND ASSOCIATES LANDSCAPE ARCHITECTS 301 COLLIER STREET BURLINGTON, VERMONT 05401 802-249-2000</p>				
<p>PROJECT NO. JM 091-1 (30) SOUTHEAST VERMONT WELCOME CENTER GUILFORD, VERMONT PRELIMINARY DRAWINGS</p>				
<p>SHEET TITLE: WELCOME CENTER BUILDING WALL SECTION</p>				
<p>DESIGN BY:</p>		<p>STATE OF VERMONT AGENCY OF ADMINISTRATION DEPARTMENT OF BUILDINGS & GENERAL SERVICES</p>		
<p>DATE: 1-18-98</p>		<p>SHEET NO. _____ OF _____ SHEETS</p>		
<h1>A20</h1>				