


NO.	DATE	REVISIONS	DRAWN CHECKD

TIMOTHY D. SMITH & ASSOCIATES, PC ARCHITECTS
 OLD BALLPOD STATION
 802-442-8184

VIKROY ENGINEERING, LTD.
 CIVIL ENGINEERS
 100 BROADWAY SUITE 200 - P.O. BOX 179
 BURLINGTON, VERMONT 05401-0179
 802-749-8811

BOBT W. HALL
 CONSULTING ENGINEERS, INC.
 440 WILSON STREET SUITE 200
 BURLINGTON, VERMONT 05401-0200
 802-749-8888

T.J. BOYLE AND ASSOCIATES
 LANDSCAPE ARCHITECTS
 301 COLLIER STREET
 BURLINGTON, VERMONT 05401-0301
 802-580-5800

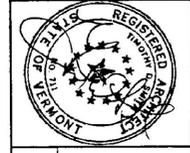

PROJECT NO. IM 091-1 (30)
 SOUTHEAST VERMONT WELCOME CENTER
 GUILFORD, VERMONT

SHEET TITLE: WELCOME CENTER BUILDING WALL SECTION

DSGN BY:
 DWN BY:
 CKD BY:

STATE OF VERMONT
 AGENCY OF ADMINISTRATION
 DEPARTMENT OF
 BUILDINGS & GENERAL SERVICES

DATE: 1-16-98


SHEET NO. _____ OF _____ SHEETS

A21

**RECORD
 DRAWING**

FINISH FLOOR 0'-0" = 126.42 METERS

1 WALL SECTION
 1" = 1'-0"

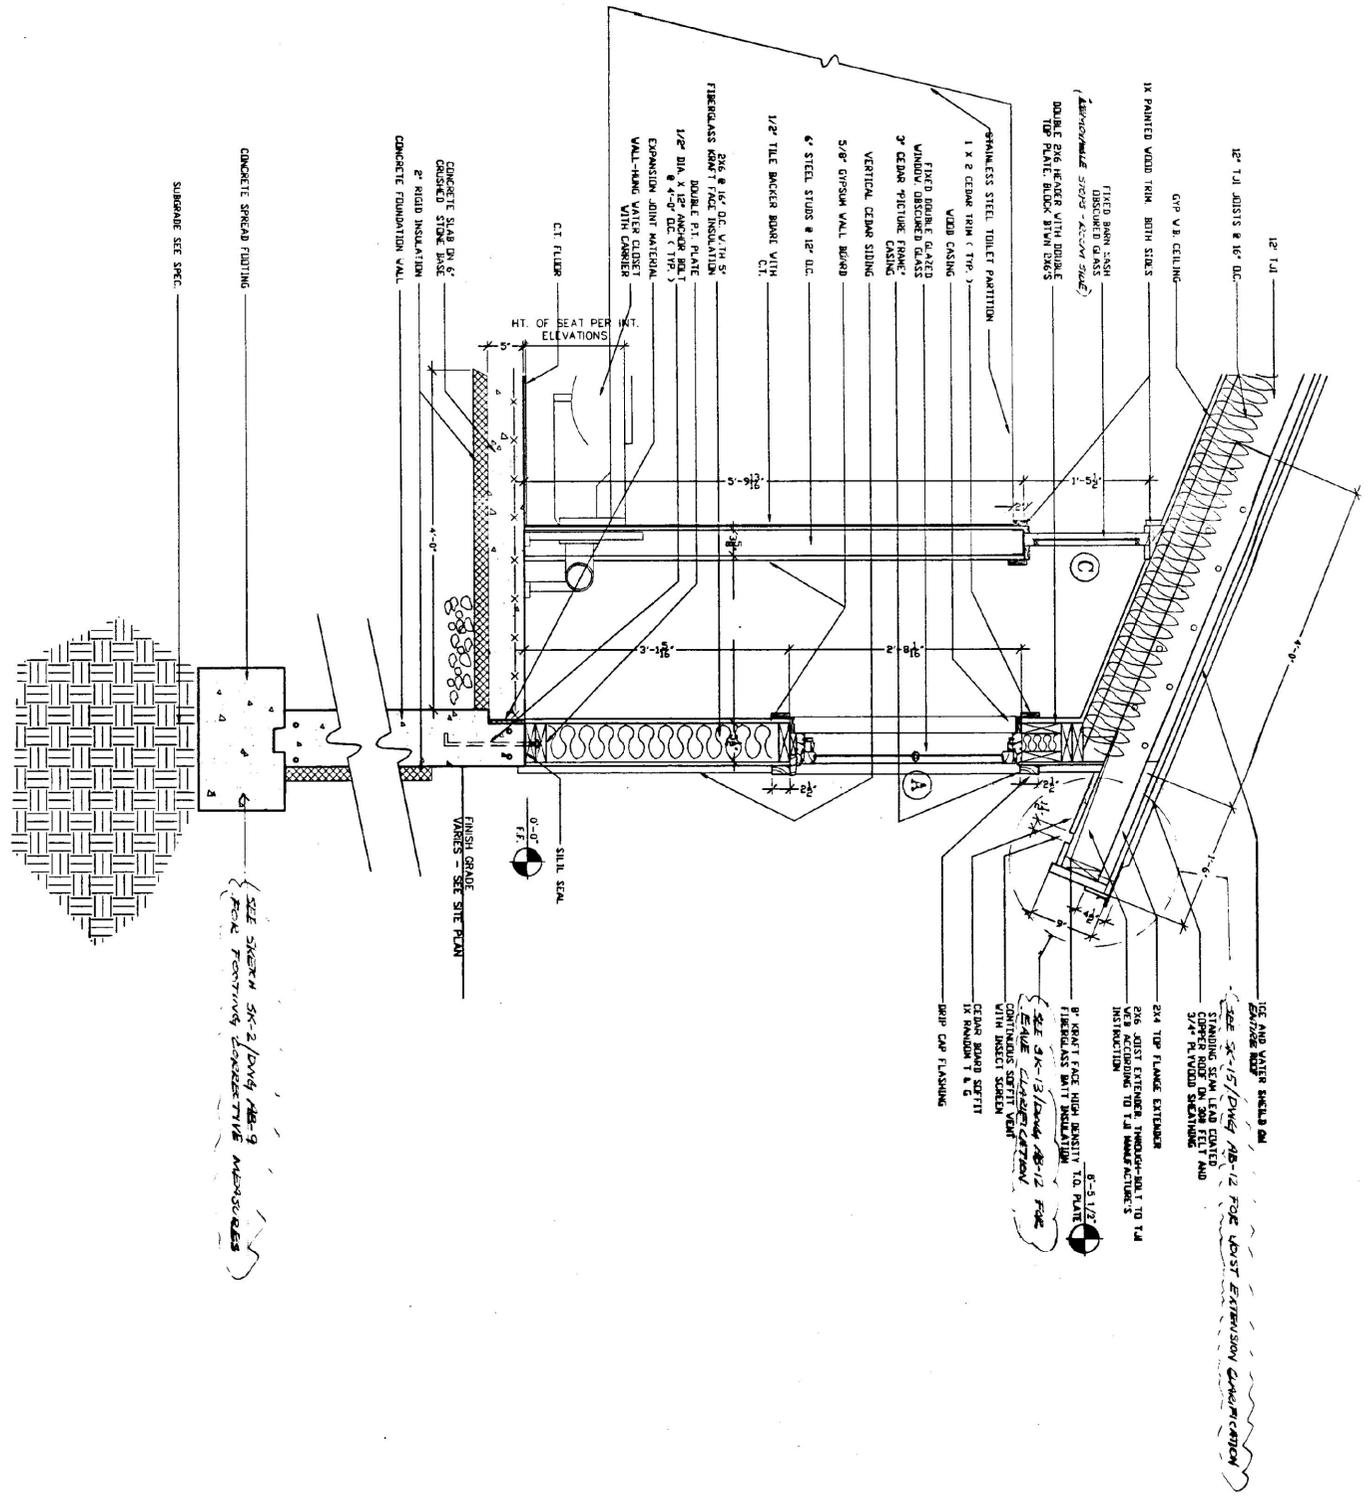

SEE SHEET SK-2/DWG MB-9 FOR FINISHING CONCRETE MEMORIES