


1 WELCOME CENTER BUILDING FRAME PLAN
1/8" = 1'-0"




4 BLOCKING FOR LIGHT SUSPENSION
1" = 1'-0"

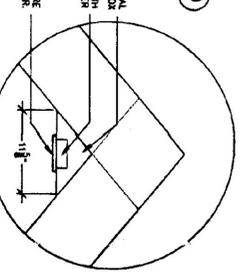

SEE ELECTRICAL DRAWINGS FOR LOCATIONS OF LIGHT FRAMES

COLUMN SCHEDULE - WELCOME CENTER					
NO.	SIZE	B.P. TYPE	B.P. ELEV.	TOP ELEV./LENGTH	TYPE
A-1	11"x11"	PLATE	-1'-3 3/4"	18'-0"	18'-0 3/4" STRAIGHT
A-2	12"x12"	PLATE	-1'-3 1/2"	18'-0"	18'-0 1/2" JOINED
A-3	12"x11"	PLATE	-1'-3 1/2"	18'-0"	18'-0 1/2" JOINED
A-4	12"x11"	PLATE	-1'-3 1/2"	18'-0"	18'-0 1/2" JOINED
A-5	12"x11"	PLATE	-1'-3 1/2"	18'-0"	18'-0 1/2" JOINED
A-6	12"x11"	PLATE	-1'-3 1/2"	18'-0"	18'-0 1/2" JOINED
A-7	11"x11"	PLATE	-1'-3 3/4"	18'-0"	18'-0 3/4" STRAIGHT
B-1	12"x12"	BOOT	-0'-0"	28'-0 3/4" 30'-3"	OAK, STRAIGHT
B-2	12"x12"	PLATE	-0'-11 1/2"	28'-0 3/4" 32'-2 1/4"	STRAIGHT
B-3	12"x12"	PLATE	-0'-11 1/2"	28'-0 3/4" 32'-2 1/4"	STRAIGHT
B-4	12"x12"	PLATE	-0'-11 1/2"	28'-0 3/4" 32'-2 1/4"	STRAIGHT
B-5	12"x12"	PLATE	-0'-11 1/2"	28'-0 3/4" 32'-2 1/4"	STRAIGHT
B-6	12"x12"	PLATE	-0'-11 1/2"	28'-0 3/4" 32'-2 1/4"	STRAIGHT
B-7	11"x12"	PLATE	-0'-0"	28'-0 3/4" 31'-2 1/2"	STRAIGHT
C-1	12"x12"	BOOT	-0'-0"	28'-0 3/4" 30'-3"	OAK, STRAIGHT
C-2	12"x12"	PLATE	-0'-11 1/2"	28'-0 3/4" 32'-2 1/4"	STRAIGHT
C-3	12"x12"	PLATE	-0'-11 1/2"	28'-0 3/4" 32'-2 1/4"	STRAIGHT
C-4	12"x12"	PLATE	-0'-11 1/2"	28'-0 3/4" 32'-2 1/4"	STRAIGHT
C-5	12"x12"	PLATE	-0'-11 1/2"	28'-0 3/4" 32'-2 1/4"	STRAIGHT
C-6	12"x12"	PLATE	-0'-11 1/2"	28'-0 3/4" 32'-2 1/4"	STRAIGHT
C-7	11"x12"	PLATE	-0'-0"	28'-0 3/4" 31'-2 1/2"	STRAIGHT
D-1	11"x11"	PLATE	-1'-3 3/4"	18'-0"	18'-0 3/4" STRAIGHT
D-2	12"x11"	PLATE	-1'-3 1/2"	18'-0"	18'-0 1/2" JOINED
D-3	12"x11"	PLATE	-1'-3 1/2"	18'-0"	18'-0 1/2" JOINED
D-4	12"x11"	PLATE	-1'-3 1/2"	18'-0"	18'-0 1/2" JOINED
D-5	12"x11"	PLATE	-1'-3 1/2"	18'-0"	18'-0 1/2" JOINED
D-6	12"x11"	PLATE	-1'-3 1/2"	18'-0"	18'-0 1/2" JOINED
D-8	11"x11"	PLATE	-1'-3 3/4"	18'-0"	18'-0 3/4" STRAIGHT

TIMBER FRAME CONTRACTOR SHALL CORE AND ROUT BEAMS FOR ELECTRICAL CONDUITS - SEE ELECTRICAL DRAWINGS

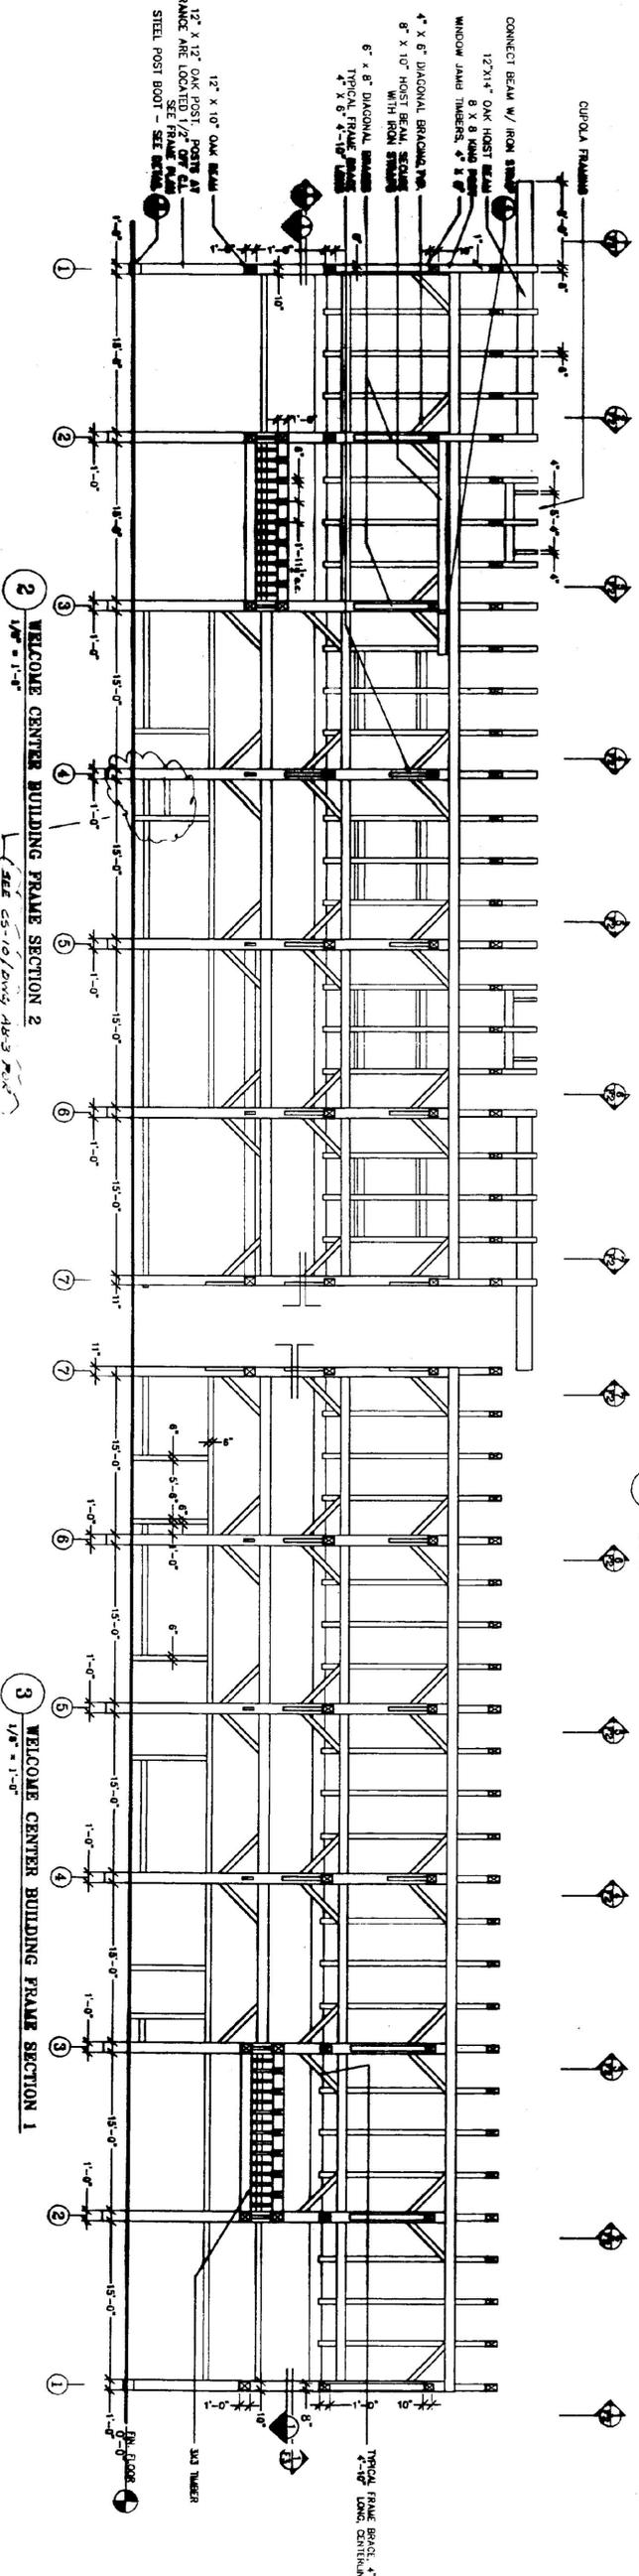

2 WELCOME CENTER BUILDING FRAME SECTION 2
1/8" = 1'-0"

3 WELCOME CENTER BUILDING FRAME SECTION 1
1/8" = 1'-0"

RECORD DRAWING

NO. DATE

DRWN CHKD

TIMOTHY D. SMITH & ASSOCIATES, PC ARCHITECTS

OLD RAILROAD STATION
802-448-8184

NORTH BENNINGTON, VERMONT 05257
FAX 802-442-5241

PROJECT NO. IM 091-1 (30)

SOUTHEAST VERMONT WELCOME CENTER
GUILFORD, VERMONT

STATE OF VERMONT
AGENCY OF ADMINISTRATION
DEPARTMENT OF
BUILDINGS & GENERAL SERVICES

DESIGN BY: _____

DRWN BY: _____

CHKD BY: _____

DATE: 1-16-98

SHEET NO. _____ OF _____ SHEETS

F1