




1 TIMBER FRAME REFLECTED FRAME PLAN
1/8" = 1'-0"

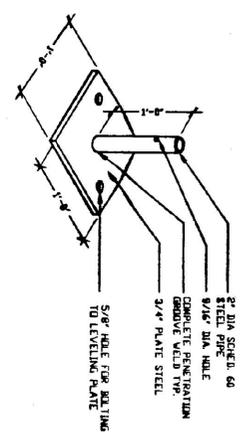

2 BASE PLATE
1" = 1'-0"

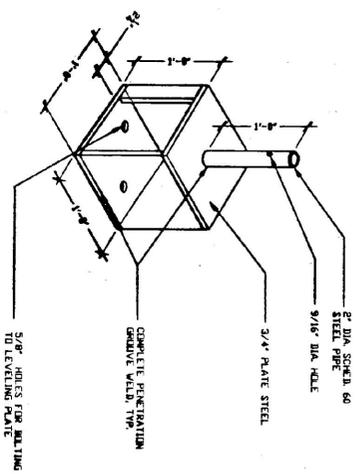

3 BASE BOOT
1" = 1'-0"

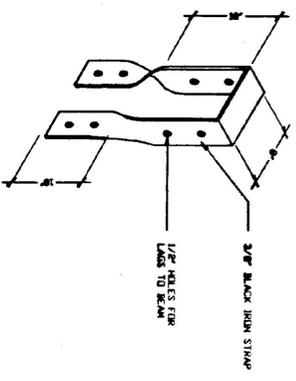

4 HOIST BEAM STRAP
1" = 1'-0"

RECORD DRAWING

NO.	DATE	REVISIONS	DRAWN CHECKED	<p>TIMOTHY D. SMITH & ASSOCIATES, PC ARCHITECTS OLD BAILEY ROAD STATION 802-443-8184</p> <p>BOYD V. HALL CONSULTING ENGINEERS, INC. 540 WASHINGTON STREET LANDSCAPE ARCHITECTS BURLINGTON, VT 05401 802-443-3005</p> <p>T.J. BOYLE AND ASSOCIATES LANDSCAPE ARCHITECTS 501 COLLEGE STREET BURLINGTON, VT 05401 802-443-1002</p>	<p>PROJECT NO. IM 091-1 (30) SOUTHEAST VERMONT WELCOME CENTER GUILDFORD, VERMONT</p>	<p>STATE OF VERMONT AGENCY OF ADMINISTRATION DEPARTMENT OF BUILDINGS & GENERAL SERVICES</p>
				<p>DESIGN BY:</p> <p>DRAWN BY:</p> <p>CHECKED BY:</p>	<p>DATE: 1-16-98</p> <p>SHEET NO. _____ OF _____ SHEETS</p>	<p>F3</p>