


**BENT 3**

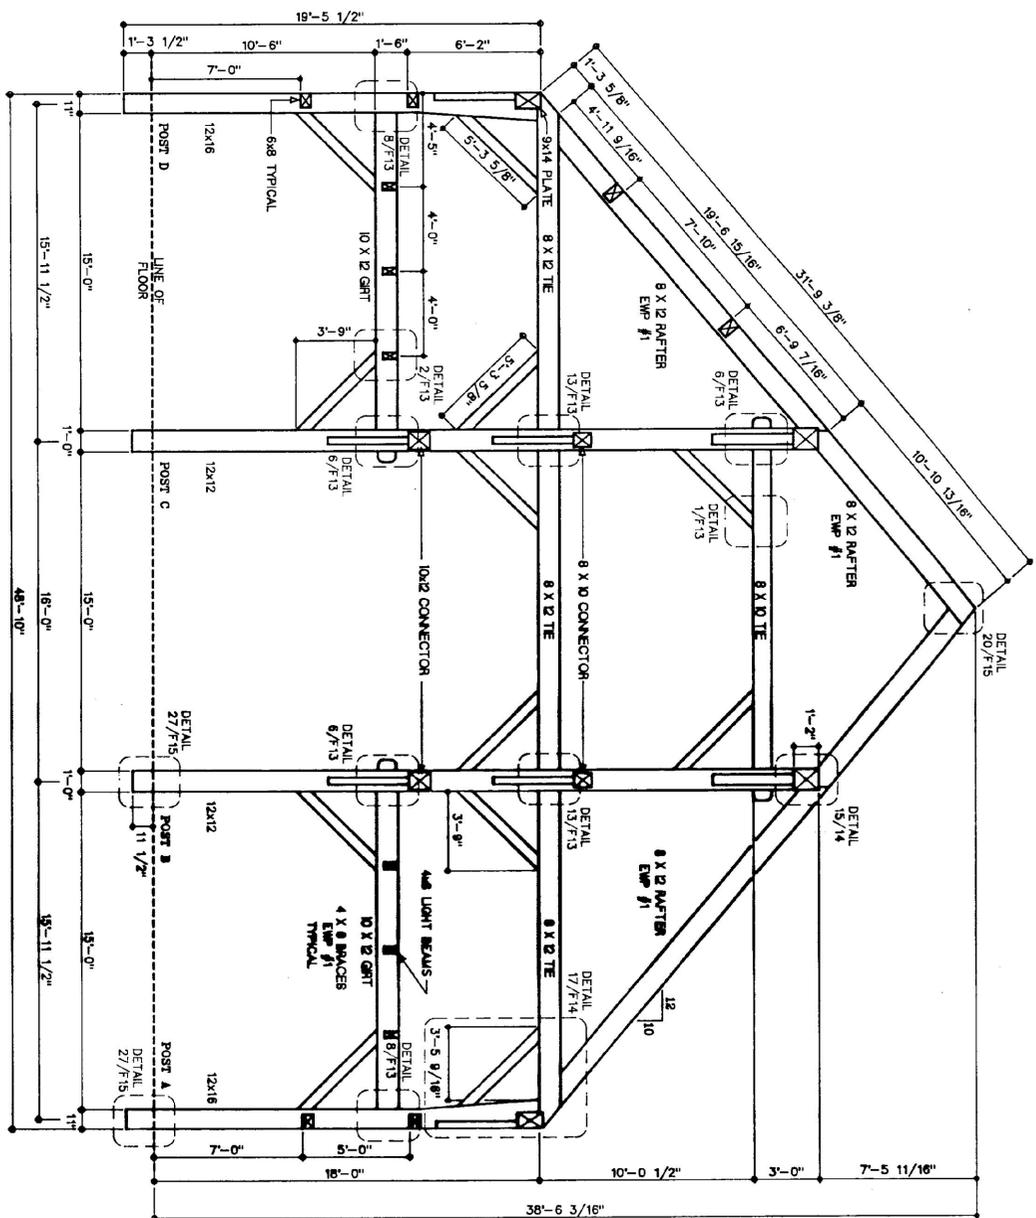

**BENT 4**

**RECORD  
DRAWING**

W.D. Smith  
8/15/08

Timothy D. Smith & Associates, P.C.  
212/118  
40

**NOTE: ALL TIMBER TO BE EASTERN  
WHITE PINE #2 & BETTER GRADED-  
WISE NOTED  
ALL PEGS TO BE 1" BIRCH**



DATE: 8/15/08	DRAWN: D.F.
SCALE: 1/4" = 1'-0"	CHECKED:
JOB NO.:	
SHEET	
<b>F-4</b>	
OF SHEETS	

**PROJECT: SOUTHEAST VERMONT  
WELCOME CENTER  
GUILFORD, VERMONT**

ARCH: TIMOTHY D. SMITH & ASSOCIATES  
ENG: DUFRESNE & HENRY  
G.C.: NEAGLEY & CHASE

SHOP DRAWINGS  
**BENTS 3 & 4**



REVISIONS	BY