


BENT 5

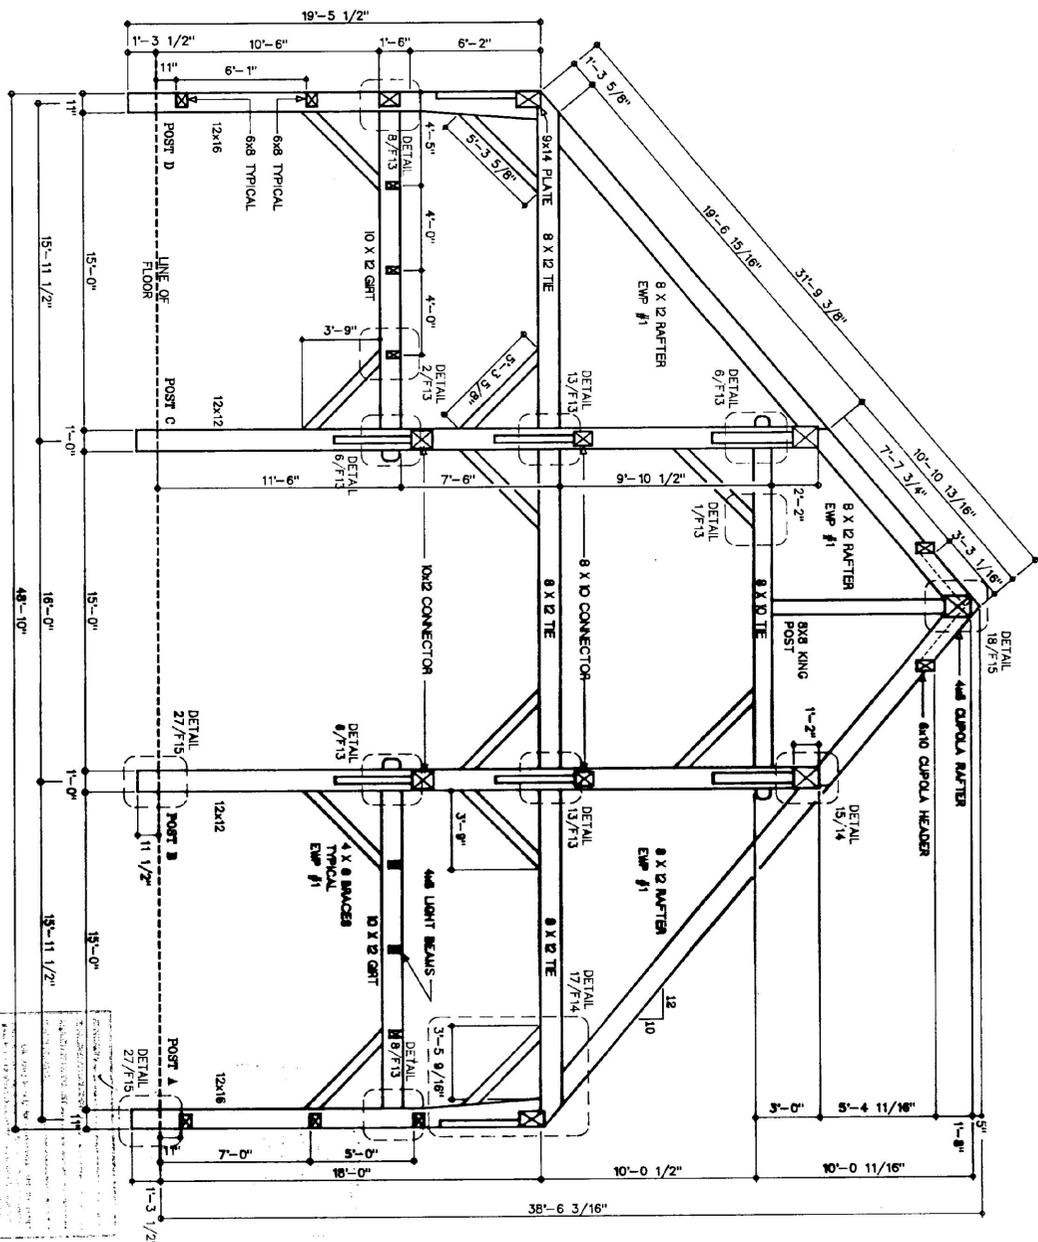

BENT 6

NOTE: ALL TIMBER TO BE EASTERN WHITE PINE #2 & BETTER GRADED FOR APPEARANCE UNLESS OTHERWISE NOTED
ALL PEGS TO BE 1" BIRCH

RECORD DRAWING

9/2/98

Timothy D. Smith & Associates, P.C.
100 North Main Street, Guilford, VT 05743
Tel: 802-241-1111
Fax: 802-241-1112

PROJECT: SOUTHEAST VERMONT WELCOME CENTER
GUILFORD, VERMONT

ARCH: TIMOTHY D. SMITH & ASSOCIATES
ENG: DUFRESNE & HENRY
G.C.: NEAGLEY & CHASE

SHOP DRAWINGS
BENTS 5 & 6



REVISIONS	BY

DRAWN: D.P.
CHECKED: [Signature]
DATE: 8/16/98
SCALE: 1/4" = 1'-0"
JOB NO.: [Blank]
SHEET: F-5
OF SHEETS: [Blank]