

| REVISIONS | BY |
|-----------|----|
|           |    |
|           |    |
|           |    |











SHOP DRAWINGS  
**JON LINDHART**  
 JOINT DETAILS

ARCH: TIMOTHY D. SMITH & ASSOCIATES  
 ENG: DUFRESNE & HENRY  
 G.C.: NEAGLEY & CHASE





PROJECT: **SOUTHEAST VERMONT WELCOME CENTER**  
 GUILFORD, VERMONT

DRAWN: D.P.  
 DATE: 8/15/98  
 SCALE: 1/2" = 1'-0"  
 JOB NO.: 123456

SHEET F-14 OF SHEETS

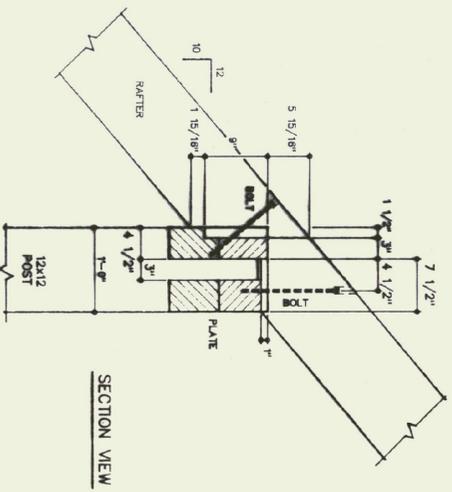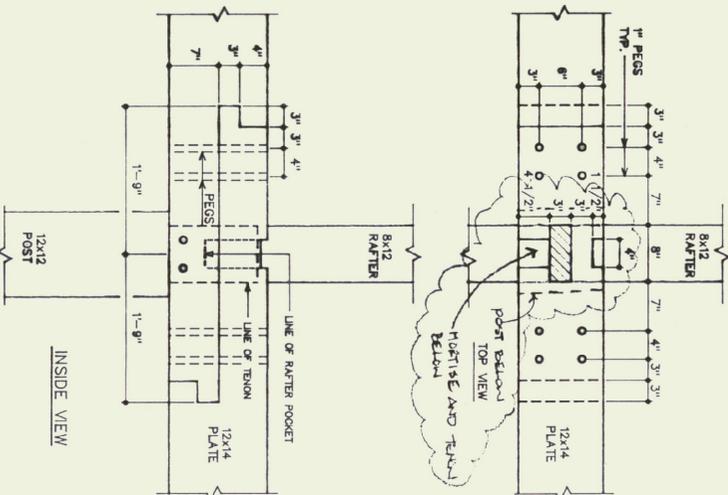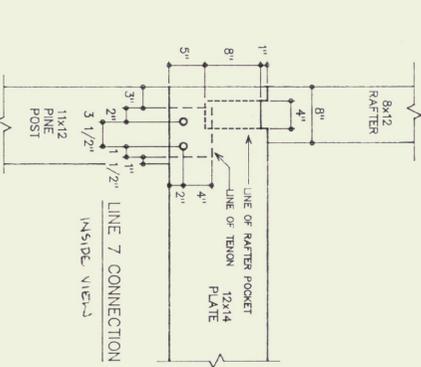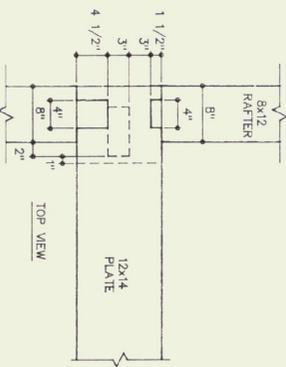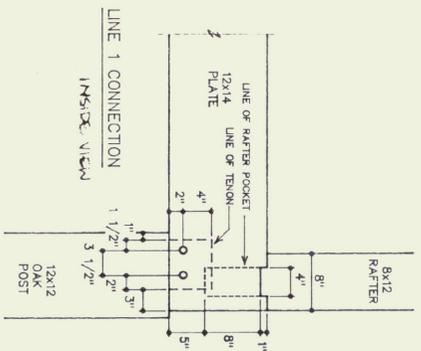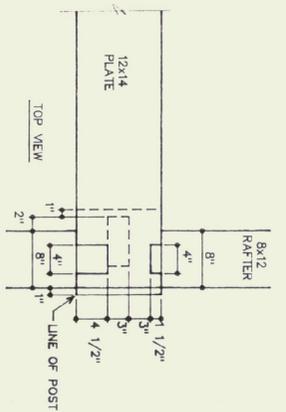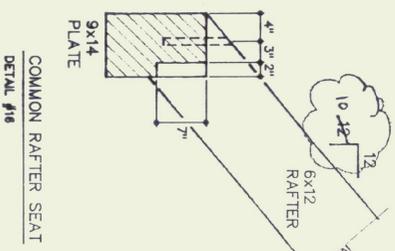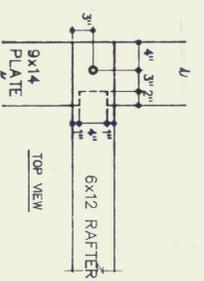

UPPER PLATE CONNECTIONS  
 DETAIL #15  
*SEE NOTES SHEETS F-10 & F-11*

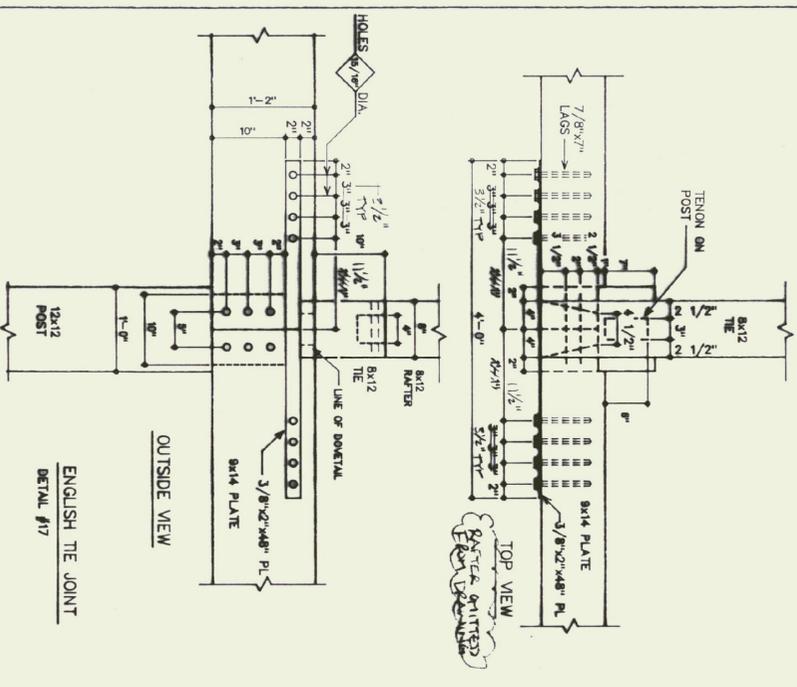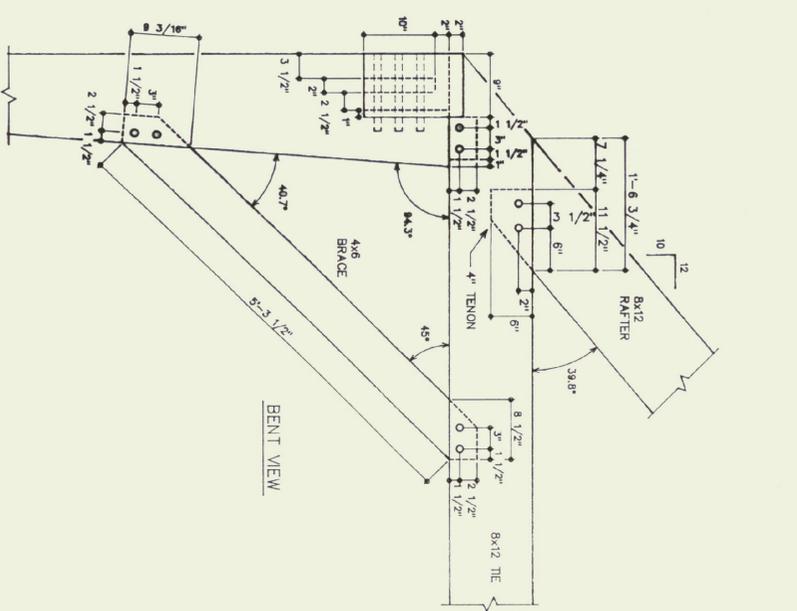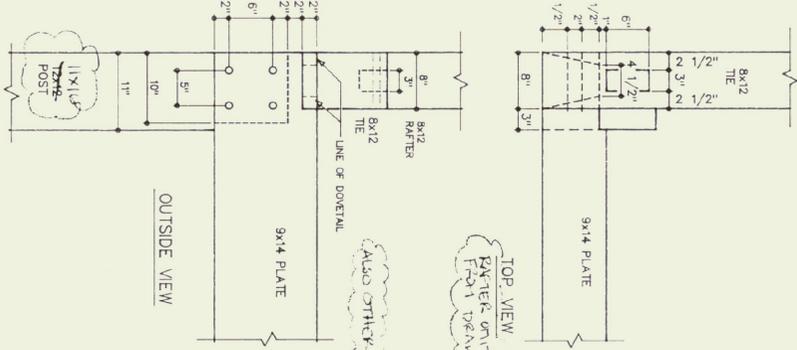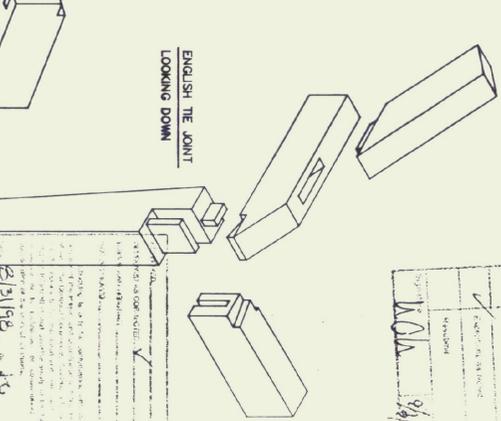

RECORD DRAWING

