



RAFTERS AT HOIST BEAMS  
DETAIL #18

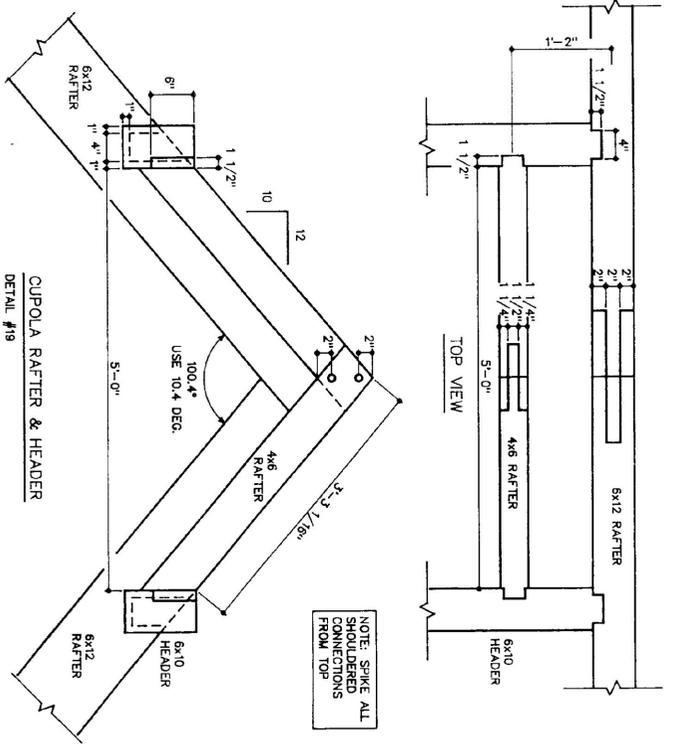


CUPOLA RAFTER & HEADER  
DETAIL #19

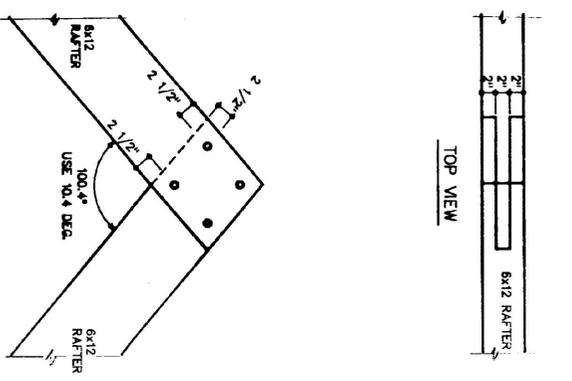


COMMON RAFTER  
DETAIL #20


RECORD DRAWING

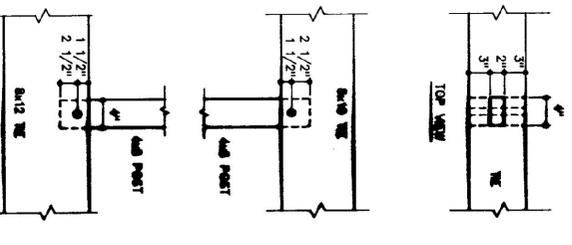


CABLE POST CONNECTION  
DETAIL #21

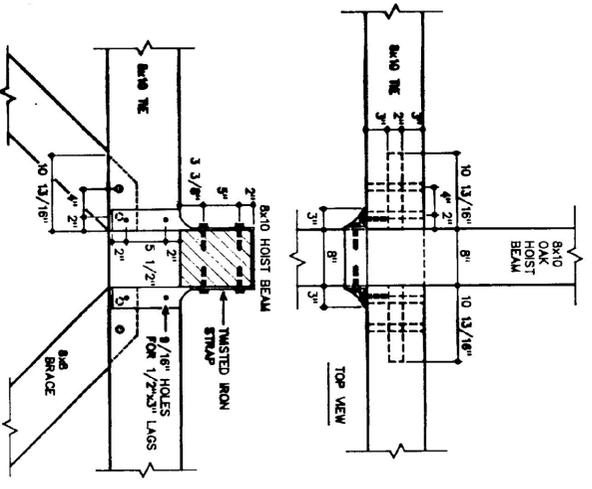


LOWER HOIST BEAM & BRACE CONNECTION  
DETAIL #22

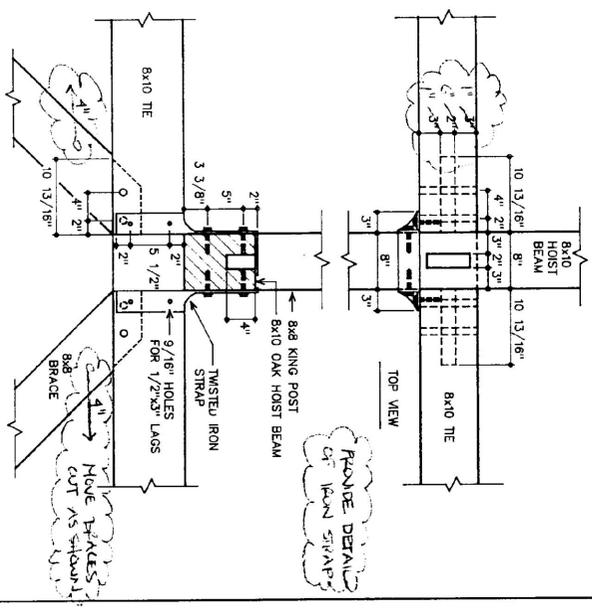


LOWER HOIST BEAM & BRACE CONNECTION /W KING POST  
DETAIL #23

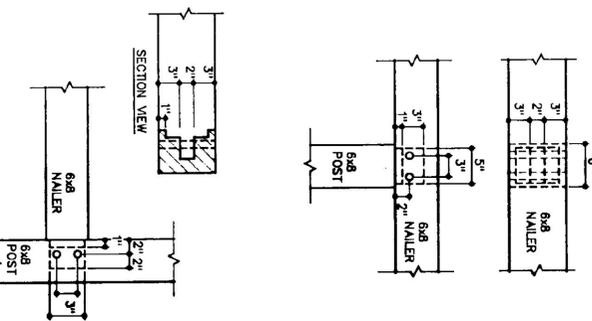


NAILER CONNECTIONS  
DETAIL #24

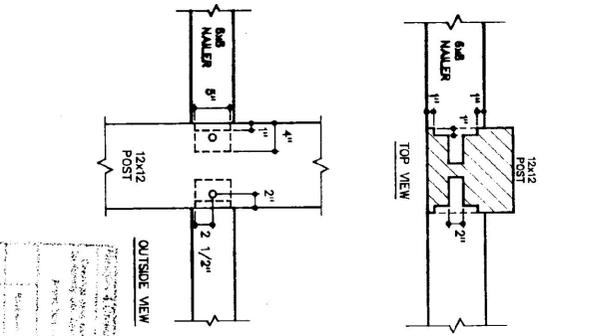


6x8 NAILER AT POST  
DETAIL #25

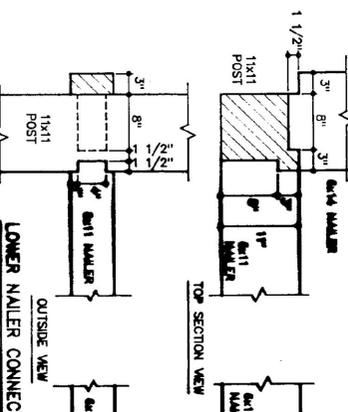

LOWER NAILER CONNECTIONS  
DETAIL #26

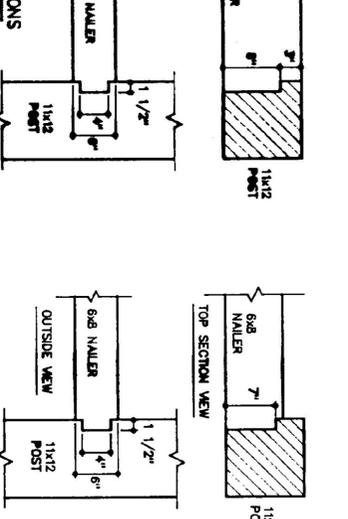

TYPICAL BASE PLATE  
DETAIL #27

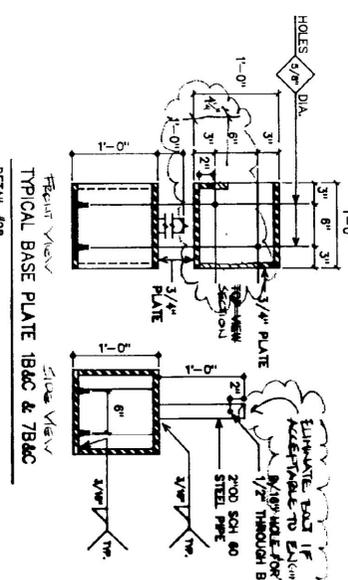

TYPICAL BASE PLATE 1B8C & 7B8C  
DETAIL #28

APPROVED FOR CONSTRUCTION  
DATE: 8/16/98  
BY: [Signature]

PROJECT: SOUTHEAST VERMONT WELCOME CENTER  
GUILFORD, VERMONT

ARCH: TIMOTHY D. SMITH & ASSOCIATES  
ENG: DUPRESNE & HENRY  
G.C.: NEAGLEY & CHASE

SHOP DRAWINGS  
JOINT DETAILS

VERMONT TIMBER WORKS  
SOUTH LONDONDERRY, VT  
802-824-5503

REVISIONS	BY

DRAWN: [Blank]  
CHECKED: [Blank]  
DATE: 8/16/98  
SCALE: 1/2" = 1'-0"  
JOB NO.: [Blank]  
SHEET: F-15  
SHEETS: 08