




UPPER BENTS

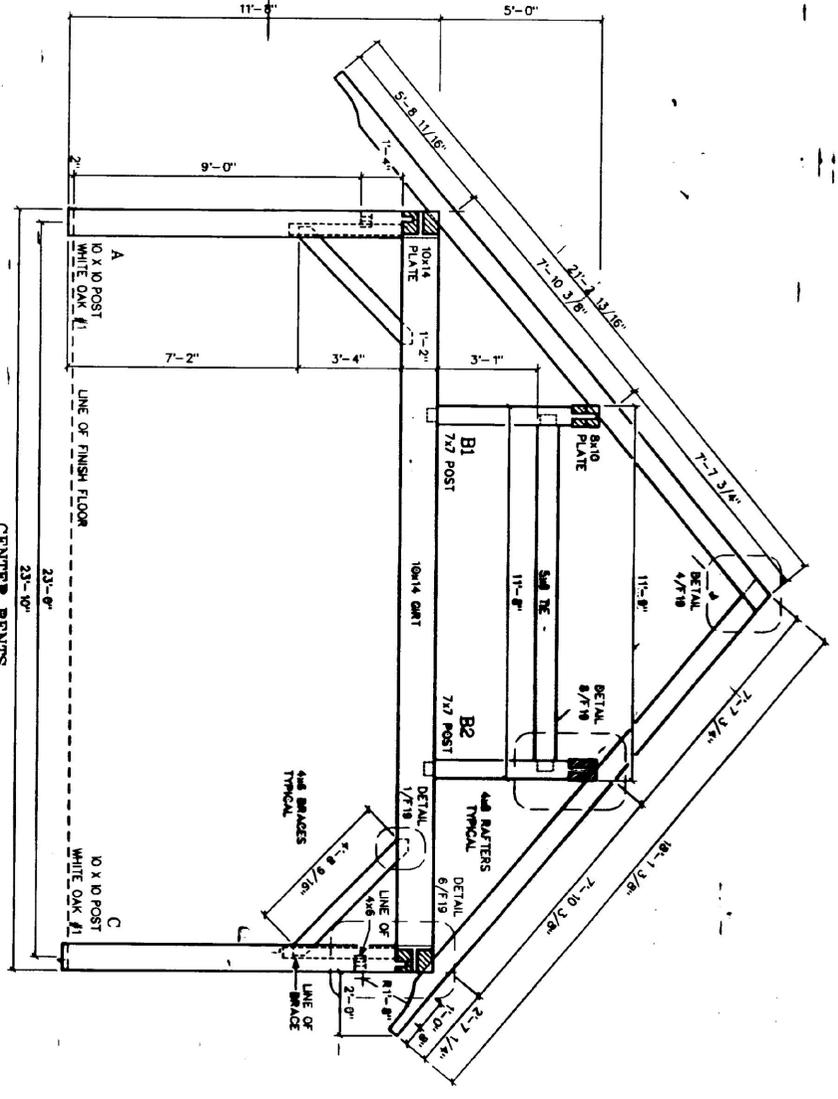

CENTER BENTS

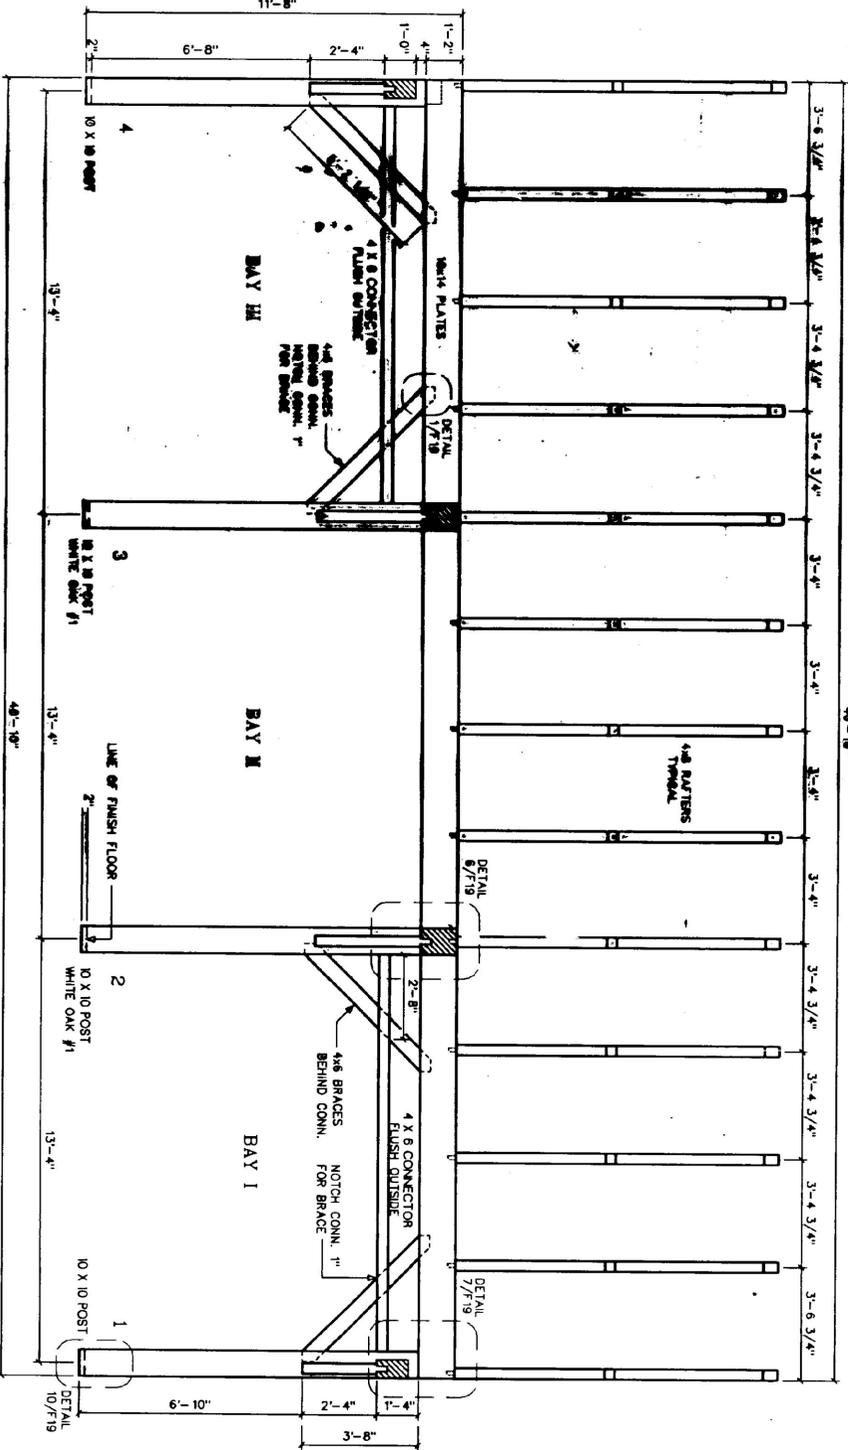

BAY PROFILES

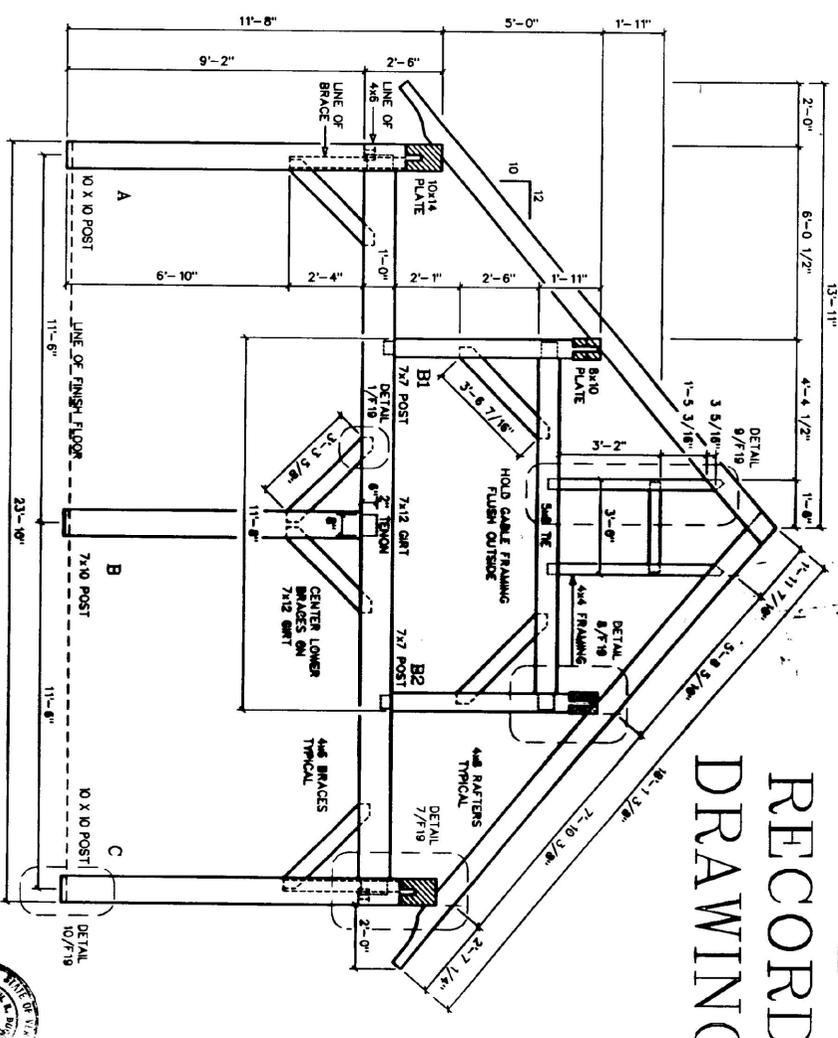

OUTSIDE BENTS

RECORD
DRAWING

PROJECT: SOUTHEAST VERMONT WELCOME CENTER PICNIC SHED GUILFORD, VERMONT

ARCH: TIMOTHY D. SMITH & ASSOCIATES
ENG: DUFRESNE & HENRY
G.C.: NEAGLEY & CHASE

SHOP DRAWINGS
BENTS & BAYS



REVISIONS	BY

DRAWN: D.F. CHECKED:
DATE: 9/14/88
SCALE: 3/8" = 1'-0"
JOB NO.:
SHEET F-17 OF SHEETS

NOTE: ALL DIMENSIONS TO BE AS SHOWN UNLESS NOTED OTHERWISE TO BE CLEAR OAK.

