




CENTER BRACE DETAIL
DETAIL #1

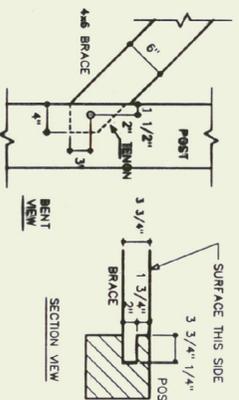


OUTSIDE BRACE DETAIL
DETAIL #2

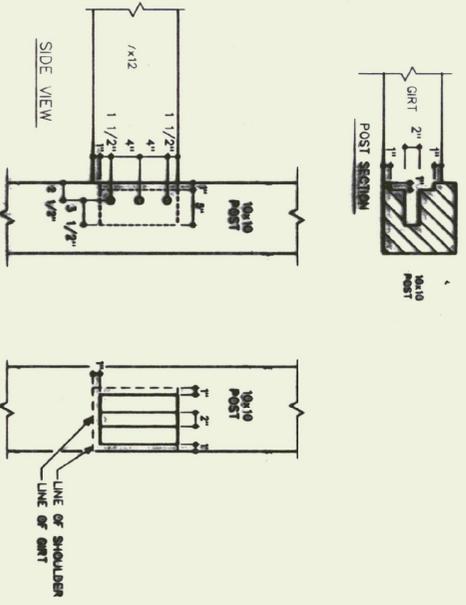



7x12 SHOULDERED TENON
DETAIL #3

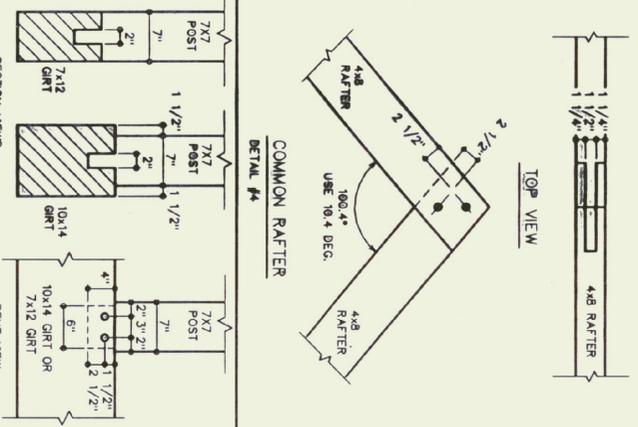



COMMON RAFTER
DETAIL #4

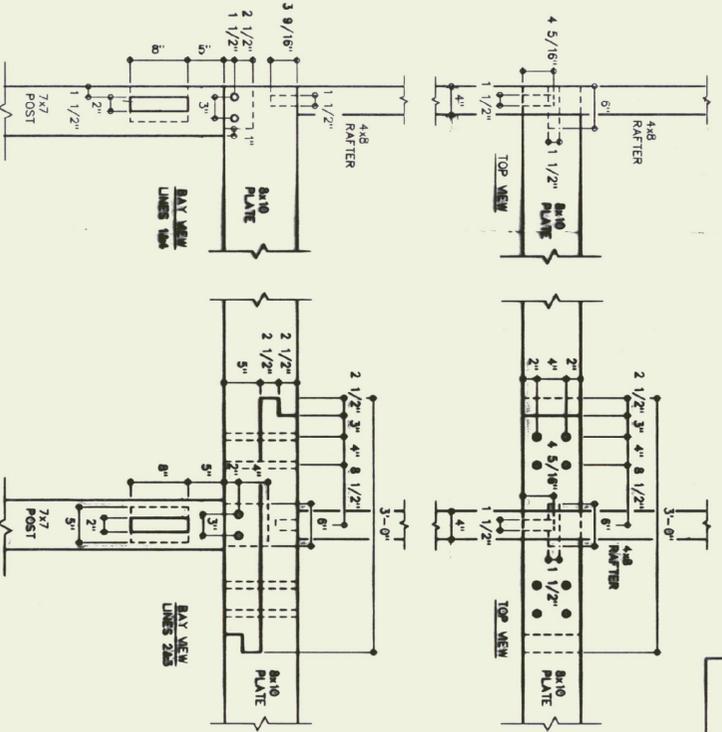


UPPER PLATE CONNECTIONS
DETAIL #5

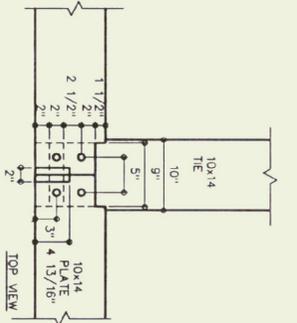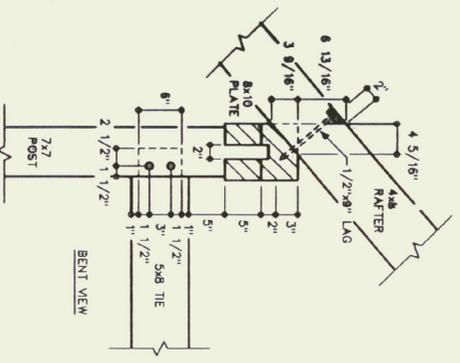



CENTER TIE & RAFTER SEAT
DETAIL #6

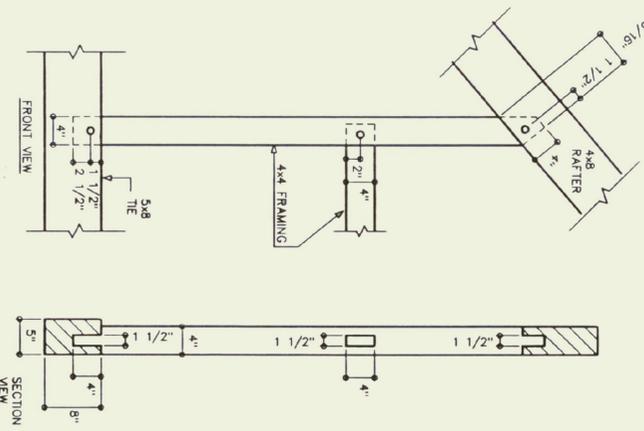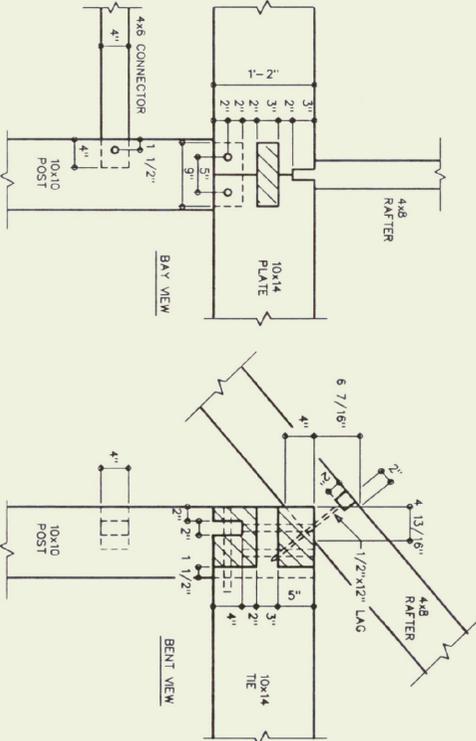


4x4 GABLE FRAMING CONNECTIONS
DETAIL #9

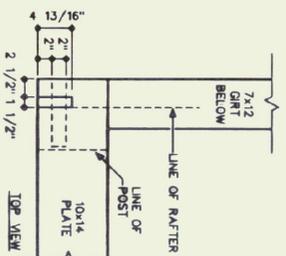

OUTSIDE PLATE & RAFTER SEAT
DETAIL #7

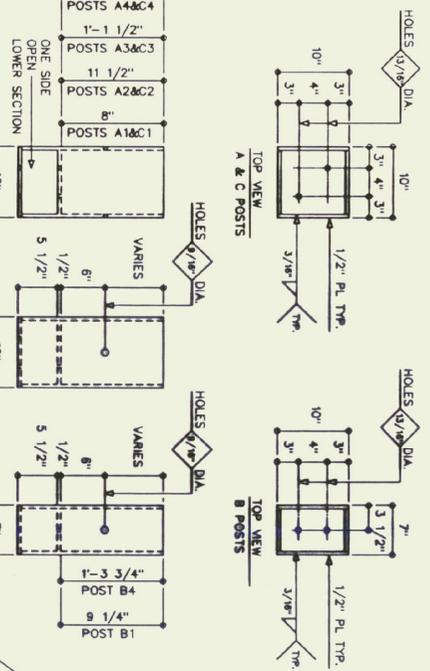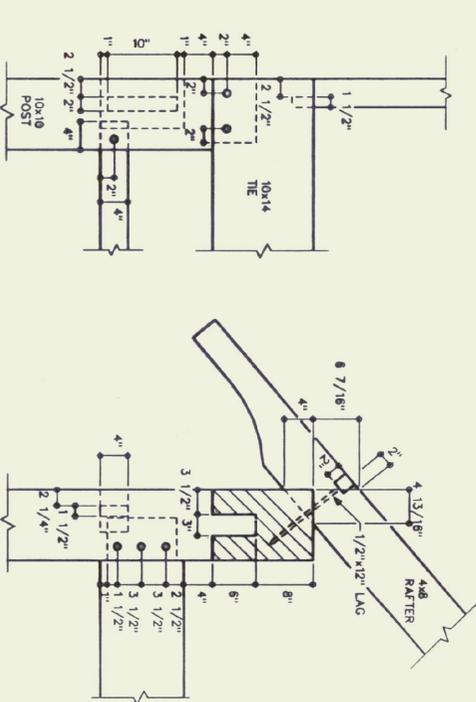

STEEL BASE BOOTS
DETAIL #10

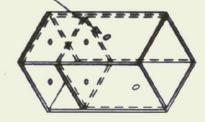

NOTE: ANCHOR POSTS TO BOOTS WITH 1/2" THROUGH RODS TYP. WELDED AT ENDS AND GROUND FLUSH. TOUCH UP EPOXY PAINT AS REQUIRED.

NOTE: 1" CLEAR OAK PEGS TYPICAL FOR ALL EXTERIOR JOINTS

RECORD DRAWING



PROJECT: SOUTHEAST VERMONT WELCOME CENTER PICNIC SHED GUILFORD, VERMONT

ARCH: TIMOTHY D. SMITH & ASSOCIATES
ENG: DUPRESNE & HENRY
G.C.: NEAGLEY & CHASE

SHOP DRAWINGS
JOINT DETAILS



REVISIONS	BY

DATE: 9/14/98
SCALE: 1"=1'-0"
JOB NO.:
SHEET: F-19
OF SHEETS