
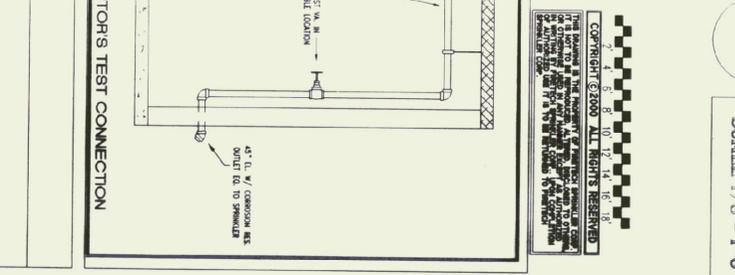
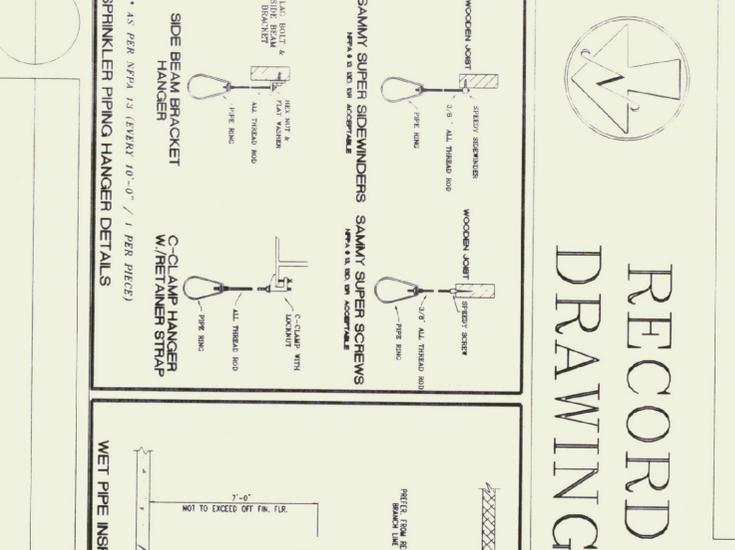


1st FLOOR PLAN
SCALE: 1/8" = 1'-0"

RIS & DETAIL
SCALE: 1/2" = 1'-0"

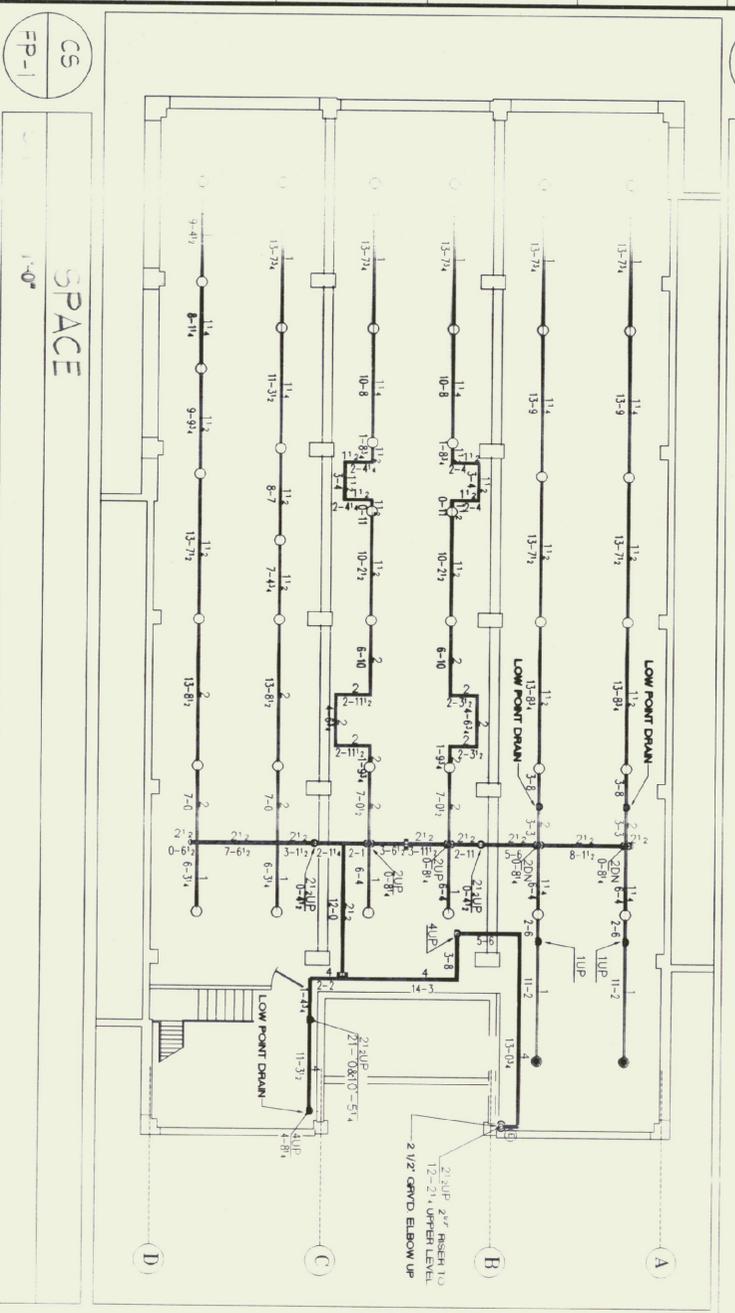

SPRINKLER SYMBOLS AND FINISH SCHEDULE

SYMBOL	NAME	FINISH	NOTE
○	BRASS	105	5/8" 1/2" 1/2"
○	WHITE	105	5/8" 1/2" 1/2"
○	BRASS	105	5/8" 1/2" 1/2"
○	WHITE	105	5/8" 1/2" 1/2"
○	BRASS	105	5/8" 1/2" 1/2"
○	WHITE	105	5/8" 1/2" 1/2"
○	BRASS	105	5/8" 1/2" 1/2"
○	WHITE	105	5/8" 1/2" 1/2"

REVISIONS

REVISION	DATE	DESCRIPTION	BY	APP'D
1	08-25-00	AS-BUILT	SP	J

NOTE

1. ALL WORK SHALL BE IN ACCORDANCE WITH THE LATEST EDITIONS OF THE NFPA 914, 913, 912, 911, 910, 909, 908, 907, 906, 905, 904, 903, 902, 901, 802, 801, 702, 701, 602, 601, 502, 501, 402, 401, 302, 301, 202, 201, 102, 101.

FIRETECH SPRINKLER CORP
1720 HEBBURN AVENUE COLCHESTER, VT 05446
802-655-1800
WWW.FIRETECHSPRINKLER.COM • BUREAU@FIRETECHSPRINKLER.COM

SOUTHEAST VERMONT WELCOME CENTER
AS-BUILT

SPRINKLER PIPING

1-91 at Kilometer Marker 9.01
Guilford, Vermont

CONTRACTOR: NEAGLEY & CHASE