



SEQUENCE: UNIT IS MANUALLY STARTED-STOPPED. ROOM STAT CYCLES FAN WHEN HW IS AVAIL. AS DETERMINED BY STRIP ON ADJUSTIVE SET AT 130° NTS


**UNIT HEATER DETAIL**

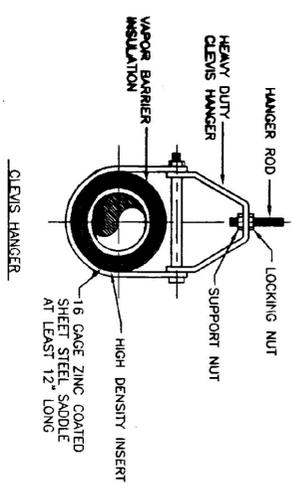


**FIRE DAMPER DETAIL**

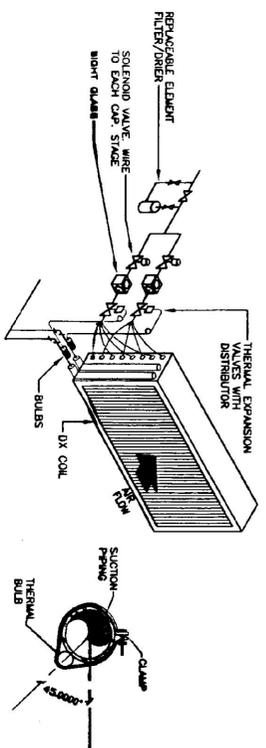


**AHU-1 DX COIL PIPING DETAIL**

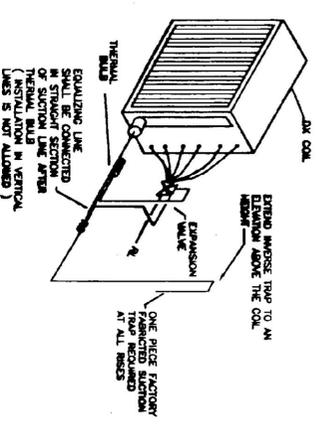


**AHU-2 DX COIL PIPING DETAIL**

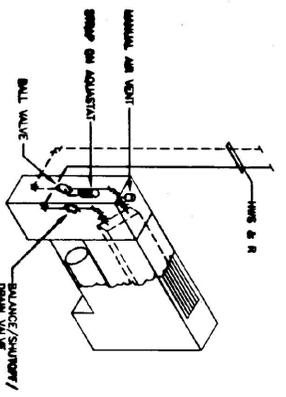


**CABINET HEATER PIPING DETAIL**

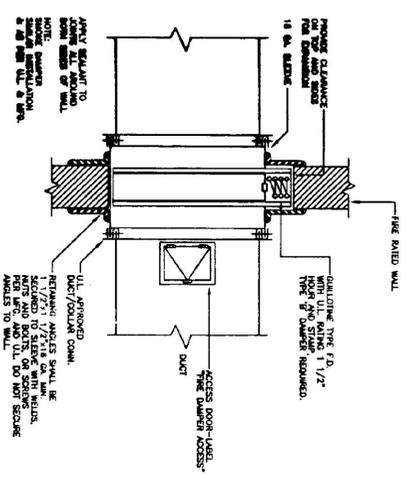

**FIRE DAMPER DETAIL**

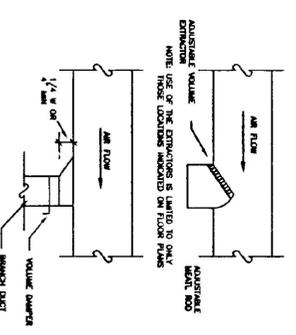

**DUCT TAKE-OFF DETAILS**

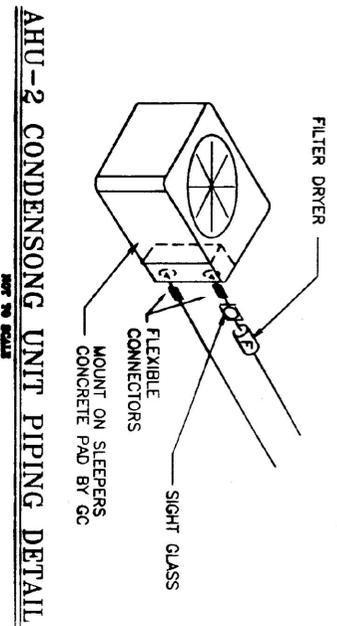

**AHU-2 CONDENSING UNIT PIPING DETAIL**

RECORD  
DRAWING

NO.	DATE	REVISIONS	DRAWN	CHECKED

**TIMOTHY D. SMITH & ASSOCIATES, PC ARCHITECTS**  
 OLD BARRROAD STATION  
 802-442-8184

**VEIGHT ENGINEERING, LTD.**  
 CIVIL ENGINEERS  
 110 HERRINGTON BOVE - P.O. BOX 139  
 100 BURLINGTON, VERMONT 05418-0139  
 TEL 778-8811 FAX 778-8818

**ROBT W. HALL**  
 CONSULTING ENGINEERS, INC.  
 640 WINDSOR STREET EXTENSION, 5TH FLOOR  
 05401 BURLINGTON, VERMONT 05401  
 TEL 768-3000 FAX 768-3000

**T.J. BOYLE AND ASSOCIATES**  
 LANDSCAPE ARCHITECTS  
 501 COLLIER STREET  
 05401 BURLINGTON, VERMONT 05401  
 TEL 863-1082 FAX 863-1082

PROJECT NO. IM 091-1 (30)  
 SOUTHEAST VERMONT WELCOME CENTER  
 GUILDFORD, VERMONT

STATE OF VERMONT  
 AGENCY OF ADMINISTRATION  
 DEPARTMENT OF  
 BUILDINGS & GENERAL SERVICES

CHECKED BY: RFG  
 DSGN BY: RFG

CHECKED BY: RWH  
 DATE: 1-16-98

SHEET NO. \_\_\_\_\_ OF \_\_\_\_\_ SHEETS

**M-6**