

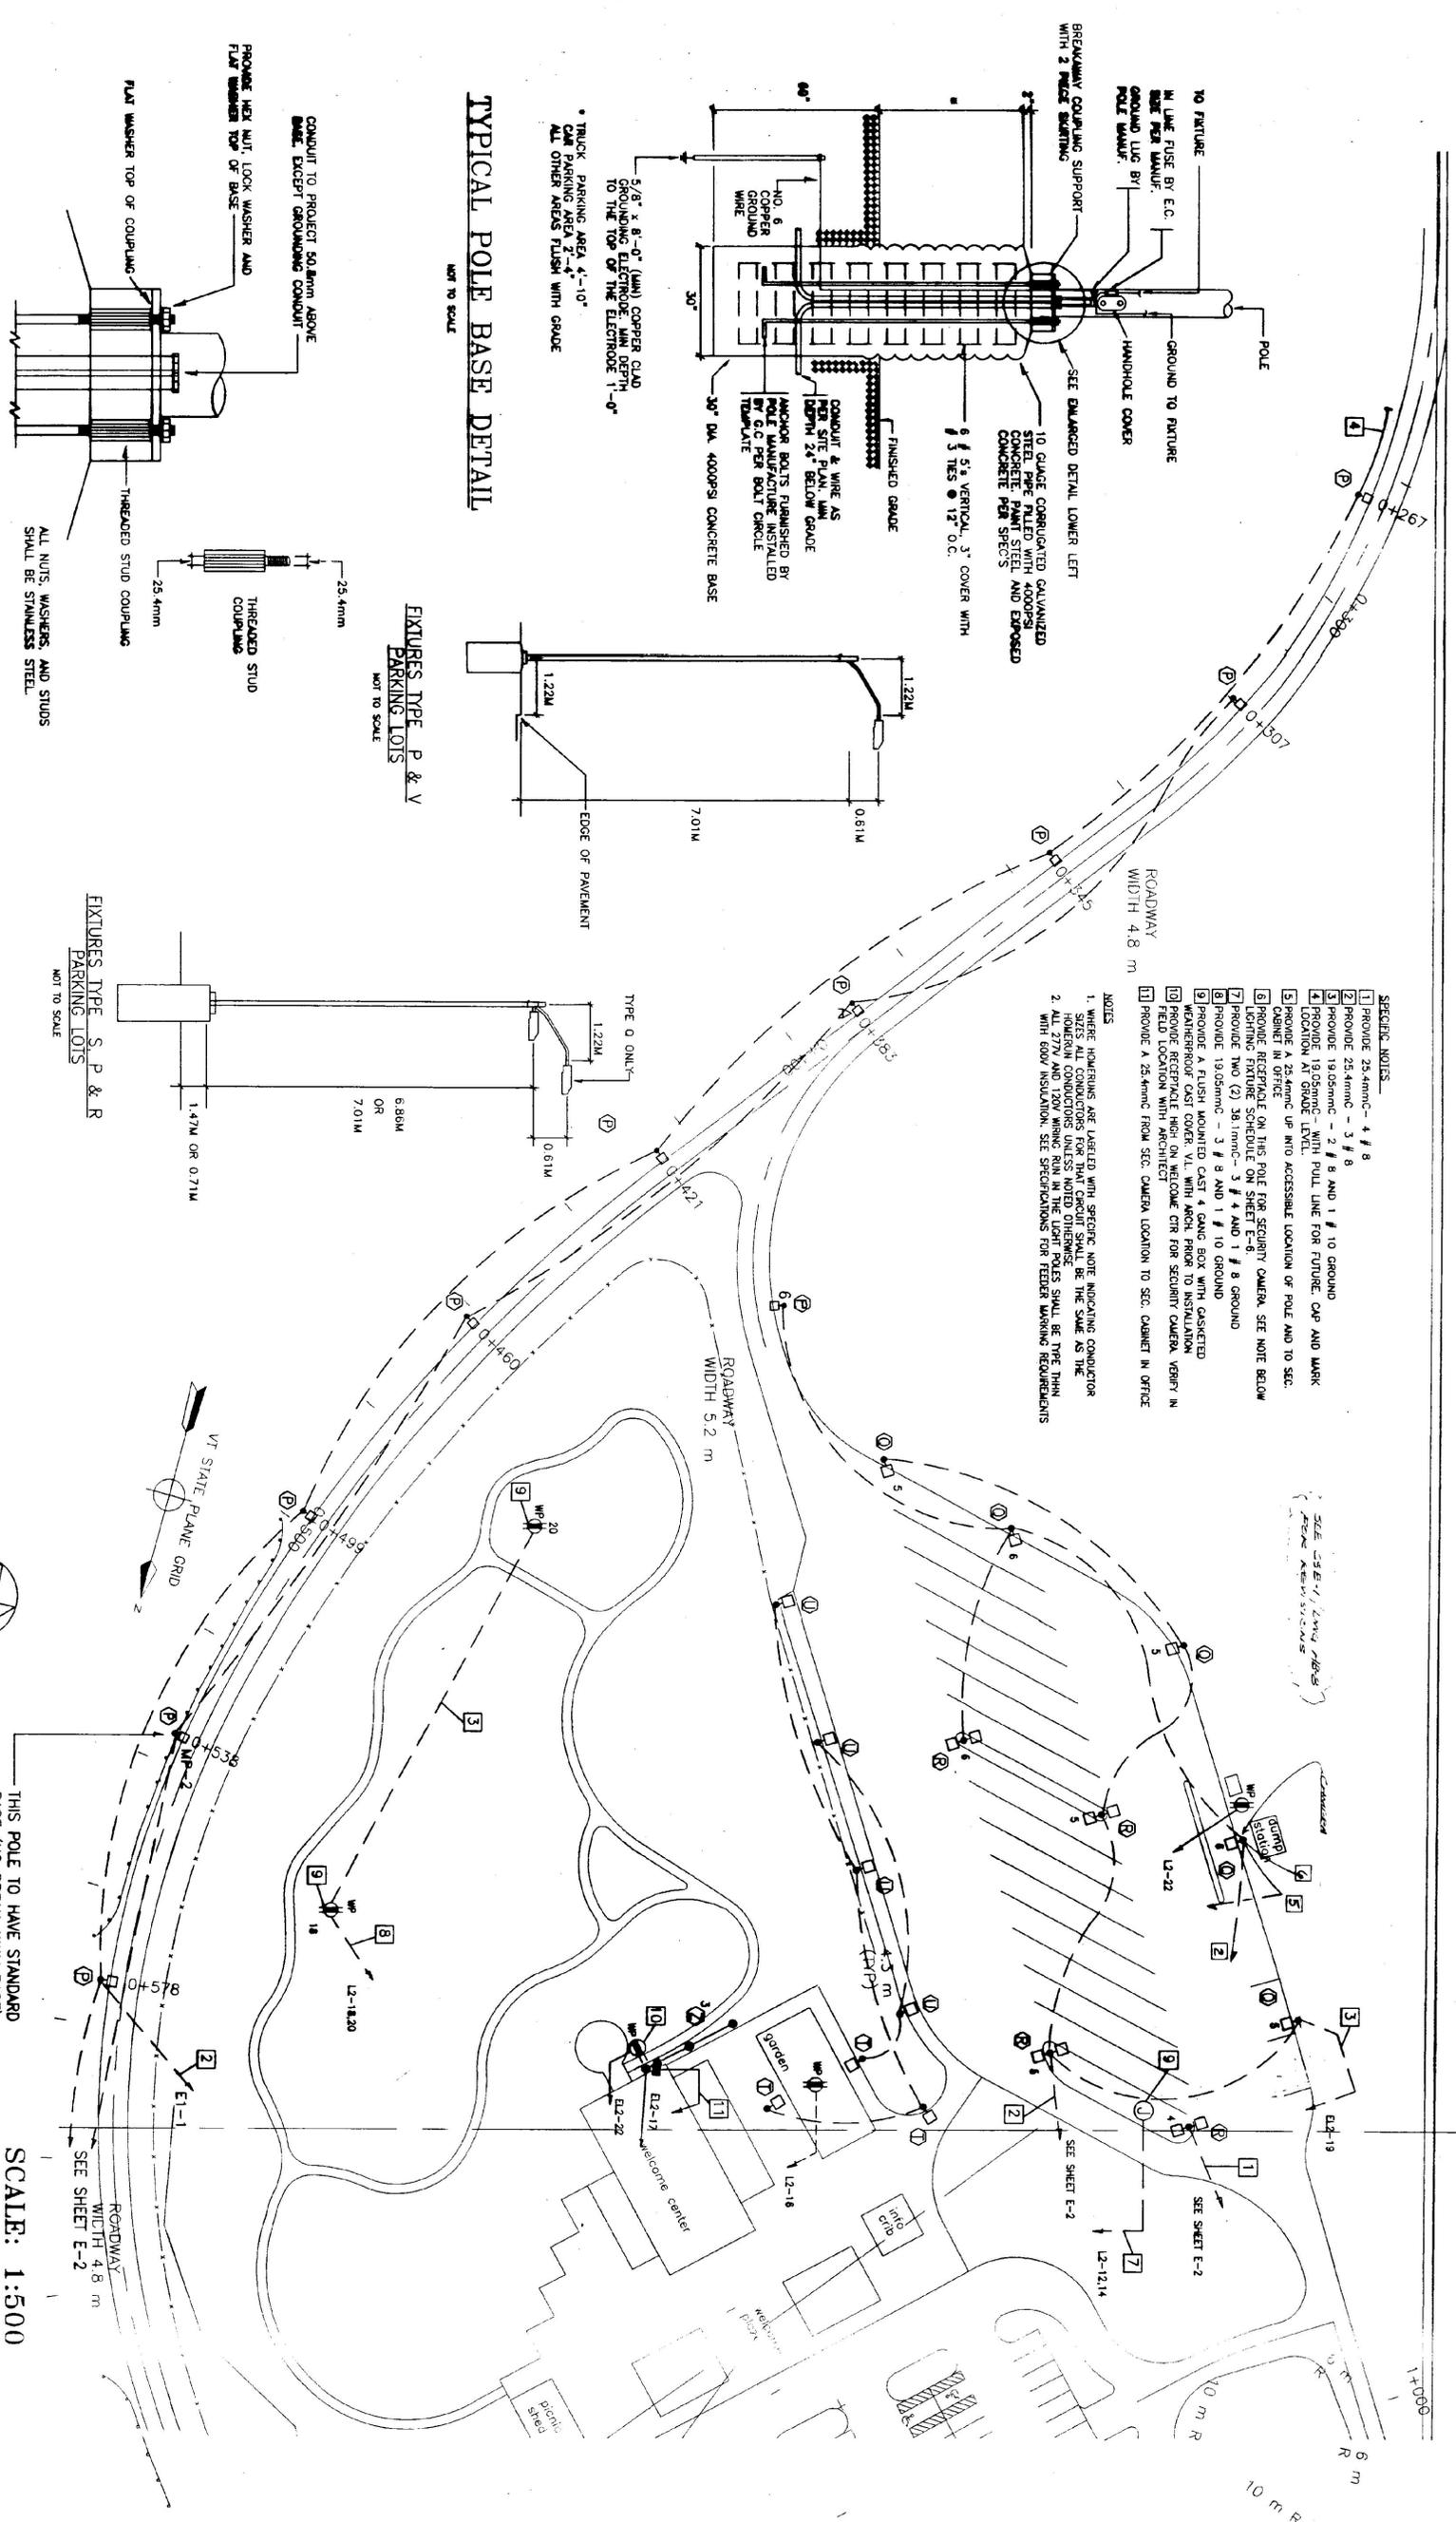


ROADWAY WIDTH 5.2 m

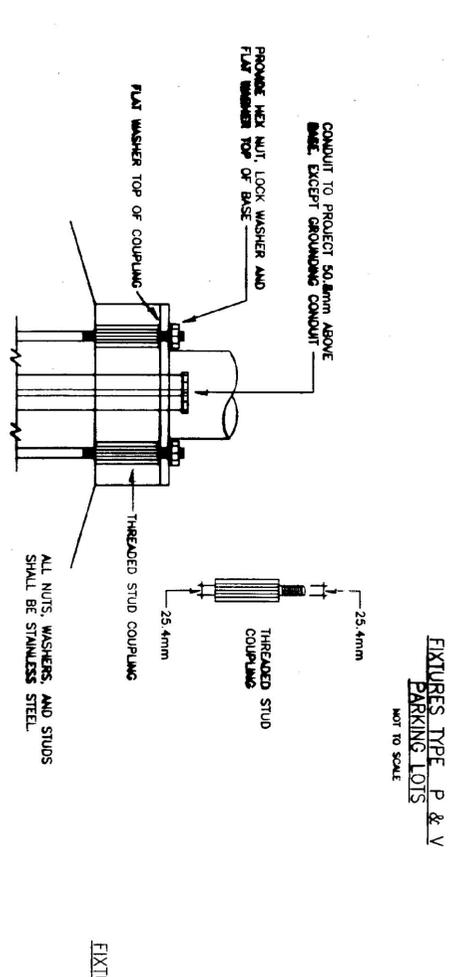

- SPECIFIC NOTES**
- 1] PROVIDE 25.4mmC-4 # 8
 - 2] PROVIDE 25.4mmC-3 # 8
 - 3] PROVIDE 19.05mmC-2 # 8 AND 1 # 10 GROUND
 - 4] PROVIDE 19.05mmC-1 # 8 AND 1 # 10 GROUND
 - 5] PROVIDE A 25.4mmC UP INTO ACCESSIBLE LOCATION OF POLE AND TO SEC. CABINET IN OFFICE
 - 6] PROVIDE RECEPABLE ON THIS POLE FOR SECURITY CAMERA. SEE NOTE BELOW
 - 7] PROVIDE TWO (2) 38.1mmC-3 # 4 AND 1 # 8 GROUND
 - 8] PROVIDE 19.05mmC-3 # 8 AND 1 # 10 GROUND
 - 9] PROVIDE A FLUSH MOUNTED CAST 4 GANG BOX WITH CASSETTED WEATHERPROOF CAST COVER V.L. WITH ARCH. PRIOR TO INSTALLATION.
 - 10] PROVIDE RECEPABLE HIGH ON WELCOME CTR FOR SECURITY CAMERA. VERIFY IN FIELD LOCATION WITH ARCHITECT
 - 11] PROVIDE A 25.4mmC FROM SEC. CAMERA LOCATION TO SEC. CABINET IN OFFICE
- NOTES**
1. WHERE DIMENSIONS ARE LABELED WITH SPECIFIC NOTE INDICATING CONDUCTOR SIZES ALL CONDUCTORS FOR THAT CIRCUIT SHALL BE THE SAME AS THE HIGHEST CONDUCTORS UNLESS NOTED OTHERWISE
 2. ALL 277V AND 120V WIRING RUN IN THE UPRIGHT POLES SHALL BE TYPE THHN WITH 600V INSULATION. SEE SPECIFICATIONS FOR FEEDER WIRING REQUIREMENTS

TYPICAL POLE BASE DETAIL

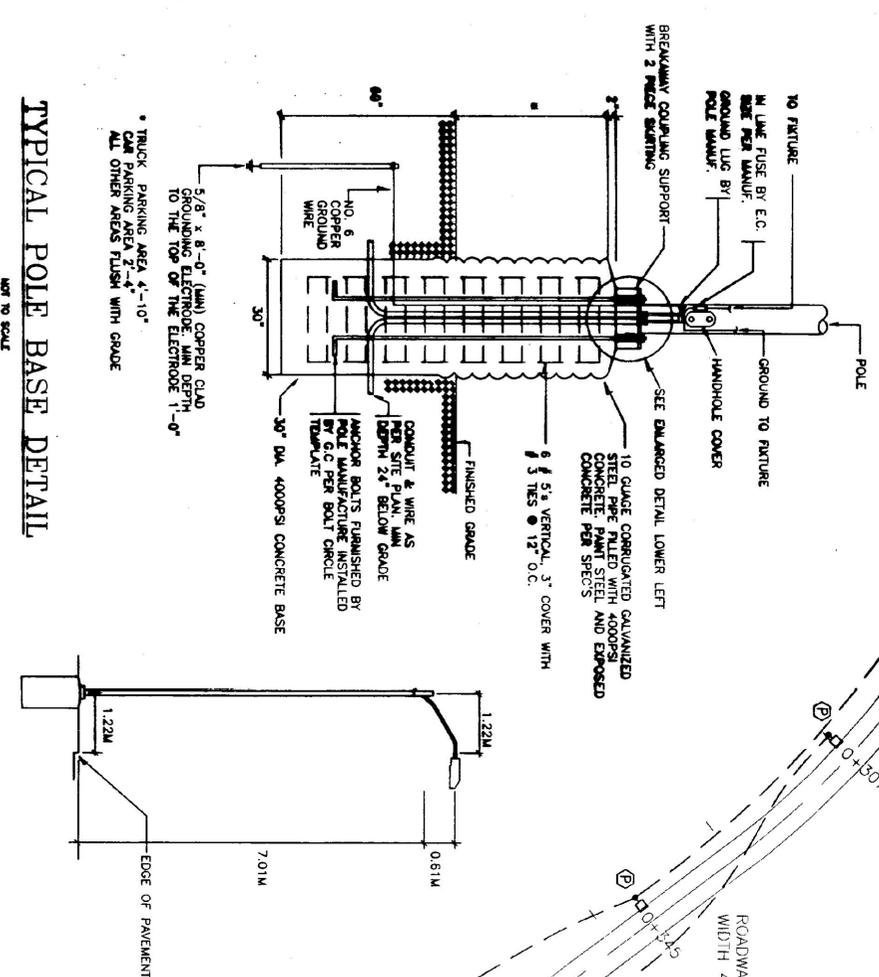

STAINLESS STEEL BREAK-AWAY SUPPORT DETAIL

SCALE: 1:500
Metric

NO.		DATE		REVISIONS		DRAWN		CHKD	
<p>RECORD DRAWING</p>									
<p>TIMOTHY D. SMITH & ASSOCIATES, PC ARCHITECTS OLD RAILROAD STATION 802-442-8184</p>					<p>ROBT W. HALL CONSULTING ENGINEERS, INC. 440 BELLEVUE STREET EXTENSION, STR. 2 BURLINGTON, VT 05401 405-469-5850</p>				
<p>WRIGHT ENGINEERING, LTD. 128 MIDDLEBURY ROAD MIDDLEBURY, VT 05751 802-249-3011</p>					<p>T.J. BOYLE AND ASSOCIATES LANDSCAPE ARCHITECTS 301 COLLIER STREET BURLINGTON, VT 05401 802-469-5850</p>				
<p>PROJECT NO. IM 091-1 (30) SOUTHEAST VERMONT WELCOME CENTER GUILFORD, VERMONT</p>									
DSGN BY:		MLB		CHKD BY:		RWH		DATE: 01-16-98	
SHEET TITLE: SITE POWER AND LIGHTING PLAN		STATE OF VERMONT AGENCY OF ADMINISTRATION DEPARTMENT OF BUILDINGS & GENERAL SERVICES		SHEET NO. _____		OF _____		SHEETS	
<p>E-1</p>									