


I 91 NORTHBOUND

155 m ACCELERATION LANE




90 TAPER

INTERSTATE 1-91 (NORTHBOUND)

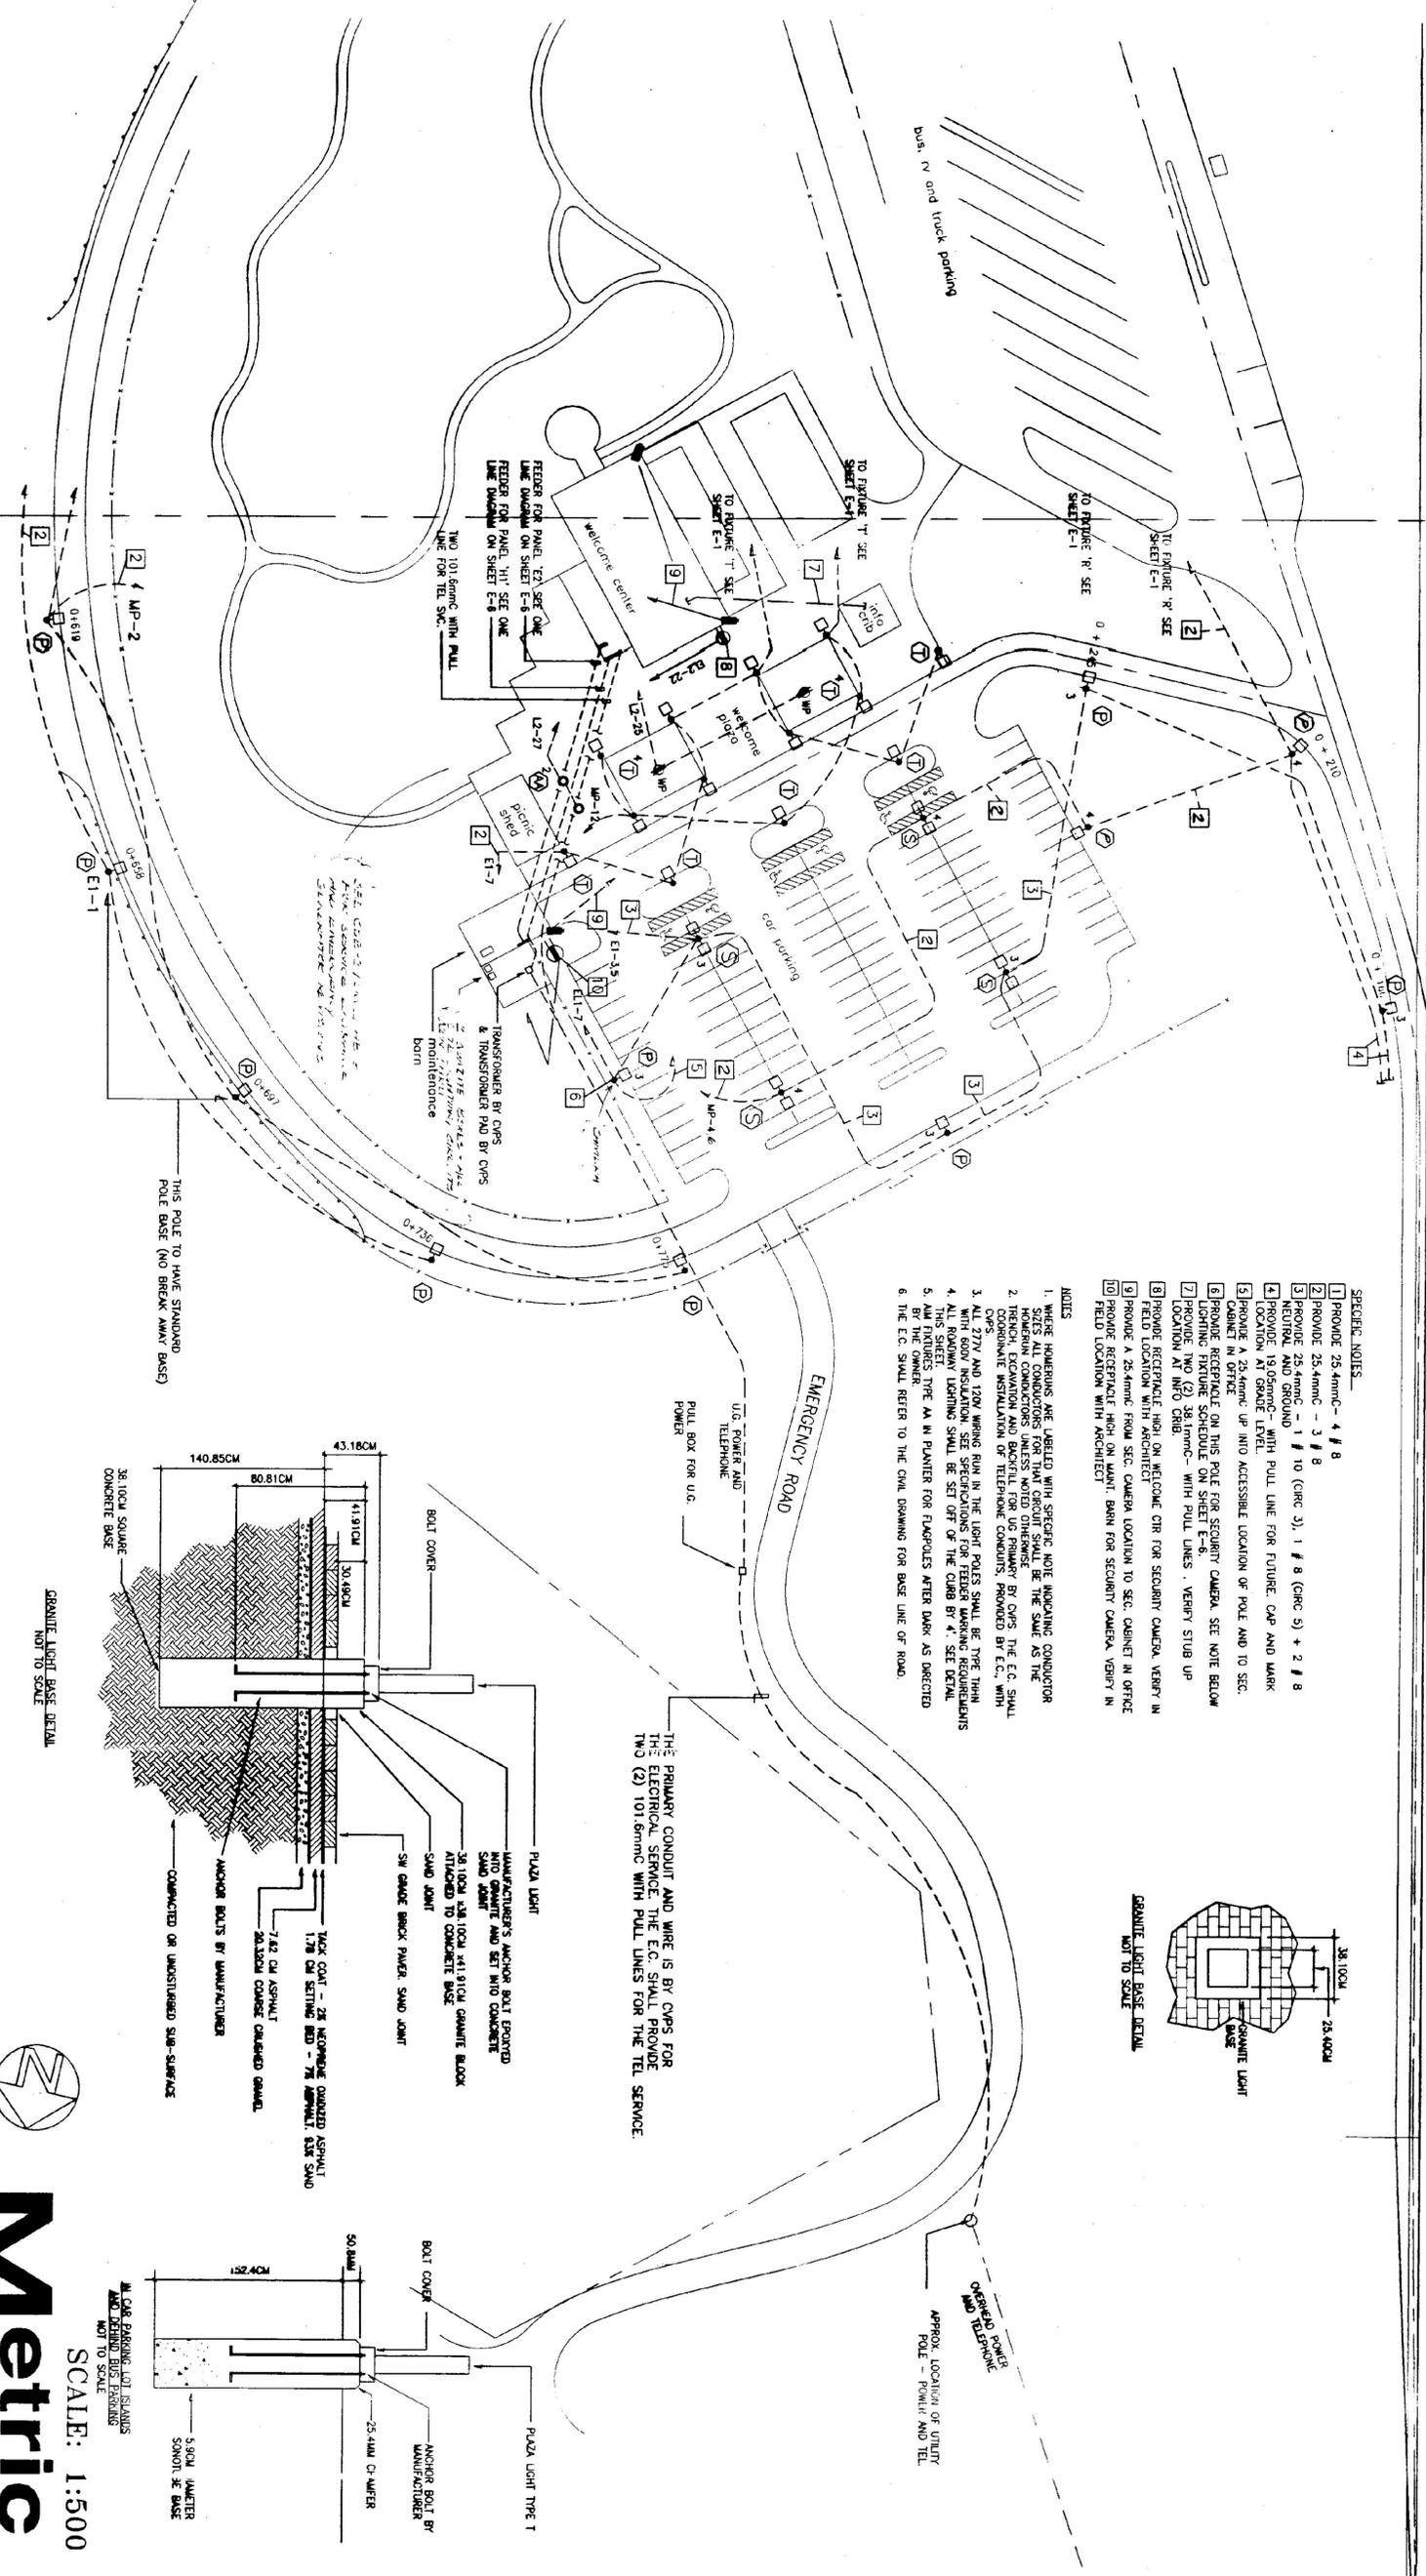

- SECURITY NOTES:**
1. PROVIDE 25.4mmC - 4 # 8
 2. PROVIDE 25.4mmC - 3 # 8
 3. PROVIDE 25.4mmC - 1 # 10 (CIRC 3), 1 # 8 (CIRC 5) + 2 # 8
 4. PROVIDE 19.05mmC - WITH PULL LINE FOR FUTURE, CAP AND MARK LOCATION AT GRADE LEVEL.
 5. PROVIDE A 25.4mmC UP INTO ACCESSIBLE LOCATION OF POLE AND TO SEC. CABINET IN OFFICE
 6. PROVIDE RECEPTEGE ON THIS POLE FOR SECURITY CAMERA. SEE NOTE BELOW LIGHTING SCHEDULE ON SHEET E-6.
 7. PROVIDE A 25.4mmC - WITH PULL LINES - VERIFY STUB UP LOCATION AT INFO CABIN
 8. PROVIDE RECEPTEGE WITH ON REC-COME CIR FOR SECURITY CAMERA. VERIFY IN FIELD LOCATION WITH ARCHITECT
 9. PROVIDE A 25.4mmC FROM SEC. CAMERA LOCATION TO SEC. CABINET IN OFFICE
 10. PROVIDE RECEPTEGE WITH ON REC-COME CIR FOR SECURITY CAMERA. VERIFY IN FIELD LOCATION WITH ARCHITECT

- NOTES:**
1. WHERE DIMENSIONS ARE LABELED WITH SPECIFIC NOTE REGARDING CONDUCTOR SIZES ALL CONDUCTORS FOR THAT CIRCUIT SHALL BE THE SAME AS THE DIMENSION UNLESS NOTED OTHERWISE
 2. TRENCH, EXCAVATION AND BACKFILL FOR UG PRIMARY BY COPS THE E.C. SHALL PROVIDE INSULATION OF TELEPHONE CONDUITS, PROVIDED BY E.C. WITH COPS
 3. ALL 277V AND 120V WIRING RUN IN THE LIGHT POLES SHALL BE TYPE THHN WITH 600V INSULATION. SEE SPECIFICATIONS FOR FEEDER MARKING REQUIREMENTS
 4. ALL RIGID WIRING SHALL BE SET OFF OF THE CURB BY 4'. SEE DETAIL
 5. ALL FITTINGS TYPE A IN PLANNING FOR FLAGPOLES AFTER DARK AS DIRECTED BY THE OWNER
 6. THE E.C. SHALL REFER TO THE CIVIL DRAWING FOR BASE LINE OF ROAD

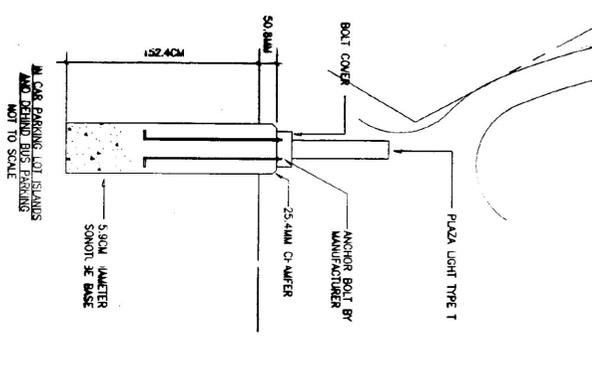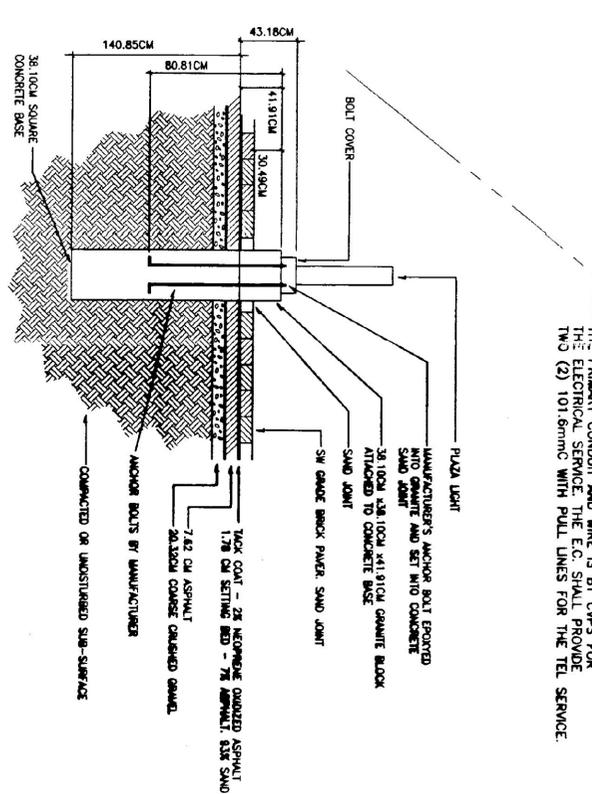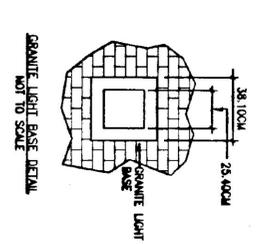

NO.	DATE	REVISIONS	DRAWN	CHECKD

RECORD DRAWING

TIMOTHY D. SMITH & ASSOCIATES, PC ARCHITECTS
 OLD RAILROAD STATION
 802-442-8184

WRIGHT ENGINEERING, LTD.
 CIVIL ENGINEERS
 188 WASHINGTON ST. - P.O. BOX 176
 VERMONT STATEMENT SERVICE
 TEL 789-8444 FAX 789-8444

ROBT W. HALL
 CONSULTING ENGINEERS, INC.
 645 RAILROAD STREET EXTENSION, STE. 2
 MIDDLEBURY VERMONT 05750
 TEL 789-2600 FAX 789-2600

T.J. BOYLE AND ASSOCIATES
 LANDSCAPE ARCHITECTS
 301 COLLEGE STREET
 BURLINGTON, VERMONT 05401
 802-488-8888 FAX 802-488-1242



PROJECT NO. IM 091-1 (30)
 SOUTHEAST VERMONT WELCOME CENTER
 GUILFORD, VERMONT

DSGN BY: MLB
 DRWN BY: MLB
 CHKD BY: RWJ

STATE OF VERMONT
 AGENCY OF ADMINISTRATION
 DEPARTMENT OF
 BUILDINGS & GENERAL SERVICES

SCALE: 1:500

Metric

DATE: 01-16-98 SHEET NO. OF SHEETS

E-2