


FAIR HAVEN WELCOME CENTER SEWER FORCE MAIN

RECORD DRAWINGS

FEDERAL PROJECT NO. NH-020-1(16)

APRIL 2000

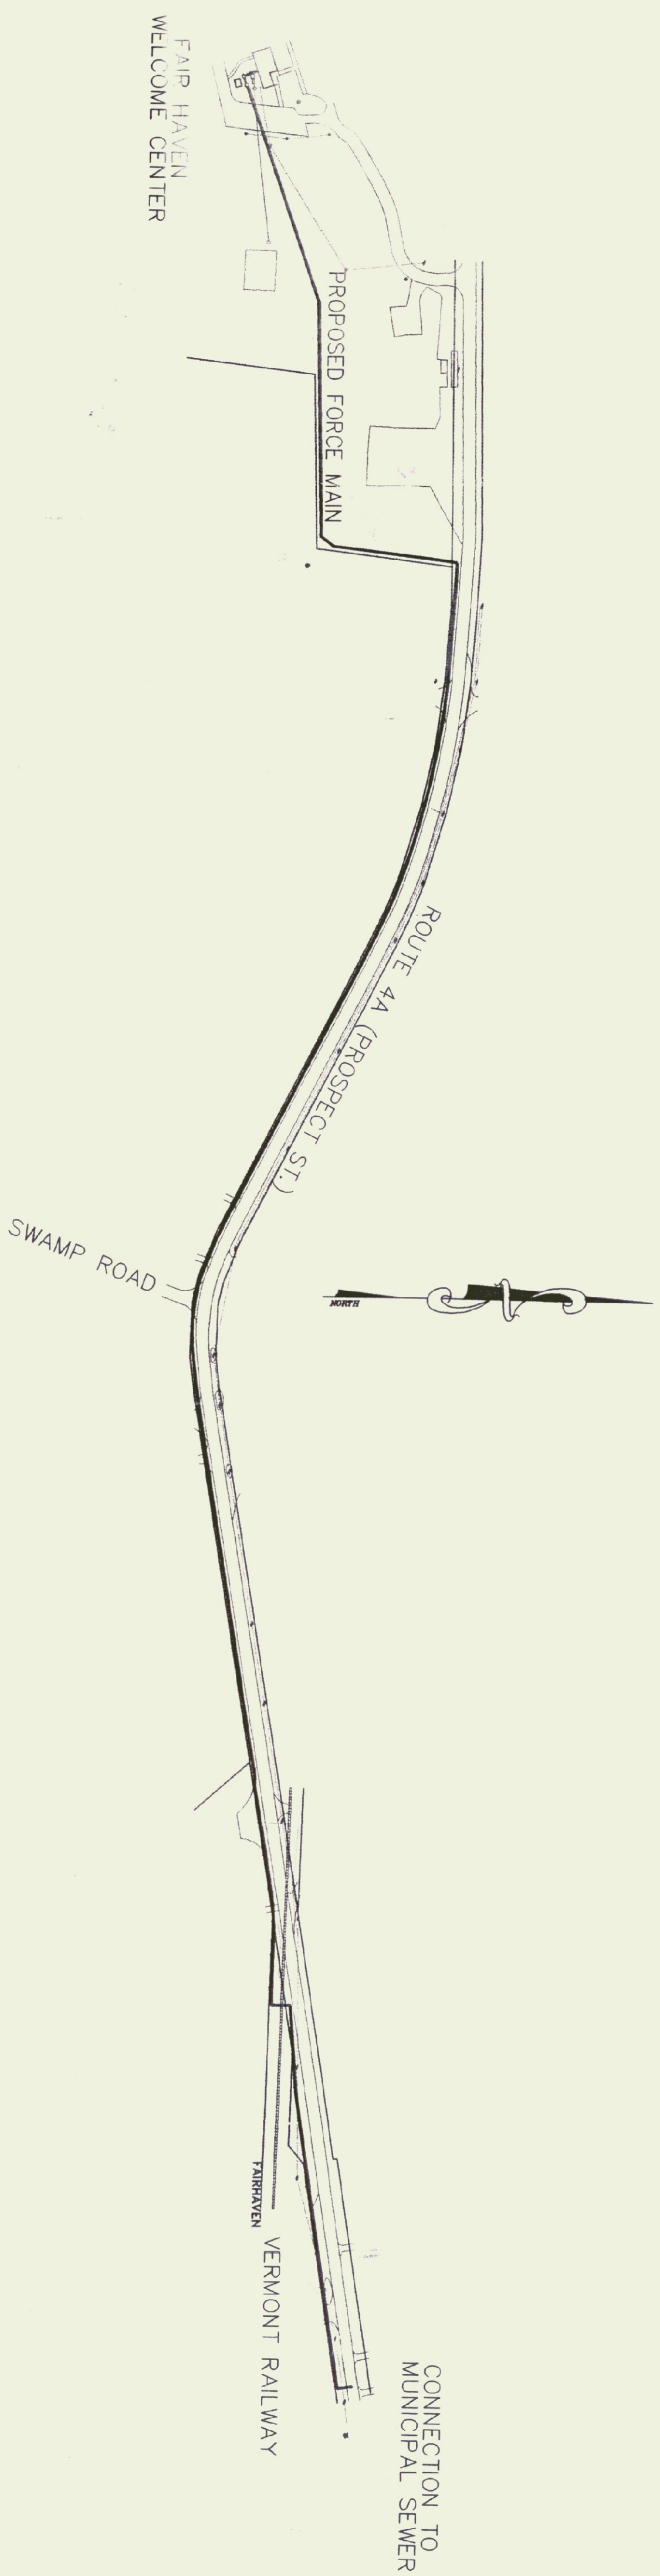

OWNER

STATE OF VERMONT AGENCY OF ADMINISTRATION
DEPARTMENT OF BUILDINGS AND GENERAL SERVICE
2 GOVERNOR AIKEN AVENUE
MONTPELIER, VERMONT 05633-5801
THOMAS W. TORTI, COMMISSIONER

SHEET INDEX



1. WELCOME CENTER SITE PLAN
2. SEWER PLAN 0+00 TO 15+50
3. SEWER PLAN 15+50 TO 29+50
4. SEWER PLAN 29+50 TO 49+30
5. SEWER PROFILES 0+00 TO 23+00
6. SEWER PROFILES 23+00 TO 49+30
7. MISC. SEWER DETAILS
8. MISC. SEWER DETAILS
9. A.O.T. TRAFFIC CONTROL DETAILS

OWNER

FEDERAL HIGHWAY ADMINISTRATION
87 STATE STREET
MONTPELIER, VERMONT 05602
ADMINISTRATOR _____ DATE _____

CIVIL ENGINEER
ENMAN ENGINEERING, P.C.
230 NORTH MAIN STREET
RUTLAND, VERMONT 05701
(802) 775-3437

WELCOME CENTER

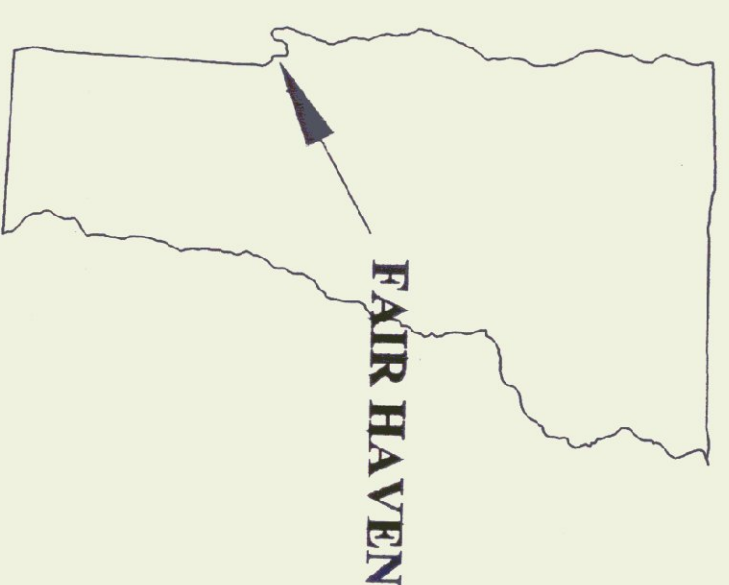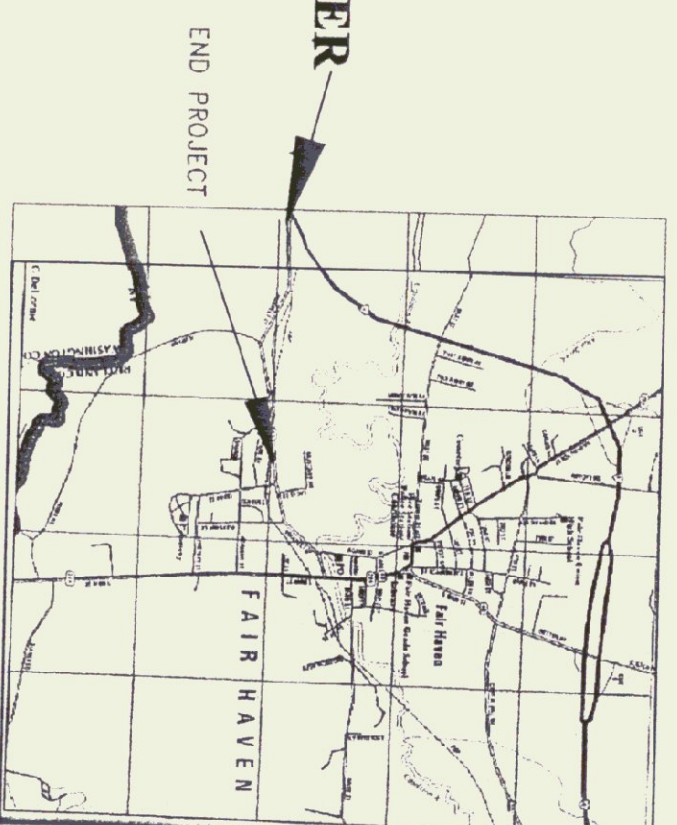

*Record
Drawings
Issued
2-2000*