


**LEGEND**

- APPROX. LOCATION OF PROPERTY LINE
- - - - - EXISTING CONTOUR
- EXISTING 5' CONTOUR
- EXISTING 5' CONTOUR
- PROPOSED 5' CONTOUR
- EXISTING OVERHEAD UTILITY LINES
- EXISTING BURIED UTILITY LINES
- EXISTING CULVERT
- EXISTING STORM SEWER
- PROPOSED FORCE MAIN
- EXISTING CATCH BASIN
- EXISTING UTILITY POLE
- EXISTING SIGN
- EXISTING HYDRANT
- RR CROSSING SIGNAL LIGHT
- IRON PIN FOUND
- EXISTING WELL
- PROPOSED SEWER MANHOLE
- LIGHT POLE

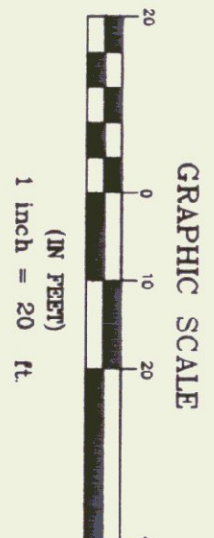

CONTRACTOR TO EXCAVATE EXPOSED AND PROVIDE SEPTIC TANK INVERT IN ELEVATION TO ENGINEER PRIOR TO CONSTRUCTING ANY PART OF THE SYSTEM

CONTRACTOR TO CONSTRUCT NEW PUMP STATION AND FORCE MAIN WITHOUT DISRUPTION TO OPERATION OF EXISTING WATER SYSTEM. FOLLOWING COMPLETION OF CONSTRUCTION, TESTING AND ACCEPTANCE BY THE OWNER THE CONTRACTOR SHALL THEN CONNECT THE BUILDING SEWER TO THE NEW PUMPSTATION.

THE CERTIFICATION ON THIS DRAWING ONLY INDICATES THE VT REGISTERED PROFESSIONAL ENGINEER RESPONSIBLE FOR PREPARATION AND IS NOT ISSUED FOR CONSTRUCTION UNLESS NOTED IN THE REVISION BOX.

REGULATORY APPROVAL STAMP



**Enman Engineering**  
 Environmental & Civil & Sanitary  
 230 North Main Street  
 Rutland, Vermont 05701  
 (802) 775-3437  
 Copyright © 1998  
 All rights reserved.

**FAIRHAVEN, VERMONT**

THESE PLANS ARE FOR THIS PROJECT ONLY AND ARE NOT FOR REUSE ON THIS PROJECT OR ANY OTHER PROJECT WITHOUT WRITTEN CONSENT OF ENMAN ENGINEERING, P.C.

**FAIR HAVEN WELCOME CENTER**

ISSUED FOR:  
**RECORD DRAWING**

RELEASED:  
**APRIL 2000**

**REVISIONS:**

3/11/99	RELEASED TO TOWN OF FAIR HAVEN FOR REVIEW
6/15/99	REVISE FORCE MAIN MISC. NOTE
7/02/99	ADD CLEANOUT LOCATIONS
8/20/99	MISC. PLAN EDITS
2/15/00	MISC. NOTE EDITS
	ADD RECORD INFORMATION

**WELCOME CENTER SITE PLAN**

**RECORD DRAWING**

SCALE: AS NOTED

DATE: 02/24/99

DESIGN BY: BJE/TNT

DRAWN BY: JBT/JPL

SHEET NO: 1 OF 9

PROJECT NO: 9816

THIS RECORD DRAWING IS BASED ON INFORMATION FURNISHED IN PART BY OTHERS WHICH CAN NOT BE VERIFIED BY ENMAN ENGINEERING P.C. PERSONNEL. ENMAN ENGINEERING P.C. PERSONNEL WERE NOT PRESENT DURING ALL ASPECTS OF CONSTRUCTION AND DEVIATIONS FROM THE DRAWINGS THAT WERE MADE DURING CONSTRUCTION ARE NOT SHOWN ABOVE. GRADE INSTALLATION IS PICTORIAL AND FIELD MEASUREMENT IS RECOMMENDED.