
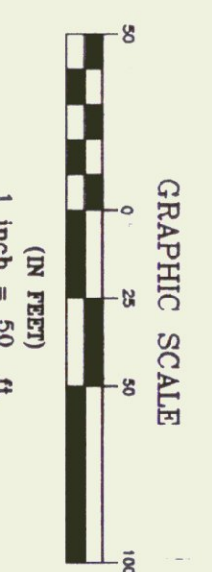


- NOTES:**
1. REMOVE ROAD SIGNS AS REQUIRED. RESET/REINSTALL SIGNS AFTER BACK FILLING TRENCH.
 2. EXISTING UTILITY LOCATIONS ARE APPROXIMATE AND CONTRACTOR SHALL VERIFY EXACT LOCATIONS PRIOR TO COMMENCING WORK. CONTRACTOR IS RESPONSIBLE FOR VERIFYING THE LOCATION OF ANY BURIED FEATURES.
 3. WHERE REQUIRED, SUPPORT OF POWER POLES TO BE PAID FOR AND COORDINATE WITH C.A.S. BY THE CONTRACTOR.
 4. TREE REMOVAL AND/OR TRIMMING SHALL BE AS REQUIRED. TREE REMOVAL AND/OR TRIMMING SHALL BE PAID FOR BY THE CONTRACTOR.
 5. CONTRACTOR TO LAY FORCE MAIN AT UNIFORM GRADE WITHOUT ANY HIGH OR LOW POINTS EXCEPT AT DESIGNATED LOCATIONS.

- LEGEND**
- APPROX. LOCATION OF PROPERTY LINE
 - - - - - EXISTING CONTOUR
 - 100' --- EXISTING 5' CONTOUR
 - 98' --- PROPOSED 5' CONTOUR
 - 100' --- PROPOSED 5' CONTOUR
 - EXISTING OVERHEAD UTILITY LINES
 - EXISTING BURIED UTILITY LINES
 - EXISTING OVERTOP
 - EXISTING STORM SEWER
 - PROPOSED FORCE MAIN
 - EXISTING CATCH BASIN
 - EXISTING UTILITY POLE
 - EXISTING SIGN
 - EXISTING HYDRANT
 - RR CROSSING SIGNAL LIGHT
 - IRON P/N FOUND
 - EXISTING WELL
 - PROPOSED SEWER MANHOLE
 - --- MANHOLE

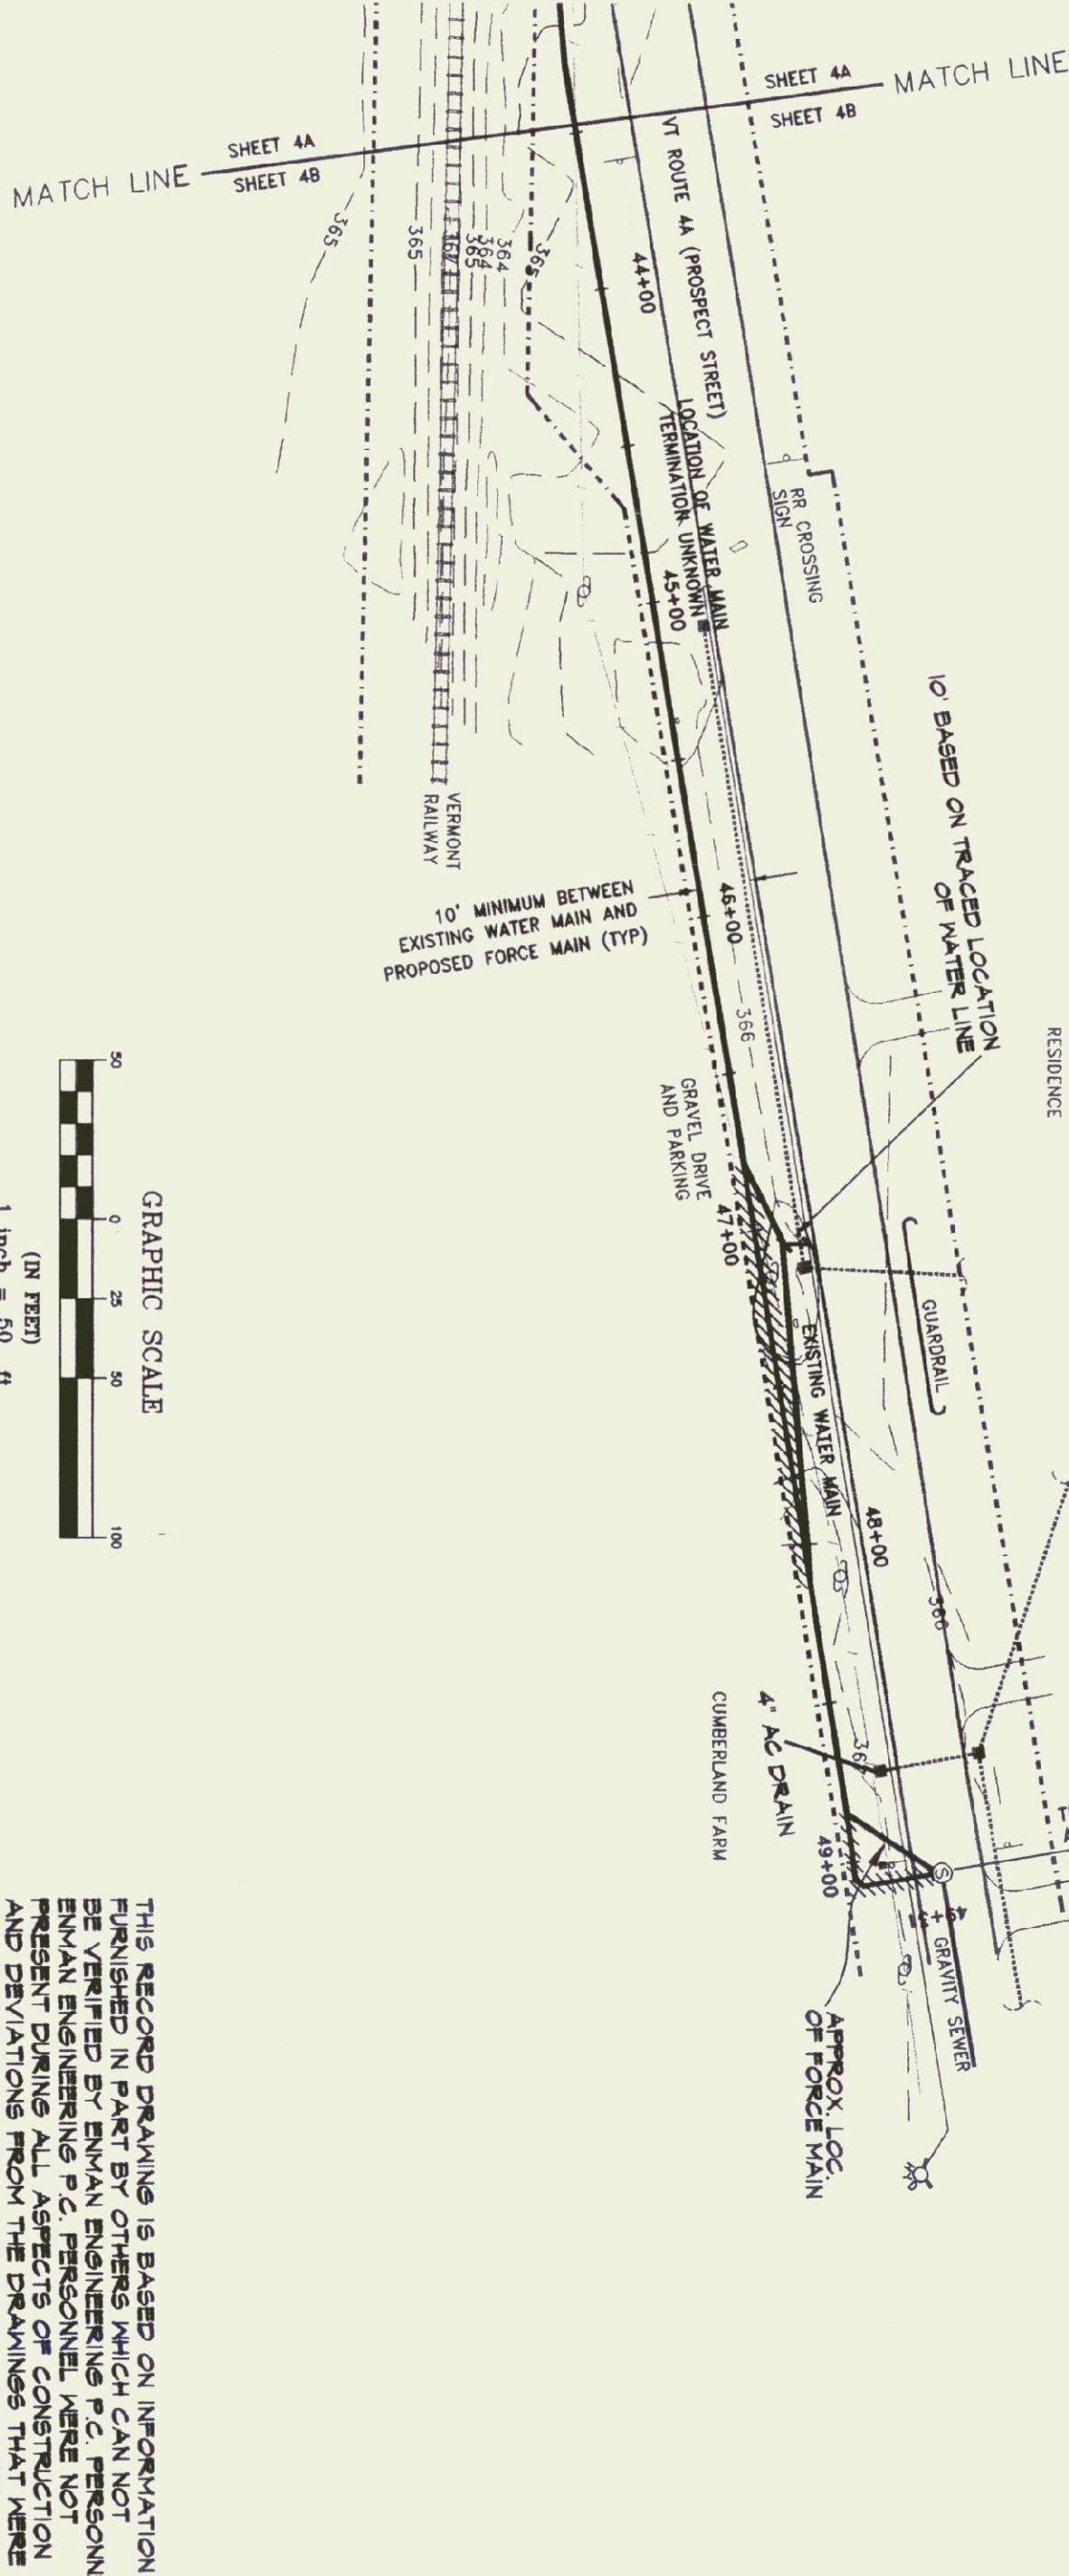

THIS RECORD DRAWING IS BASED ON INFORMATION FURNISHED IN PART BY OTHERS WHICH CAN NOT BE VERIFIED BY ENMAN ENGINEERING P.C. PERSONNEL. ENMAN ENGINEERING P.C. PERSONNEL WERE NOT PRESENT DURING ALL ASPECTS OF CONSTRUCTION AND DEVIATIONS FROM THE DRAWINGS THAT WERE MADE WHEN THE ENGINEER HAS NOT PRESENT ABOVE SHOULD BE INDICATED BY RECORD DATA AND FIELD MEASUREMENT IS RECOMMENDED.

NOTE: CONTRACTOR TO VERIFY WITH ALL THE CONDITIONS OBTAINED FOR CONSTRUCTION AND WITH ALL THE CONDITIONS RAILROAD R.O.W. (SEE SPECIFICATIONS FOR CONDITIONS AND REQUIREMENTS)

<p>REVISIONS:</p> <p>3/11/99 RELEASED TO TOWN OF FAIR HAVEN FOR REVIEW</p> <p>6/15/98 REBORTE FORCE MAIN MISC. NOTE EDITS</p> <p>6/26/98 ADD CLEANOUT LOCATIONS</p> <p>8/20/98 MISC. NOTE EDITS</p> <p>2/19/00 ADD RECORD INFORMATION</p>	
<p>RELEASED:</p> <p>APRIL 2000</p>	
<p>ISSUED FOR:</p> <p>RECORD DRAWINGS</p>	
<p>FAIR HAVEN</p> <p>WELCOME CENTER</p>	
<p>FAIRHAVEN, VERMONT</p> <p>THESE PLANS ARE FOR THE PROJECT ONLY AND ARE NOT TO BE USED FOR ANY OTHER PROJECT WITHOUT WRITTEN CONSENT OF ENMAN ENGINEERING, P.C.</p>	
<p>Enman Engineering</p> <p>Environmental • Civil • Sanitary</p> <p>22 North Main Street Fair Haven, Vermont 05701 (802)775-3437 Copyright © 1998 All rights reserved.</p>	
<p>THE CERTIFICATION ON THIS DRAWING ONLY INDICATES THE VT REGISTERED PROFESSIONAL ENGINEER RESPONSIBLE FOR PREPARATION AND IS NOT ISSUED FOR CONSTRUCTION UNLESS NOTED IN THE REVISION BOX.</p> <p>REGULATORY APPROVAL STAMP</p>	
<p>SEWER PLAN</p> <p>STA 29+50 TO STA 49+51</p> <p>RECORD DRAWING</p> <p>SCALE: AS NOTED</p> <p>DATE: 02/24/99</p> <p>DESIGN BY: BUE/TNT</p> <p>DRAWN BY: JBT/JPL</p> <p>SHEET NO: 4 OF 9</p> <p>PROJECT NO.: 9816</p>	