


SEWER PROFILE

SCALE: VERTICAL 1"=10'
HORIZONTAL 1"=50'

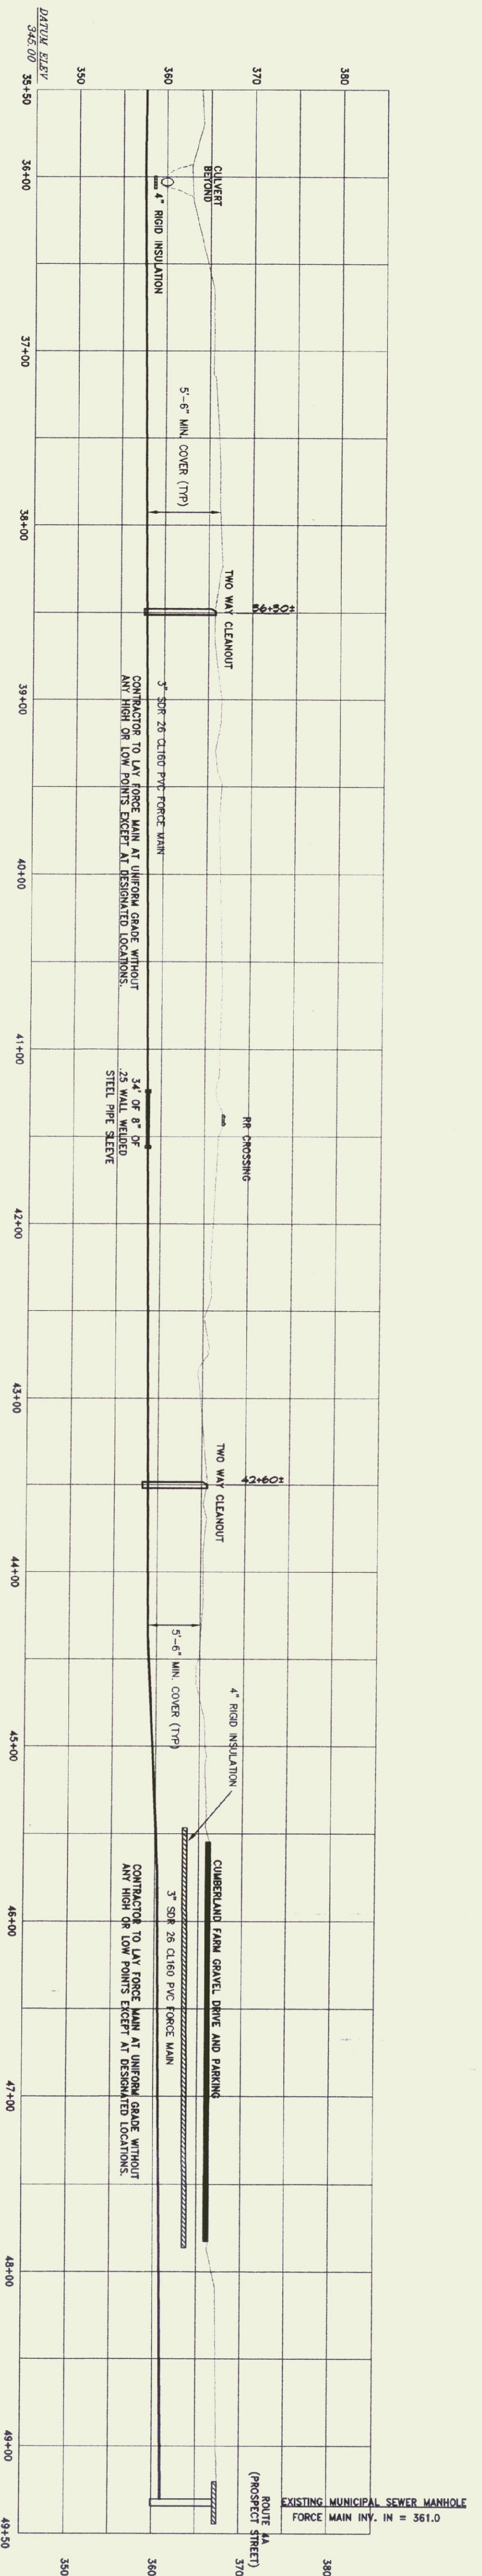

NOTE:
CONTRACTOR TO INSTALL RAIL ROAD CROSSING WITHOUT
CREATING A HIGH POINT IN FORCE MAIN

SEWER PROFILE

SCALE: VERTICAL 1"=10'
HORIZONTAL 1"=50'

THIS RECORD DRAWING IS BASED ON INFORMATION
FURNISHED IN PART BY OTHERS WHICH CAN NOT
BE VERIFIED BY ENMAN ENGINEERING P.C. PERSONNEL.
ENMAN ENGINEERING P.C. PERSONNEL WERE NOT
PRESENT DURING ALL ASPECTS OF CONSTRUCTION
AND DEVIATIONS FROM THE DRAWINGS THAT WERE
MADE AFTER THE ENGINEER WAS OF PRESENT
OPINION SHOULD BE INDICATED BY A NOTE ABOVE
GRADE INSTALLATION IS PICTORIAL AND FIELD
MEASUREMENT IS RECOMMENDED

REVISIONS:


3/11/99	ADDED BRIDGE BLOCK DETAIL
6/15/99	RELEASED TO TOWN OF FAIR HAVEN FOR REVIEW
7/02/99	ADJUSTED FORCE MAIN MISC. NOTE EDITS
7/02/99	ADD CLEANOUT LOCATIONS
8/20/99	MISC. PLAN EDITS
2/18/00	MISC. NOTE EDITS
2/18/00	ADD RECORD INFORMATION

RELEASED:
APRIL 2000
RELEASED FOR:
RECORD DRAWING

FAIR HAVEN
WELCOME CENTER

FAIRHAVEN, VERMONT
THESE PLANS ARE FOR THIS PROJECT ONLY AND
NOT BE USED FOR ANY OTHER PROJECT OR ANY
OTHER PURPOSE WITHOUT THE WRITTEN CONSENT OF
ENMAN ENGINEERING, P.C.

Enman
Engineering
Environmental • Civil • Sanitary
230 North Main Street
Rutland, Vermont 05701
(802)775-4447
Copyright © 1999
All rights reserved.

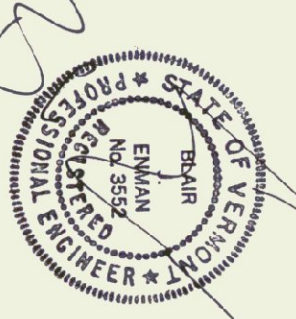

THE CERTIFICATION ON THIS DRAWING ONLY
INDICATES THE V.T. REGISTERED PROFESSIONAL
ENGINEER RESPONSIBLE FOR PREPARATION AND
IS NOT ISSUED FOR CONSTRUCTION UNLESS
NOTED IN THE REVISION BOX.
REGULATORY APPROVAL STAMP

SEWER
PROFILES

RECORD DRAWING

SCALE: AS NOTED
DATE: 02/24/99
DESIGN BY: BJE/TNT
DRAWN BY: JBT/JPL
SHEET NO: 6 OF 9
PROJECT NO: 9816