


State of Vermont  
 Agency of Transportation

# LYNDON REST AREA

In the Town of Lyndon on I-91 Southbound

Project consists of renovations to the existing facility incorporating ADA compliance, energy and security enhancement and associated site work.

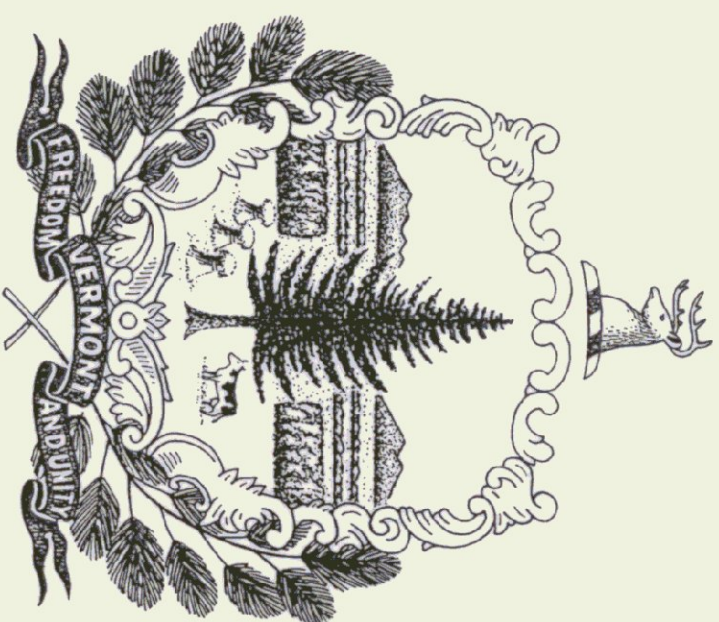

Howard Dean, M.D.  
 Governor

Agency of Transportation  
 133 State Street  
 Montpelier, Vermont 05602  
 Glenn M. Gershaneck, Secretary


As Built 11/96

Agency of Administration  
 Department of State Buildings  
 2 Governor Aiken Avenue  
 Montpelier, Vermont 05602  
 John J. Zampieri, Commissioner

Index of Sheets

1	Title Sheet
2	Quantities
3	Symbols/Legends/Notes
4	Site Plan
5	Floor Plan
6	Elevations
7	Vestibule
8	Framing/Reflected Ceiling Plan
9	Interior Elevations
10	Door & Window Details
11	Miscellaneous Details
12	Signs
13	Miscellaneous Detail
14	HVAC Demolition Plan
15	HVAC Demolition and Renovation Plans
16	Electrical - Existing Conditions and Renovations
17	Electrical - Schedules, Legends and Details
18	Highway Signage Schematic
19	A.O.T. - Ramp Closure
20	A.O.T. - Traffic Sign Summary
21	A.O.T. - Sign Layout

10	A.O.T. - STANDARDS
11	C-1 Granite Slope Edging, Verticle Granite Curb, Precast Reinforced Concrete Curb, Cast in Place Concrete Curb, Bituminous Concrete Curb, Treated Timber Curb
12	11-16-92R
13	C-3 Sidewalk Ramps
14	9-15-93R
15	E-105 Traffic Control for Construction Vehicle U-Turns on Divided Highways
16	9-20-93
17	E-106 Traffic Control Miscellaneous Details
18	9-20-93R
19	E-107 Delineation, Barricades And Detours for Construction Areas
20	9-20-93R
21	E-107 A Breakaway Barrier Details
22	9-20-93R
23	E-160 Flanged Channel Steel Sign Post
24	10-21-92R
25	E-191 Pavement Marking Details
26	1-23-89R

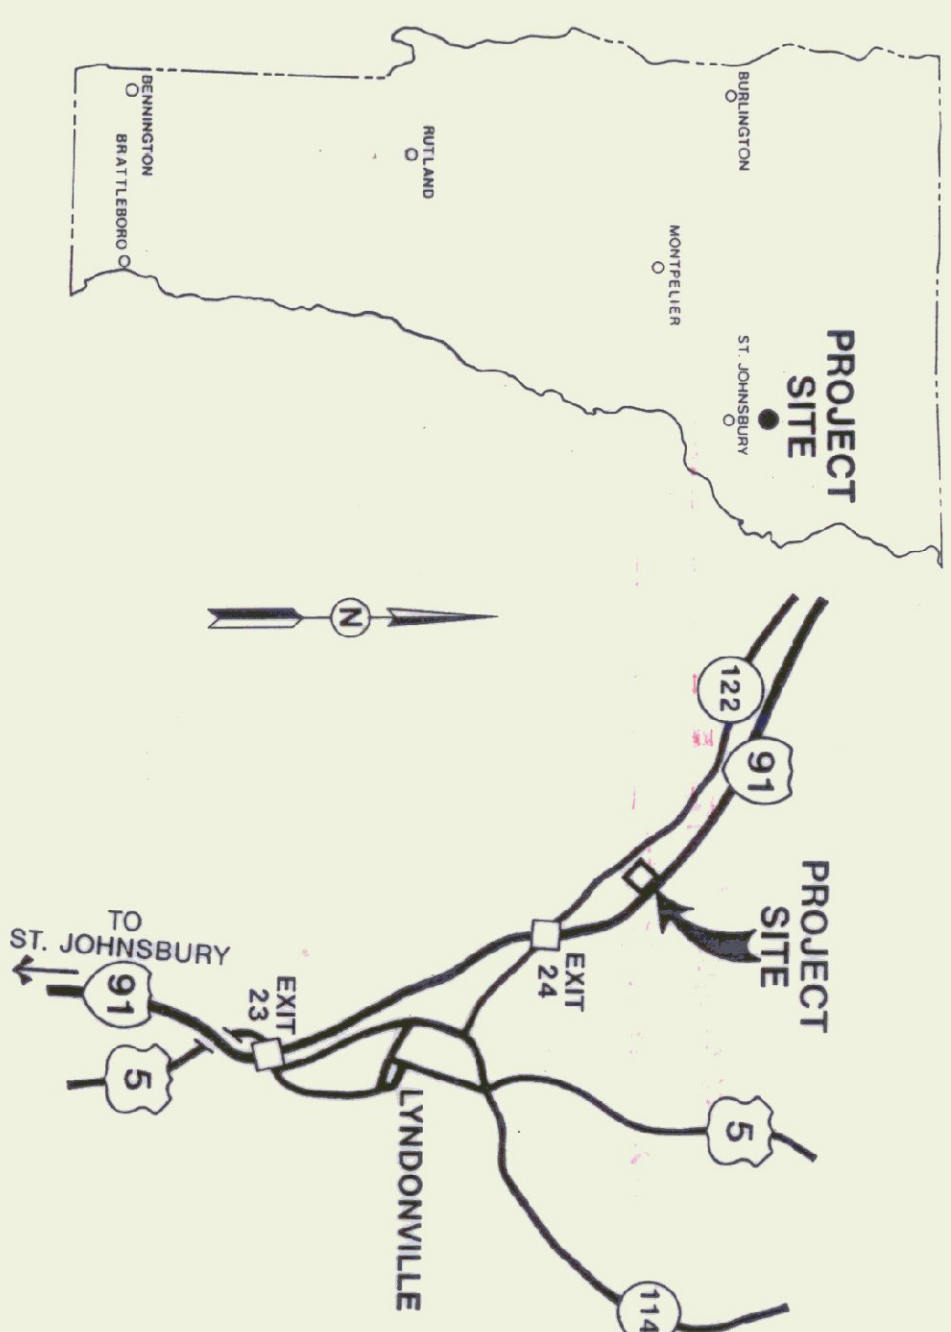

Project Location

THESE PLANS ARE SUBJECT TO SUCH ENGINEERING CHANGES AS MAY BE REQUIRED BY THE FEDERAL HIGHWAY ADMINISTRATION OR THE DIRECTOR OF CONSTRUCTION TO BE CARRIED ON IN ACCORDANCE WITH THESE PLANS AND THE STANDARD SPECIFICATIONS FOR CONSTRUCTION DATED 1990, AS APPROVED BY THE FEDERAL HIGHWAY ADMINISTRATION ON MARCH 15, 1990 FOR USE ON THIS PROJECT, INCLUDING ALL SUBSEQUENT REVISIONS AND SUCH REVISED SPECIFICATIONS AND STANDARD PROVISIONS AS ARE INCORPORATED IN THESE PLANS.

APPROVED	DATE
DIRECTOR OF CONSTRUCTION & MAINTENANCE	
DEPARTMENT OF TRANSPORTATION	
FEDERAL HIGHWAY ADMINISTRATION	
APPROVED	DATE
PER DIVISION ADMINISTRATOR	3-22-96
PROJECT LYNDON I-91-81D5(2)	
SHEET 1 OF 29 SHEETS	