


ELECTRICAL FLOOR PLAN - EXISTING CONDITIONS
SCALE: 1/4" = 1'-0"

- NOTES:
1. THE ELECTRICAL CONTRACTOR SHALL COORDINATE WITH THE OWNER BEFORE INSTALLING TELEPHONE OUTLET BOXES AND CONDUIT TO THE RESTROOMS. THESE HEIGHTS MAY VARY DEPENDING ON THE EQUIPMENT PURCHASED BY THE OWNER AND THE INDIVIDUAL TYPE AND ADA REQUIREMENTS OF EACH PHONE LOCATION. THE OWNER SHALL INFORM THE ELECTRICAL CONTRACTOR IN A TIMELY MANNER TO AVOID ANY WORK STOPPAGES OR DELAYS AS TO THE EXACT CHARACTERISTICS OF THE EQUIPMENT TO BE USED.
 2. THE ELECTRICAL CONTRACTOR SHALL DISCONNECT ONE ELECTRIC BASE-BOARD HEATER IN THE LOBBY AREA.
 3. THE ELECTRICAL CONTRACTOR SHALL REMOVE ALL ABANDONED WIRING AND CONDUIT TO THESE UNDER WHEREVER POSSIBLE. FIELD VERIFY. SEE DRAWING HV-1 FOR ELECTRIC HEATER LOCATION. ELECTRIC HEAT IN EXISTING MEN'S AND WOMEN'S ROOMS TO REMAIN IN PLACE.
 4. CONTRACTOR SHALL BE RESPONSIBLE FOR THE REMOVAL OF THE DISCONNECTED ELECTRIC BASEBOARD RADIATION.
 5. ALL NEW AND RELOCATED CONDUIT AND WIRING SHALL BE RUN CONCEALED, WHERE NOT POSSIBLE, COORDINATE WITH THE ARCHITECT AND ENGINEER BEFORE INSTALLATION.
 6. PROVIDE POWER WIRING, CONDUIT AND CONNECTION TO NEW GAS FIRED FURNACE. PROVIDE NEW 20AMP SINGLE POLE BREAKER IN PANEL IN ABANDONED ELECTRIC FURNACE BREAKER POSITION. PROVIDE WIRING AND CONDUIT TO SERVICE NEW FURNACE, CONTROL POWER SUPPLY, AND NEW WALL MOUNTED TEMPERATURE CONTROL TIMECLOCK. POWER WIRING ONLY. ALL TEMPERATURE CONTROL WIRING BY HV CONTRACTOR. SEE SPEC. PROVIDE POWER WIRING, CONDUIT AND CONNECTION TO NEW GAS FIRED HOT WATER HEATER. PROVIDE NEW 20AMP SINGLE POLE BREAKER IN PANEL UNDER HEATER. PROVIDE NEW 20AMP SINGLE POLE BREAKER IN PANEL UNDER HEATER. PROVIDE NEW 20AMP SINGLE POLE BREAKER IN PANEL UNDER HEATER. PROVIDE NEW 20AMP SINGLE POLE BREAKER IN PANEL UNDER HEATER.

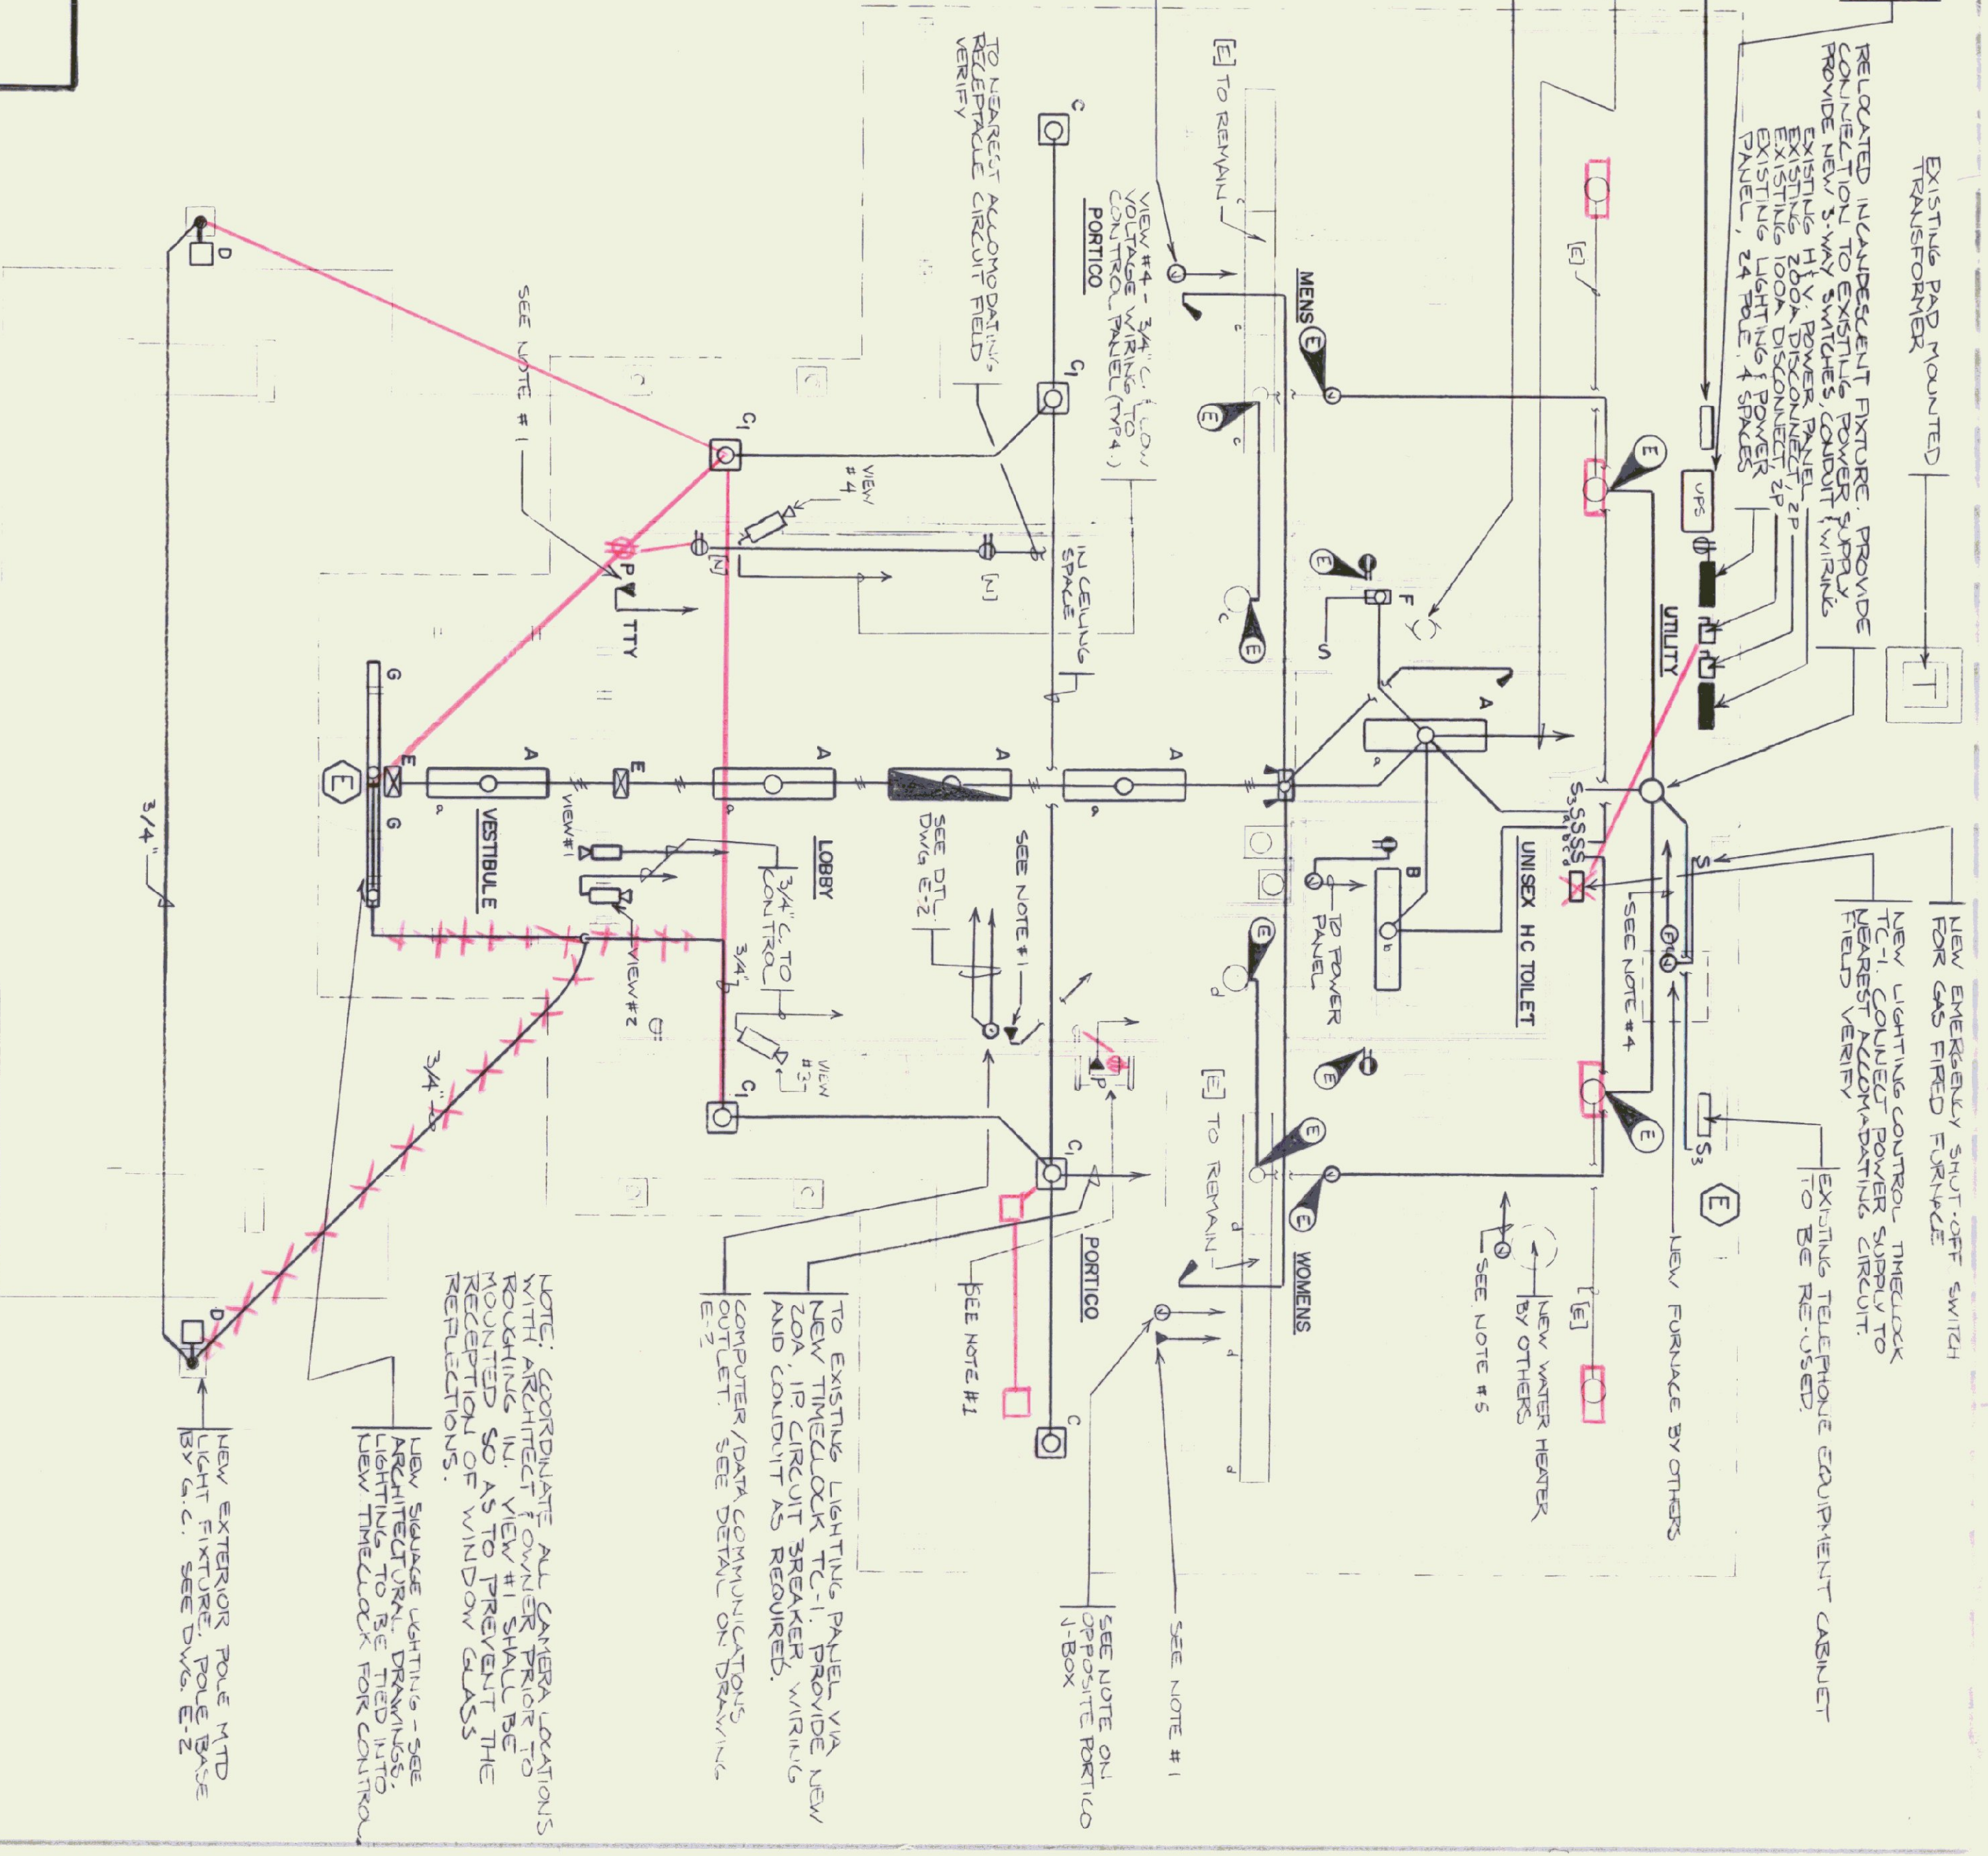

ELECTRICAL FLOOR PLAN - RENOVATIONS
SCALE: 1/4" = 1'-0"

STATE OF VERMONT DEPARTMENT OF STATE BUILDINGS AGENCY OF ADMINISTRATION MONTPELIER, VERMONT	
REST AREA REHABILITATION J-1-B1062	
LYNDON I-91 SOUTHBOUND	
ELECTRICAL - FLOOR PLAN - EXISTING CONDITIONS & RENOVATIONS	
DATE: 6-9-95	SCALE: 1/4" = 1'-0"
DRAWN BY: GN	REVISED: DRAWING NO. E-1
APPROVED BY: GAN	SHEET 16 OF 29
ELECTRICAL	