

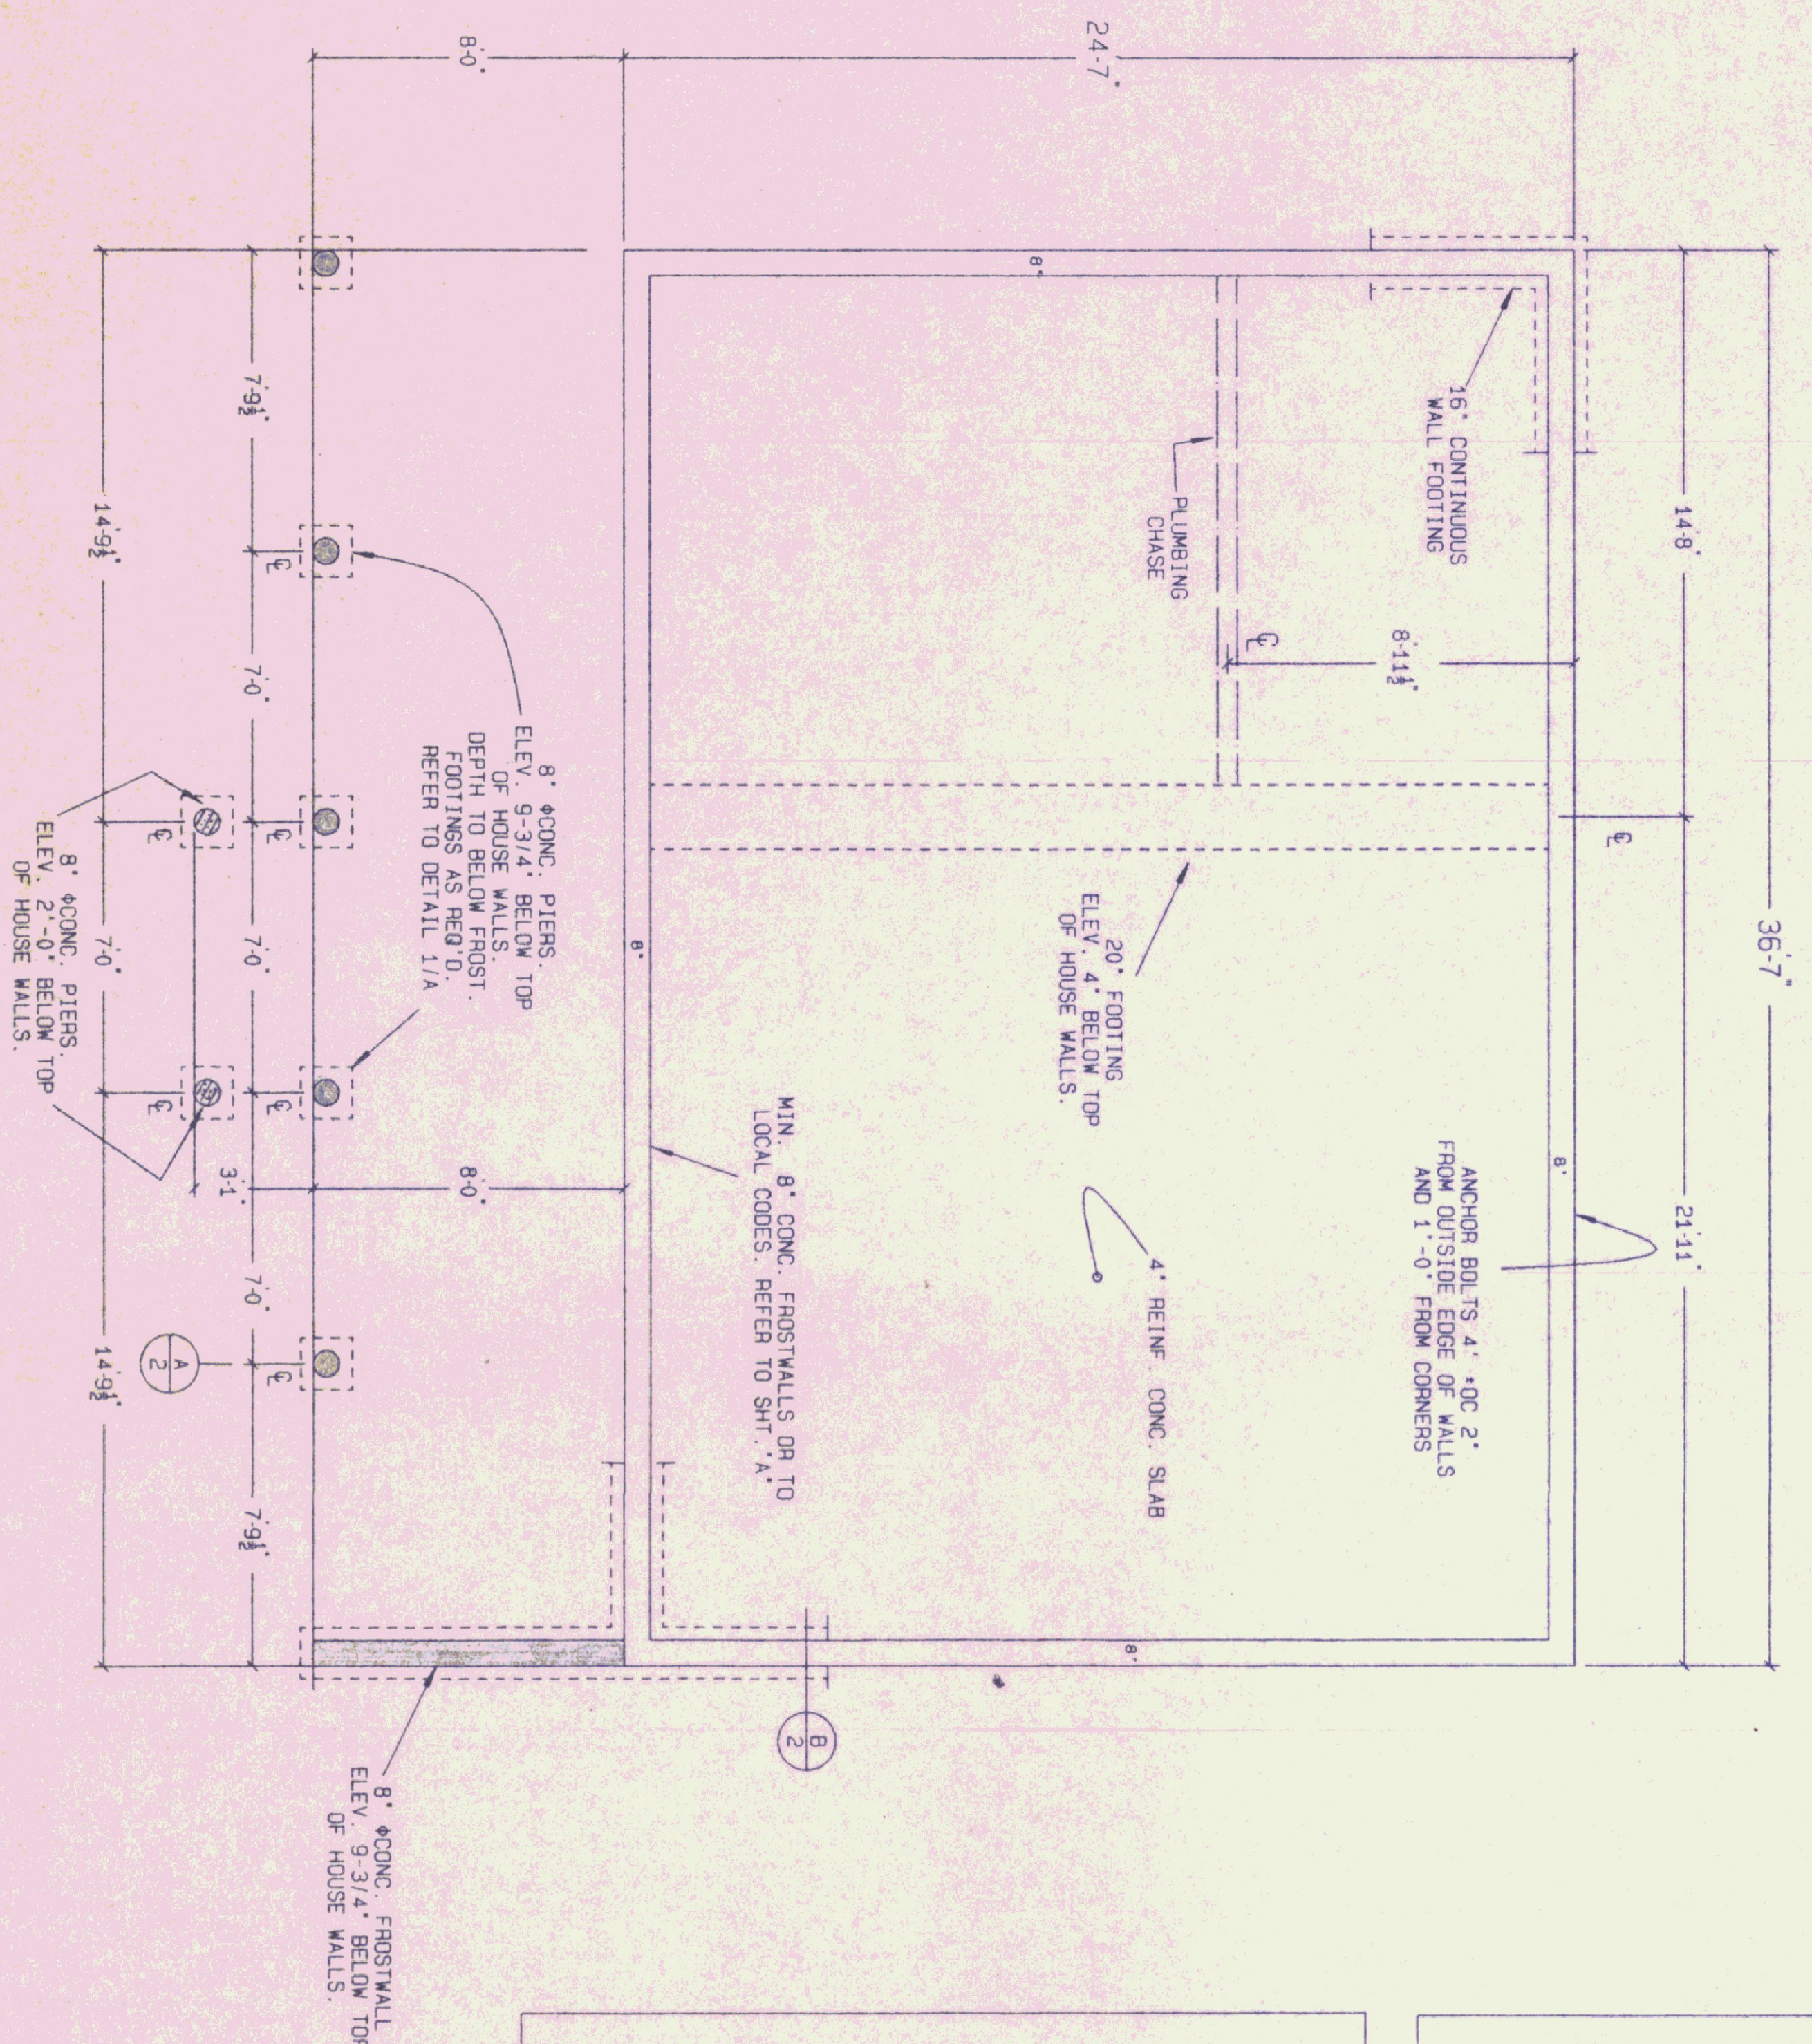


COORDINATED BY	
DATE	
SCALE	

GENERAL NOTES:

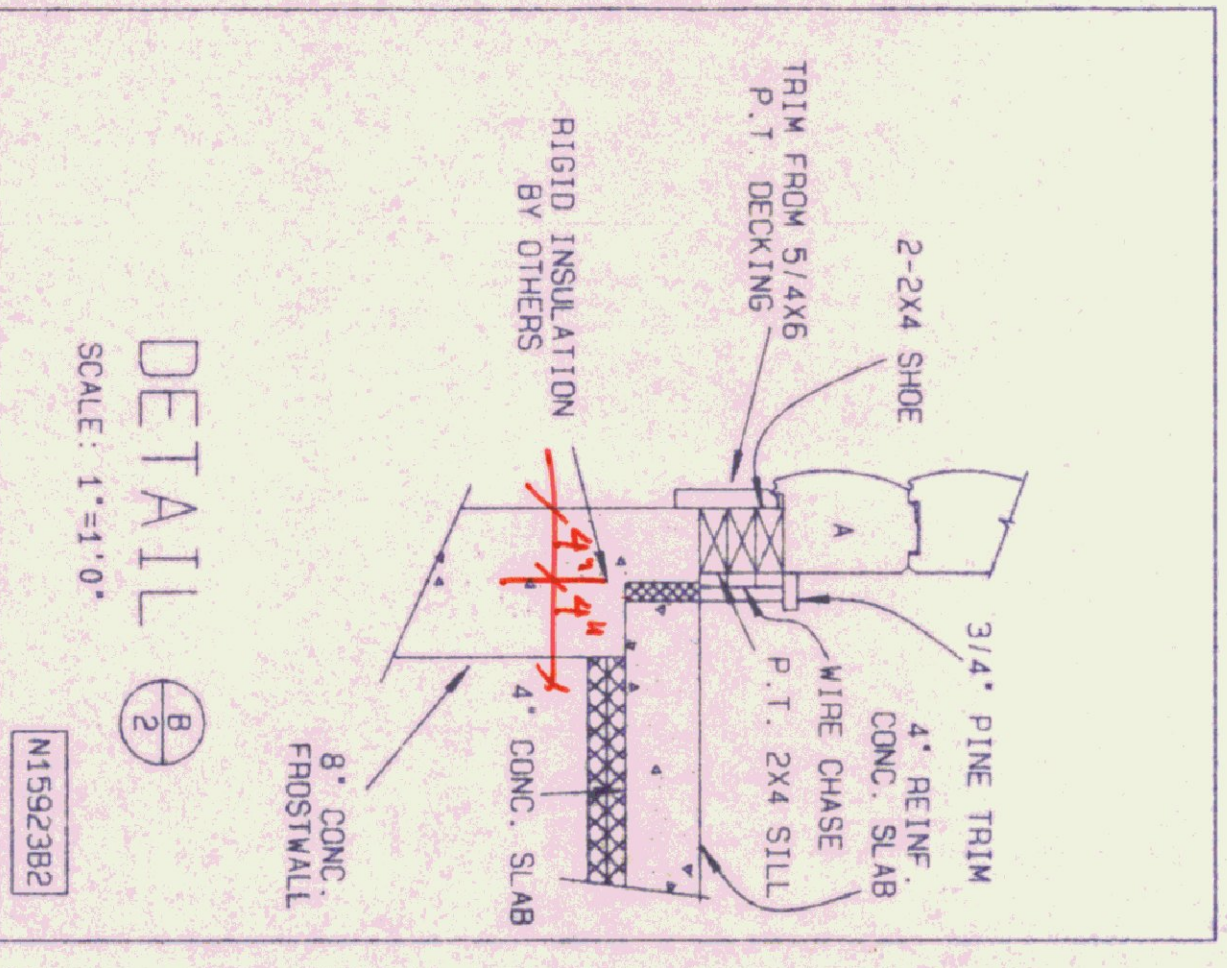

FOUNDATION PLAN

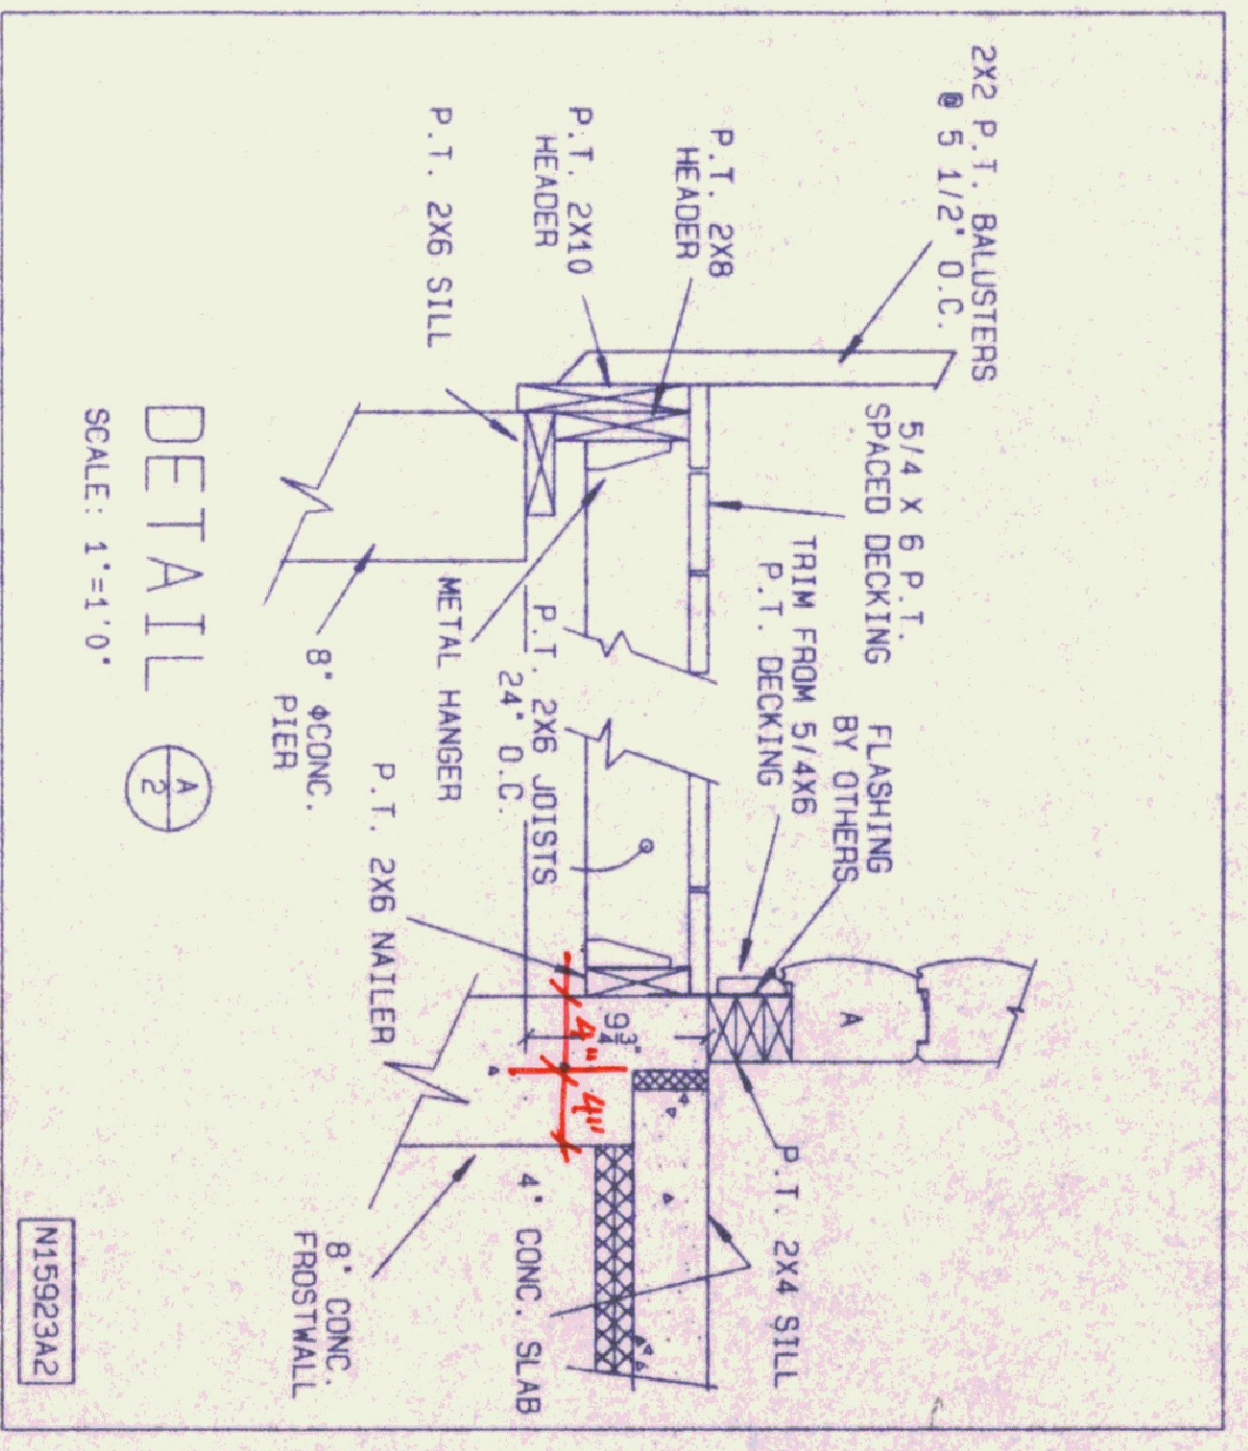

NO.	REVISION	DATE	BY	CHK.
5	FOUNDATION CHANGE	9-27	ZR	SP
WINDOWS				
DRN. NO.	SM	00083		
PROJECT NAME	NECCO INC. / ALBURG WELCOME CENTER			
DATE	8-9-94	PLAN NO.	NE-15923	SHEET NO.
SCALE	1/4" = 1'-0"			2



© 1995 by N.L.H. Inc.

M15923B2

M15923A2