


NOTES
 1. A concrete pad of sufficient size for at least a 50 KVA pad-mount transformer will be supplied by the contractor.
 2. 1/2" steel conduit sweep bends, thru the concrete pad will be installed by the contractor.

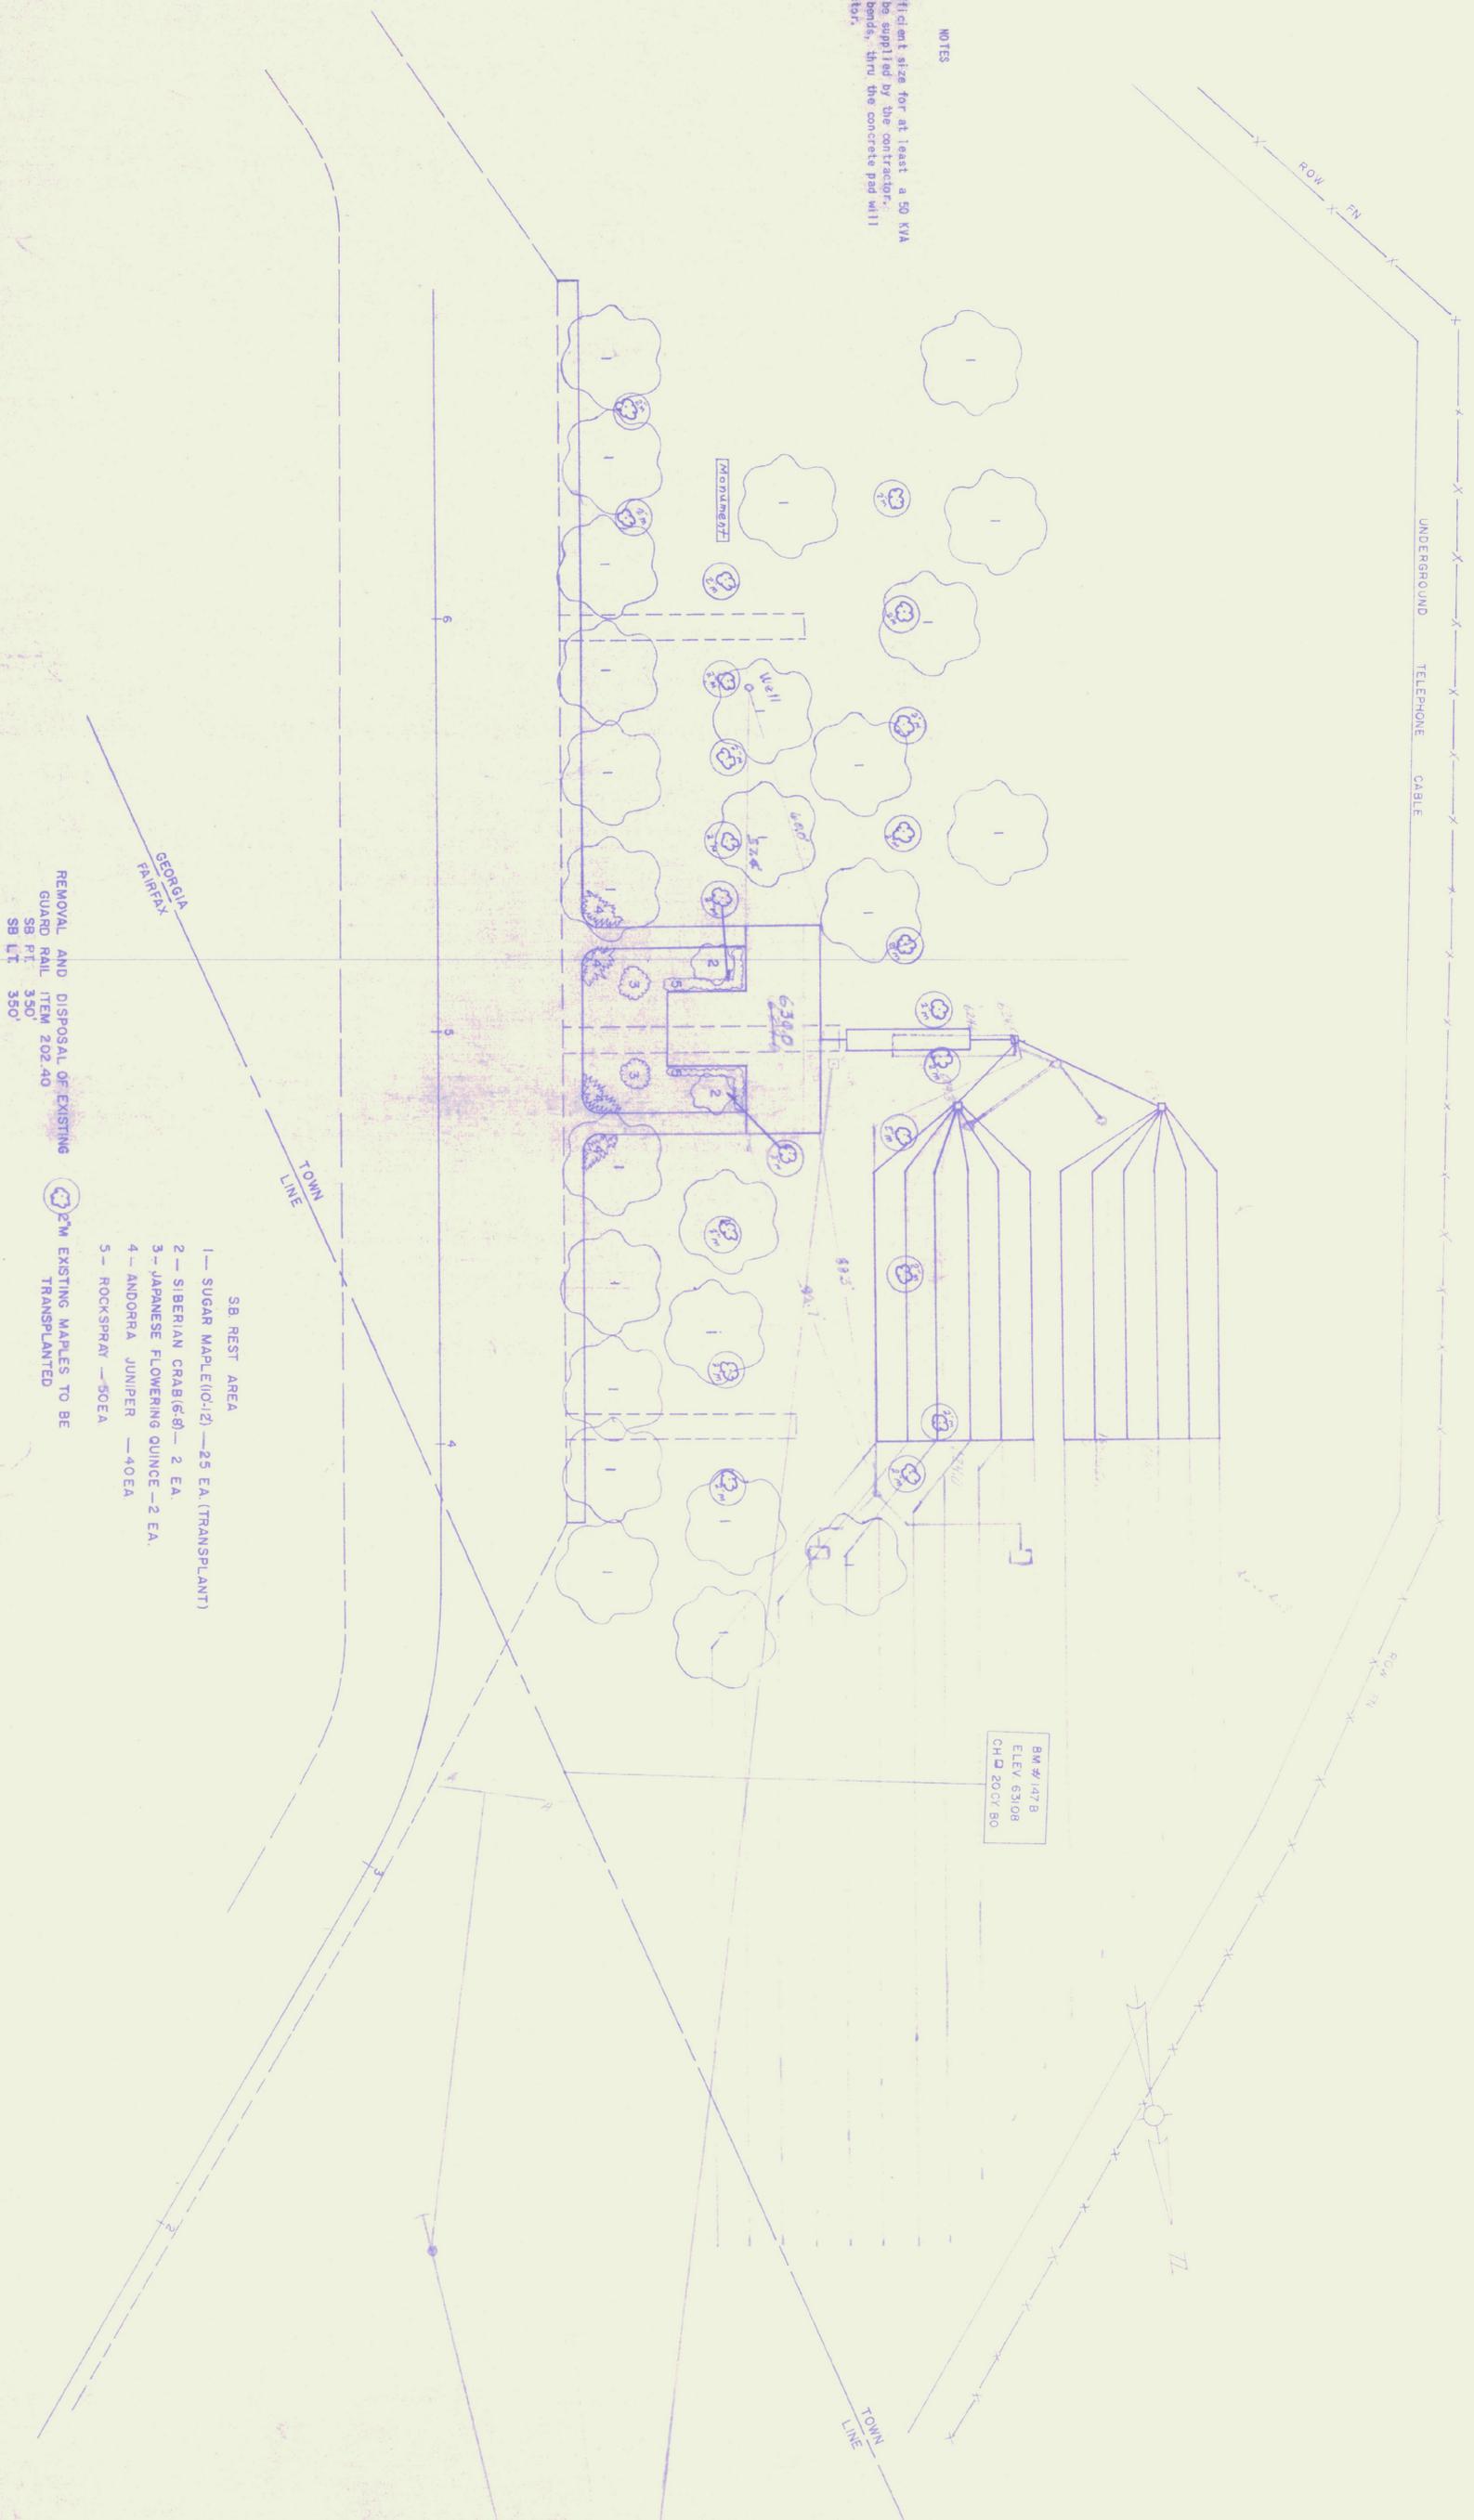

REMOVAL AND DISPOSAL OF EXISTING
 GUARD RAIL ITEM Z02.40
 SB PT 350'
 SB LT 350'

EXISTING MAPLES TO BE
 TRANSPLANTED

- SB REST AREA
- 1 - SUGAR MAPLE (10:12) - 25 EA. (TRANSPLANT)
 - 2 - SIBERIAN CRAB (6:8) - 2 EA.
 - 3 - JAPANESE FLOWERING QUINCE - 2 EA.
 - 4 - ANDORRA JUNIPER - 40 EA.
 - 5 - ROCKSPRAY - 50 EA.

GEORGIA
 FAIRFAX

TOWN
 LINE

TOWN
 LINE

BM #1478
 ELEV. 63.08
 CH 200 CY BO

SOUTHBOUND REST AREA

SURVEYED BY _____ DATE _____
 DRAWN BY _____ DATE _____
 TRACED BY _____ DATE 04/11/20/07/1
 GEORGIA - FAIRFAX
 PROJ. I NO. 89-31501
 SHEET 5 OF 35

SCALE 1"=20'