


NEW SEWER LINE AND RENOVATIONS TO THE I-89 GEORGIA NORTH BOUND AND SOUTH BOUND REST AREAS

Federal Project No. IM 089-3 (30)

AUGUST 21, 1998

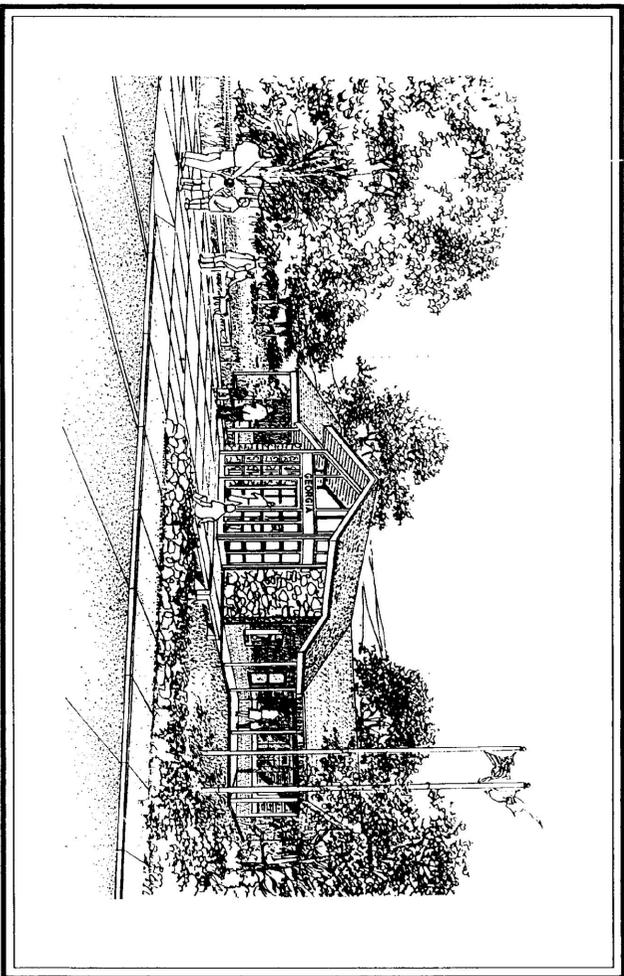

PROJECT CONSISTS OF RENOVATIONS TO THE EXISTING FACILITY INCORPORATING ADA COMPLIANCE, ENERGY AND SECURITY ENHANCEMENTS, A FORCED MAIN SEWER LINE AND ASSOCIATED SITE WORK

ARCHITECT:
DORE AND WHITTIER INC.
ARCHITECTS • PROJECT MANAGERS
1795 WILLISTON ROAD • SOUTH BURLINGTON • VERMONT
(802)863-1428

MECH./ELEC./PLUMB.:
N.F. LAURENCE & ASSOCIATES
113 WEST MAIN STREET • NORTHBOROUGH • MASSACHUSETTS
(508)393-6412


CIVIL ENGINEERING:
CROSS CONSULTING ENGINEERING
228 NORTH MAIN STREET • ST. ALBANS • VERMONT
(802)524-2113

STATE OF VERMONT
AGENCY OF ADMINISTRATION
DEPARTMENT OF BUILDINGS AND GENERAL SERVICES
TWO GOVERNOR AIKEN AVENUE, DRAWER 33
MONTPELIER, VERMONT 05633-5801
(802) 828 3314

FHWA: *Maud S. Rickett*
for ADMINISTRATOR

GOVERNOR:
HOWARD DEAN, M.D.

COMMISSIONER:
THOMAS W. TORFI

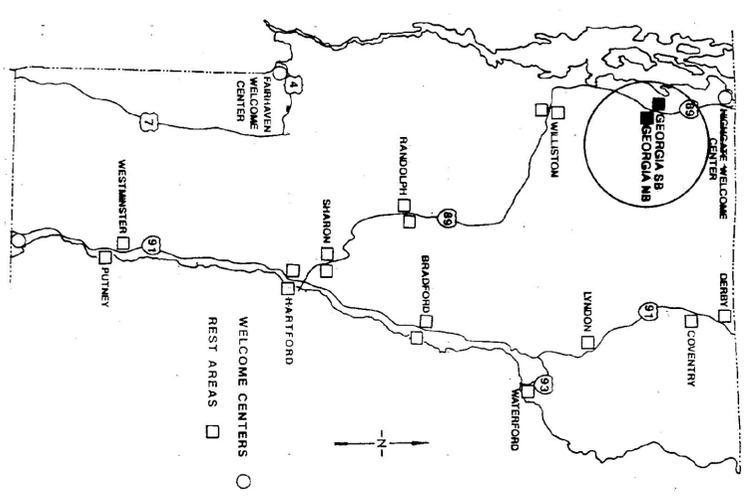

PROJECT LOCATION

THESE PLANS ARE SUBJECT TO SUCH ENGINEERING CHANGES AS MAY BE REQUIRED BY THE FEDERAL HIGHWAY ADMINISTRATION OR THE DIRECTOR OF CONSTRUCTION AND MAINTENANCE. CONSTRUCTION IS TO BE CARRIED ON IN ACCORDANCE WITH THESE PLANS AND THE STANDARD SPECIFICATIONS FOR CONSTRUCTION DATED 1990. AS APPROVED BY THE FEDERAL HIGHWAY ADMINISTRATION ON MARCH 16, 1990 FOR USE ON THIS PROJECT. INCLUDING ALL SUBSEQUENT REVISIONS AND SUCH REVISED SPECIFICATIONS AND SPECIAL PROVISION AS ARE INCORPORATED IN THESE PLANS.

DRAWINGS LIST

- 8-1-0 NORTHBOUND DEMOLITION PLAN
- 8-1-1 NORTHBOUND SITE PLAN
- 8-1-2 NORTHBOUND LANDSCAPING PLAN
- 8-1-3 DETAILS
- 8-1-4 SOUTHBOUND DEMOLITION PLAN
- 8-2-0 SOUTHBOUND SITE PLAN
- 8-2-2 SOUTHBOUND LANDSCAPING PLAN
- 8-3-0 PLAN AND PROFILE
- 8-3-1 PLAN AND PROFILE
- 8-3-2 PLAN AND PROFILE
- 8-3-3 PLAN AND PROFILE
- 8-3-4 PLAN AND PROFILE
- 8-3-5 PLAN AND PROFILE
- 8-3-6 TRAFFIC CONTROL SIGNAGE
- 8-3-7 DETAILS
- 4-1-0 SYMBOLS / LEGEND AND NOTES
- 4-1-1 NORTHBOUND BUILDING ELEVATIONS
- 4-2-0 NORTHBOUND BUILDING PLAN
- 4-2-1 SOUTHBOUND BUILDING ELEVATIONS
- 4-3-0 BUILDING VESTIBULE
- 4-3-1 WOOD FRAME / REFLECT. CGE PLAN
- 4-3-2 INTERIOR ELEVATIONS
- 4-3-3 FOLDING TABLE / DOOR AND WINDOW SCHED.
- 4-3-4 MISCELLANEOUS DETAILS
- 4-3-5 MISCELLANEOUS DETAILS
- 4-3-6 SIGNS
- P-1-0 NORTHBOUND PLUMBING PLANS
- P-1-1 NORTHBOUND HEATING & VENTILATING PLANS / LEGEND
- P-1-2 NORTHBOUND ELECTRICAL PLANS
- P-2-0 SOUTHBOUND PLUMBING PLANS
- P-2-1 SOUTHBOUND HEATING AND VENTILATING PLANS
- P-2-2 SOUTHBOUND ELECTRICAL FLOOR PLANS
- P-3-0 PLUMBING LEGEND / DETAILS
- E-3-0 ELECTRICAL LEGEND / DETAILS
- TEC-1 TEMPORARY RAMP CLOSURE
- E-100 CONSTRUCTION APPROACH SIGNS
- E-106 TRAFFIC CONTROL MISCELLANEOUS DETAILS
- E-132 GENERAL MOTORIST SERVICES SIGN DETAILS
- E-142 REGULATORY SIGN DETAILS
- E-143 REGULATORY SIGN DETAILS
- E-144 REGULATORY SIGN DETAILS
- E-160 FLANGED CHANNEL STEEL SIGN POST
- E-164 PRELIMINARY SQUARE STEEL SIGN POST
- E-191 PAYMENT MARKING DETAILS
- E-193 PAYMENT MARKING DETAILS

AS BUILT
DATE: 7/21/99

BID SET