
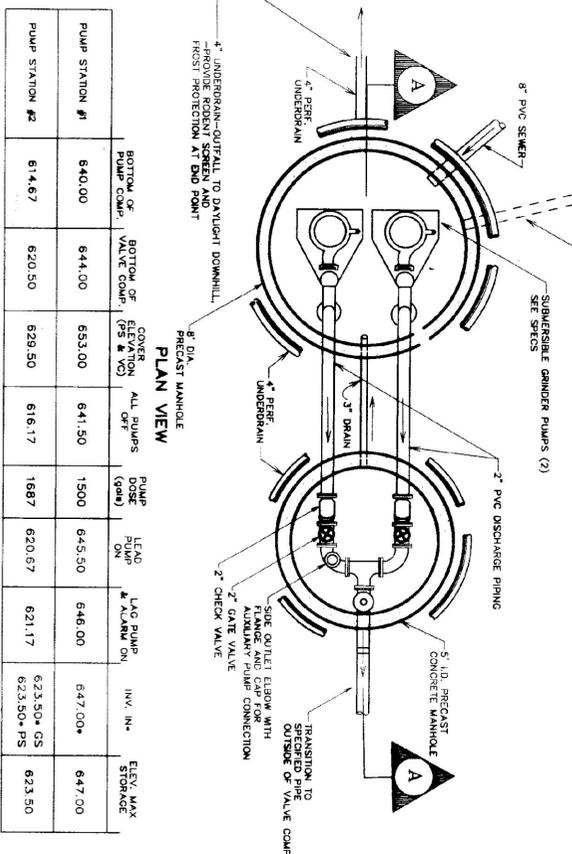



NOTE: CONTROL PANEL TO BE MOUNTED INSIDE BUILDING - SEE ELECTRICAL DRAWINGS

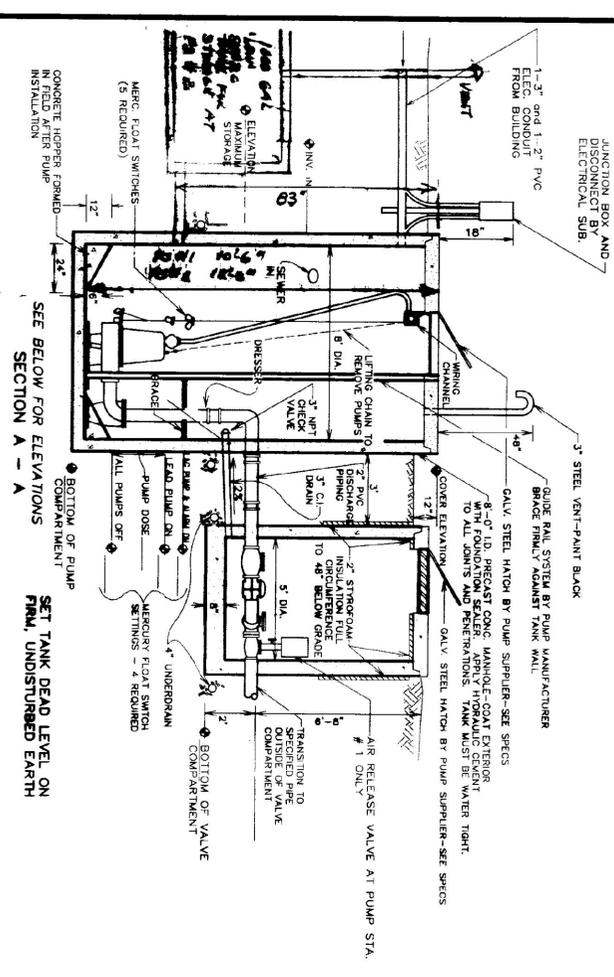


PUMP STATION #	BOTTOM OF PUMP COMP. VALVE COMB.	COVER ELEVATION ALL PUMPS (PS & VD)	PUMP LEAD ON	LAG PUMP & ALUMINUM ON	INV. IN- STORAGE	ELEV. MAX STORAGE
614.67	620.50	629.50	616.17	1687	620.67	621.17
640.00	644.00	653.00	641.50	1500	645.50	646.00
					647.00*	647.00
					623.50+GS	623.50+GS
					623.50+PS	623.50

1 WASTEWATER PUMP STATIONS #1 & #2

NOT TO SCALE

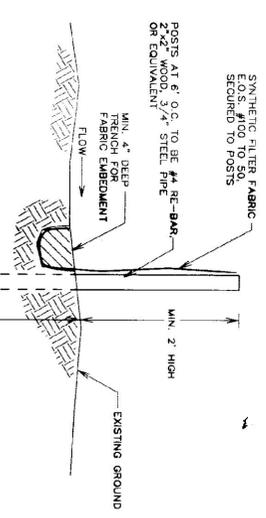


8 SILT FENCE

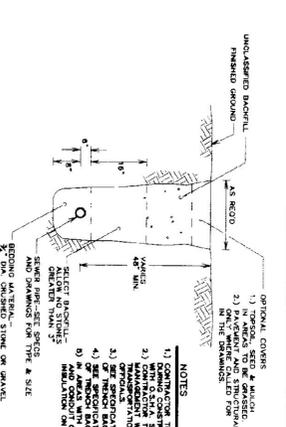


2 PRESSURE SEWER TRENCH

NOT TO SCALE

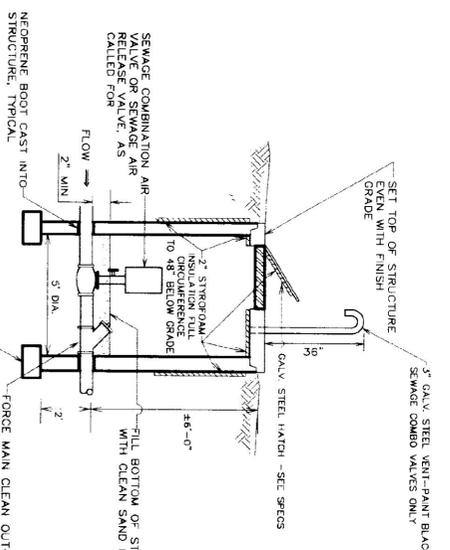


4 SEWAGE COMBO & SEWAGE AIR RELEASE VALVES

NOT TO SCALE

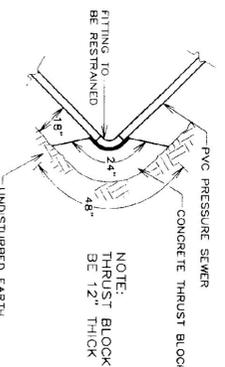


11 FORCE MAIN THRUST RESTRAINT

NOT TO SCALE

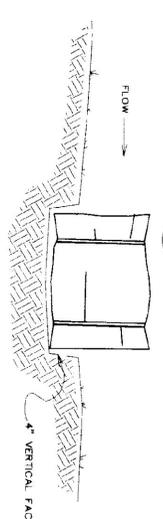


9 HAY BALE DAM

NOT TO SCALE

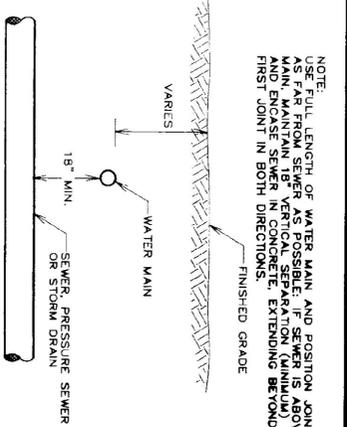


3 WATER/SEWER CROSSING

NOT TO SCALE

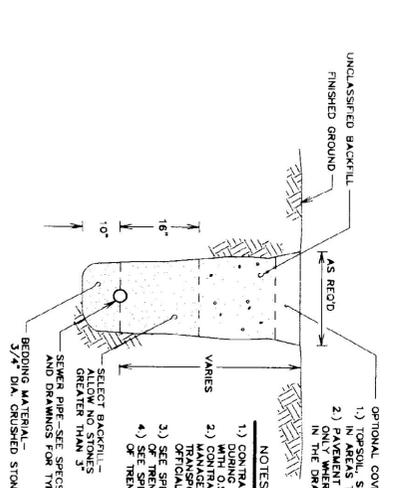


6 GRAVITY SEWER TRENCH

NOT TO SCALE

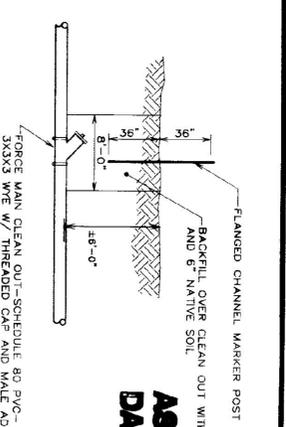


5 FORCE MAIN CLEAN OUT

NOT TO SCALE

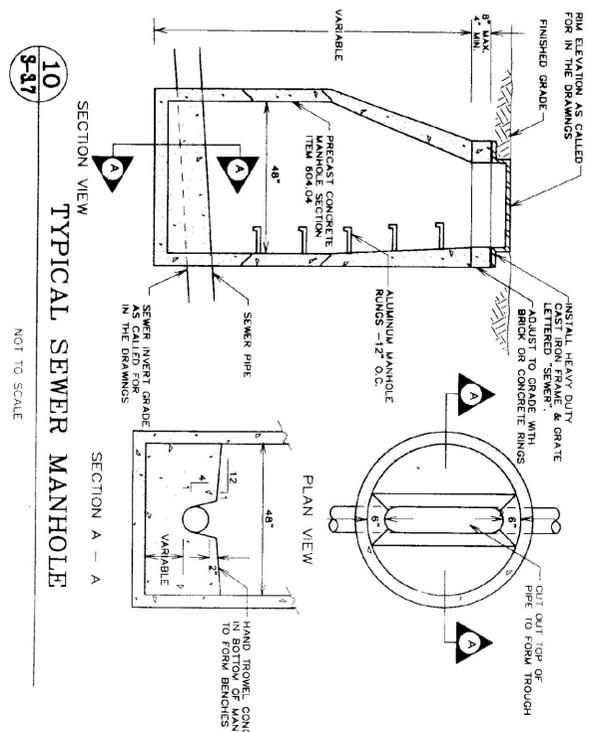

10 TYPICAL SEWER MANHOLE

NOT TO SCALE

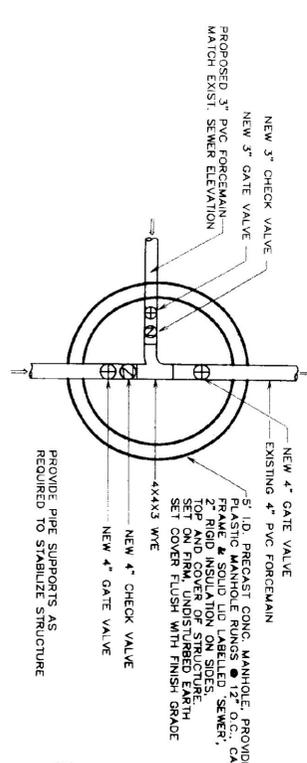

7 PRESSURE SEWER CONNECTION DETAIL

NOT TO SCALE

AS BUILT
DATE: 12/1/89

STATE OF VERMONT
DEPARTMENT OF BUILDINGS
AND GENERAL SERVICES
AGENCY OF ADMINISTRATION
MONTPELIER, VERMONT

GEORGIA INTERSTATE 89 REST AREAS
NORTHBOUND AND SOUTHBOUND

DATE:	21 AUGUST 1988	SCALE:	AS NOTED	REVISIONS:	8/22/88 - DET 2	DRAWING TITLE:	DETAILS
DRAWN BY:	HW/ED	PROJECT NO.:	97041	CHECKED BY:	PJC	DRAWING NO.:	S-37