



1 SECTION A-A
SCALE: 1/4" = 1'

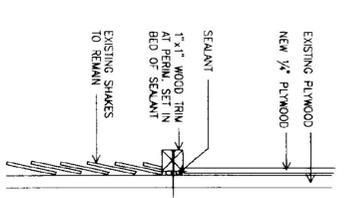


6 PANEL TRIM DETAIL
SCALE: N.T.S.


- EXTERIOR GENERAL NOTES:**
1. AREA OF SHAKES HIGHLIGHTED ARE FOR REFERENCE ONLY. CONTRACTOR SHALL FIELD VERIFY TO DETERMINE THE EXTENT OF SHAKE REPLACEMENT.
 2. WHERE SHAKES ARE BEING REPLACED, CONTRACTOR SHALL VERIFY INTEGRITY OF EXISTING BUILDING PAPER AND REPLACE IF NECESSARY.
 3. AT ROOF REPLACEMENT CONTRACTOR SHALL PROVIDE NEW 30LB BUILDING FELT, NEW FASCIA, DRIP EDGE WHERE APPLICABLE AND ICE AND WATER SHIELD AT ALL VALLEYS, EAVES AND AS SHOWN ON DRAWINGS. ICE AND WATER SHIELD AT ALL EAVES SHALL EXTEND FROM EAVE EDGE TO 3' BEYOND EXTERIOR WALL.

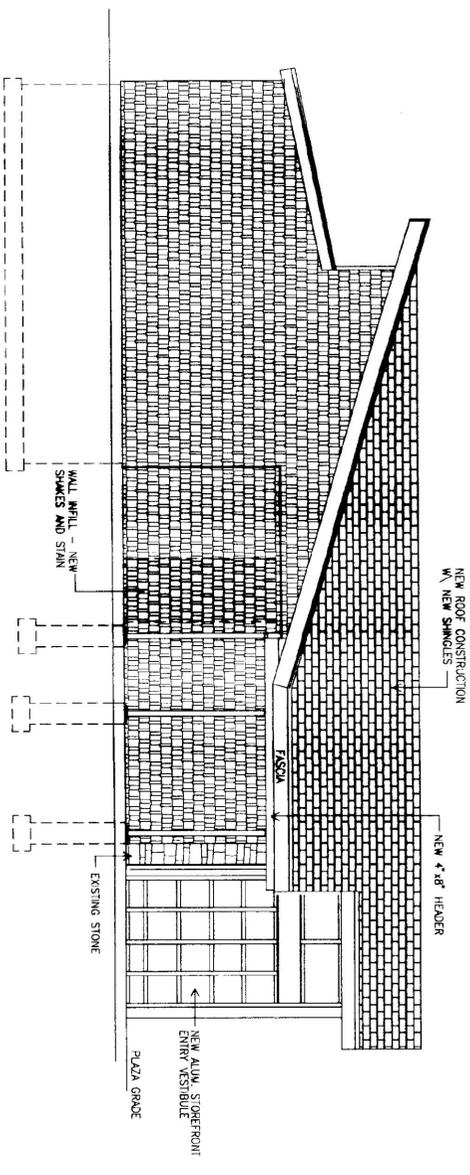


2 NORTH ELEVATION
SCALE: 1/4" = 1'

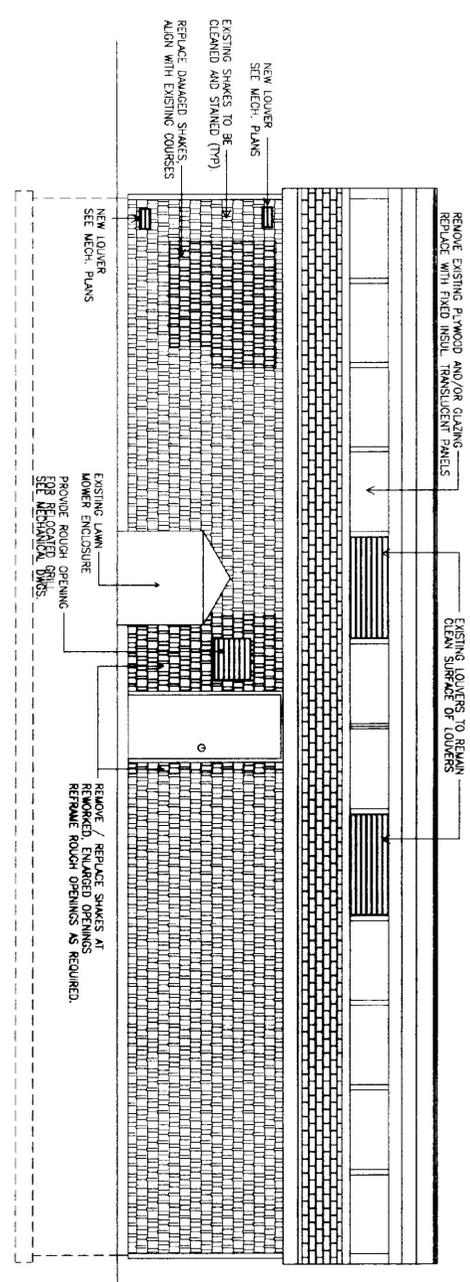

4 EAST ELEVATION
SCALE: 1/4" = 1'

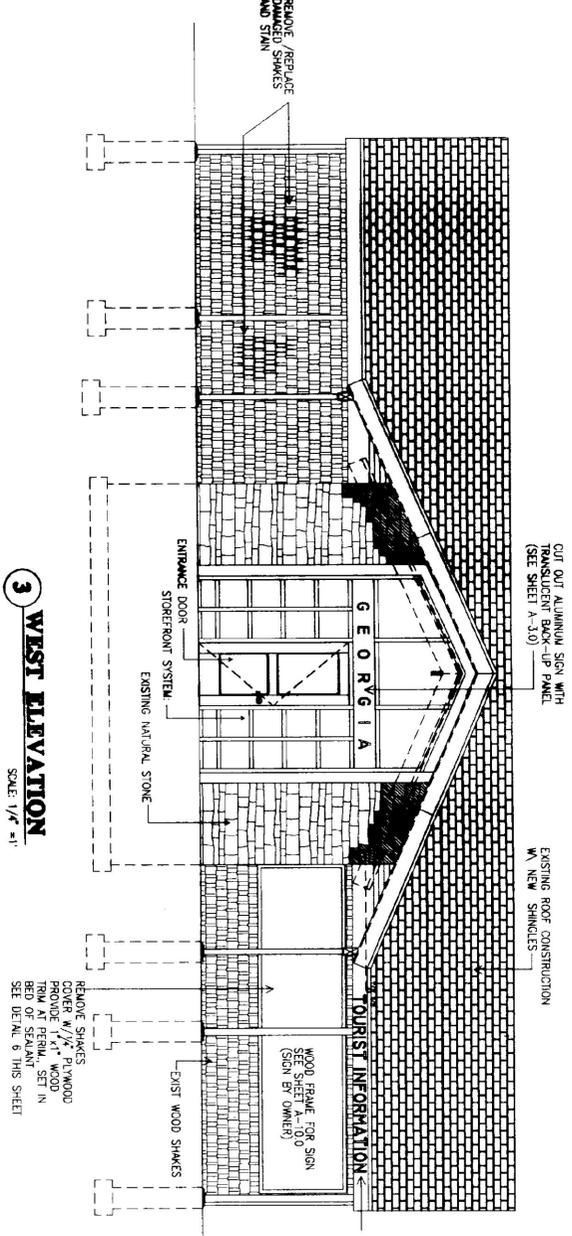

3 WEST ELEVATION
SCALE: 1/4" = 1'

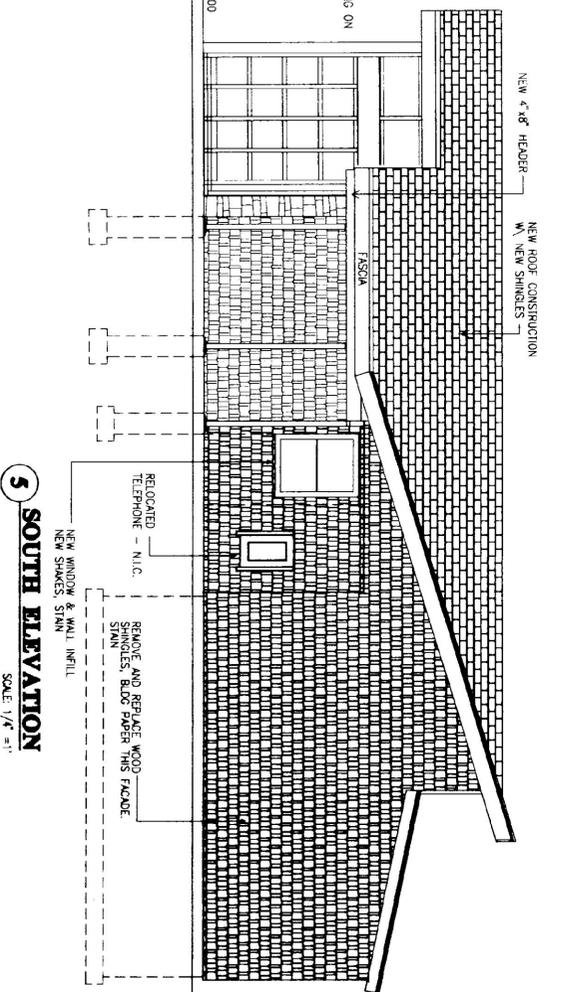

5 SOUTH ELEVATION
SCALE: 1/4" = 1'

LEGEND

	BLOCK WALL CONSTRUCTION
	NATURAL STONE WALL
	FASCIA SHAKES
	ROOF SHAKES
	BATT INSULATION



STATE OF VERMONT
DEPARTMENT OF BUILDINGS
AND GENERAL SERVICES
AGENCY OF ADMINISTRATION
MONTPELIER, VERMONT

**GEORGIA INTERSTATE 89 REST AREAS
NORTHBOUND**

DATE: AUGUST 21, 1998	SCALE: 1/4" = 1'	REVISIONS:	DRAWING NAME: BUILDING ELEVATION
DRAWN BY: MSA	PROJECT NO.: M-089-3 (00)		DRAWING NO.: A-11
CHECKED BY: JSA			

AS BUILT
DATE: 7/21/98