
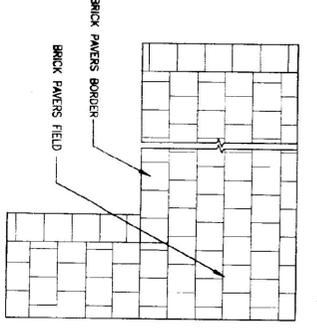
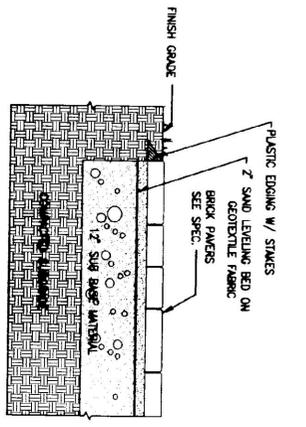
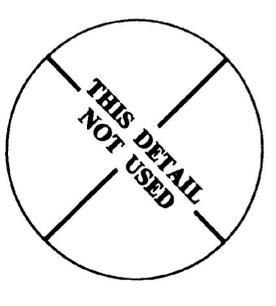
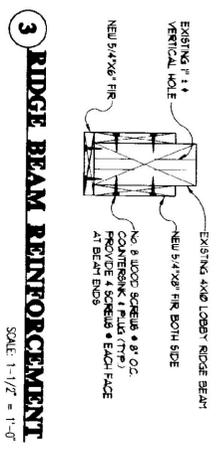
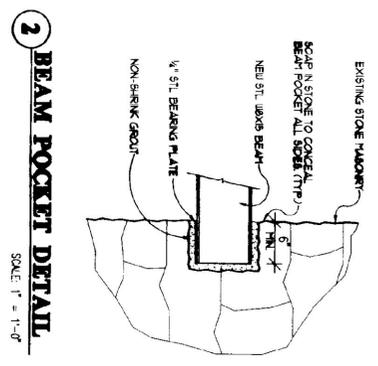


**AS BUILTS**  
DATE: 7/21/89

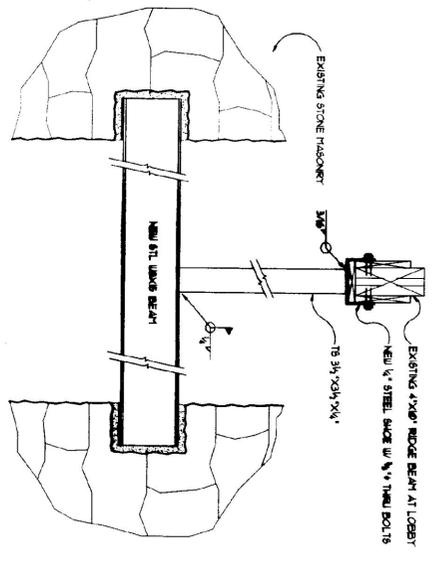

**1 RIDGE BEAM SUPPORT**  
SCALE: 1" = 1'-0"






**2 BEAM POCKET DETAIL**  
SCALE: 1" = 1'-0"

**3 RIDGE BEAM REINFORCEMENT**  
SCALE: 1-1/2" = 1'-0"

**4 ASPHALT PAVEMENT**  
SCALE: 1" = 1'-0"

**5 SITE - PRECAST PAVERS**  
SCALE: 1" = 1'-0"

**6 SITE - PRECAST PAVERS PATTERN**  
SCALE: 1" = 1'-0"

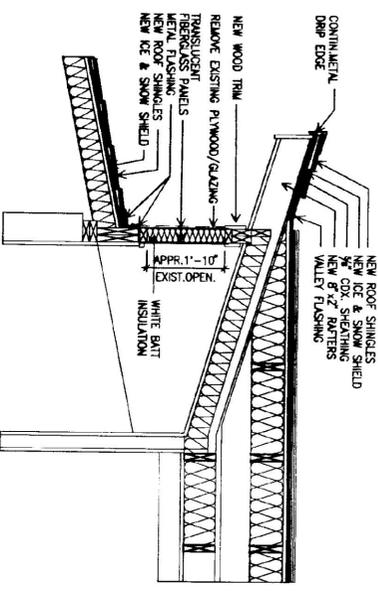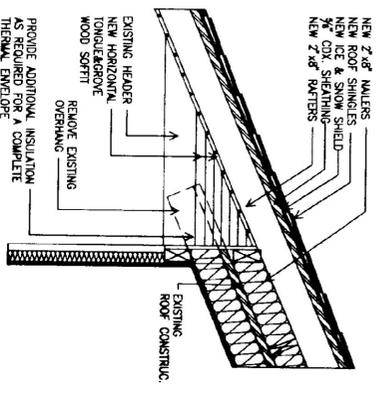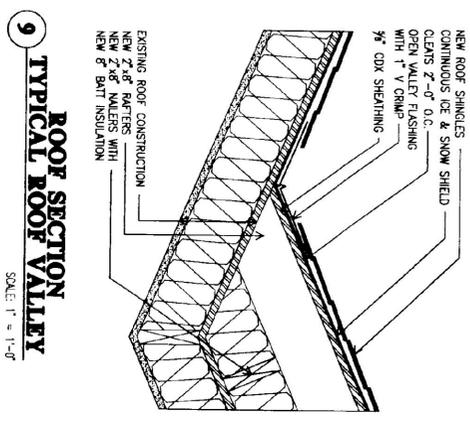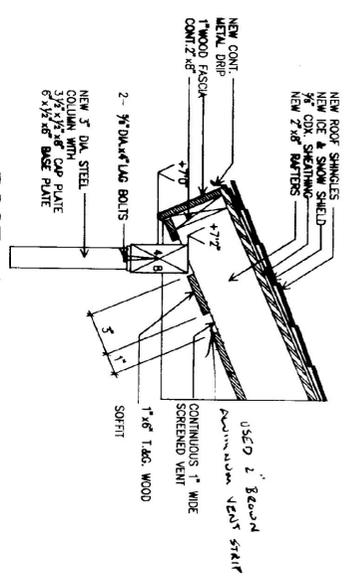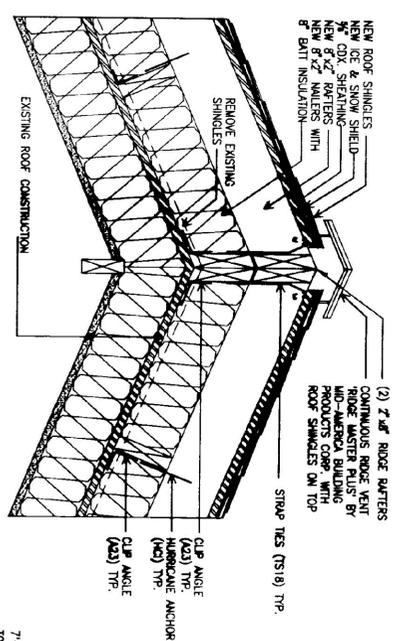


**7 TYPICAL ROOF RIDGE**  
SCALE: 1" = 1'-0"

**8 TYPICAL ROOF EAVE**  
SCALE: 1" = 1'-0"


**9 TYPICAL ROOF VALLEY**  
SCALE: 1" = 1'-0"

**10 DETAIL AT EXG / NEW ROOF**  
SCALE: 1" = 1'-0"


**11 ROOF SECTION CHRISTORY WINDOWS**  
SCALE: 1" = 1'-0"

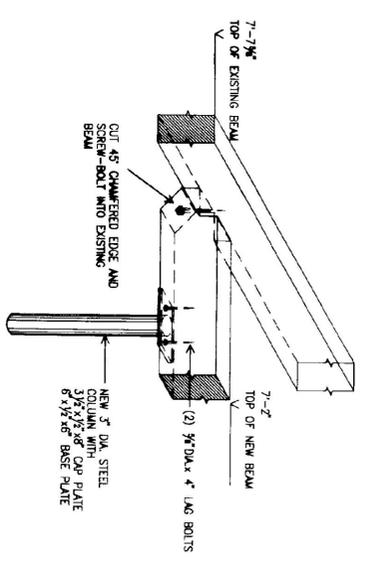


**12 DETAIL EXG/NEW HEADER AT PORTICO**  
SCALE: 1" = 1'-0"

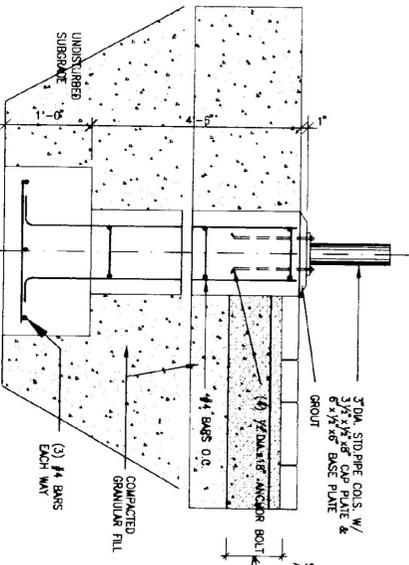


**15 STRUCTURAL COLUMN FOUNDATION DETAIL**  
SCALE: 1" = 1'-0"

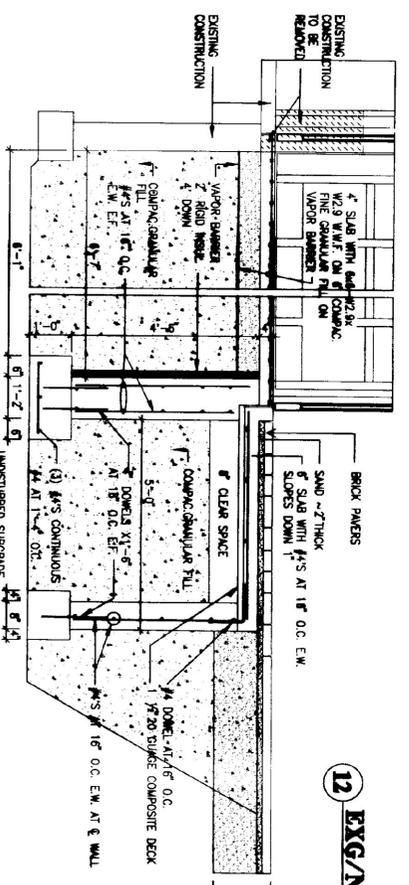

**13 STRUCTURAL FOUNDATION DETAIL EXISTING / NEW**  
SCALE: 1/2" = 1'-0"

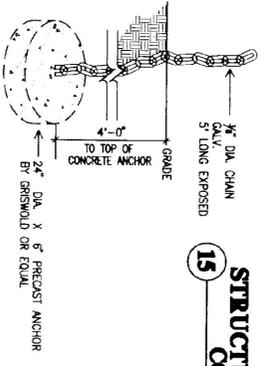

**14 CONCRETE ANCHOR FOR PICNIC TABLE AND BENCHES**  
SCALE: 1/2" = 1'-0"

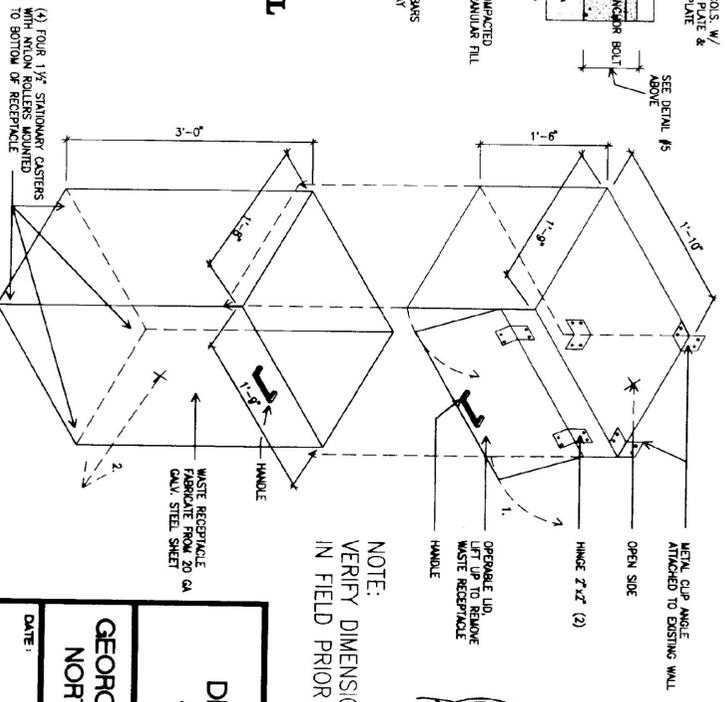

**16 WASTE RECEPTACLE DETAILS**  
SCALE: 1" = 1'-0"

NOTE:  
VERIFY DIMENSIONS FOR WASTE RECEPTACLE  
IN FIELD PRIOR TO FABRICATION



STATE OF VERMONT  
DEPARTMENT OF BUILDINGS  
AND GENERAL SERVICES  
AGENCY OF ADMINISTRATION  
NORTHFIELD, VERMONT

GEORGIA INTERSTATE 89 REST AREAS  
NORTHBOUND AND SOUTHBOUND

DATE:	SCALE:	REVISIONS:	DRAWING TITLE:
AUGUST 21, 1988	AS NOTED		MISCELLANEOUS DETAILS
DRAWN BY:	PROJECT NO.:		DRAWING NO.:
MSB	M-089-3 (90)		
CHECKED BY:			

A-34