


NEW SEWER LINE AND RENOVATIONS TO THE I-89 GEORGIA NORTH BOUND AND SOUTH BOUND REST AREAS


Federal Project No. IM 089-3 (30)

AUGUST 21, 1998

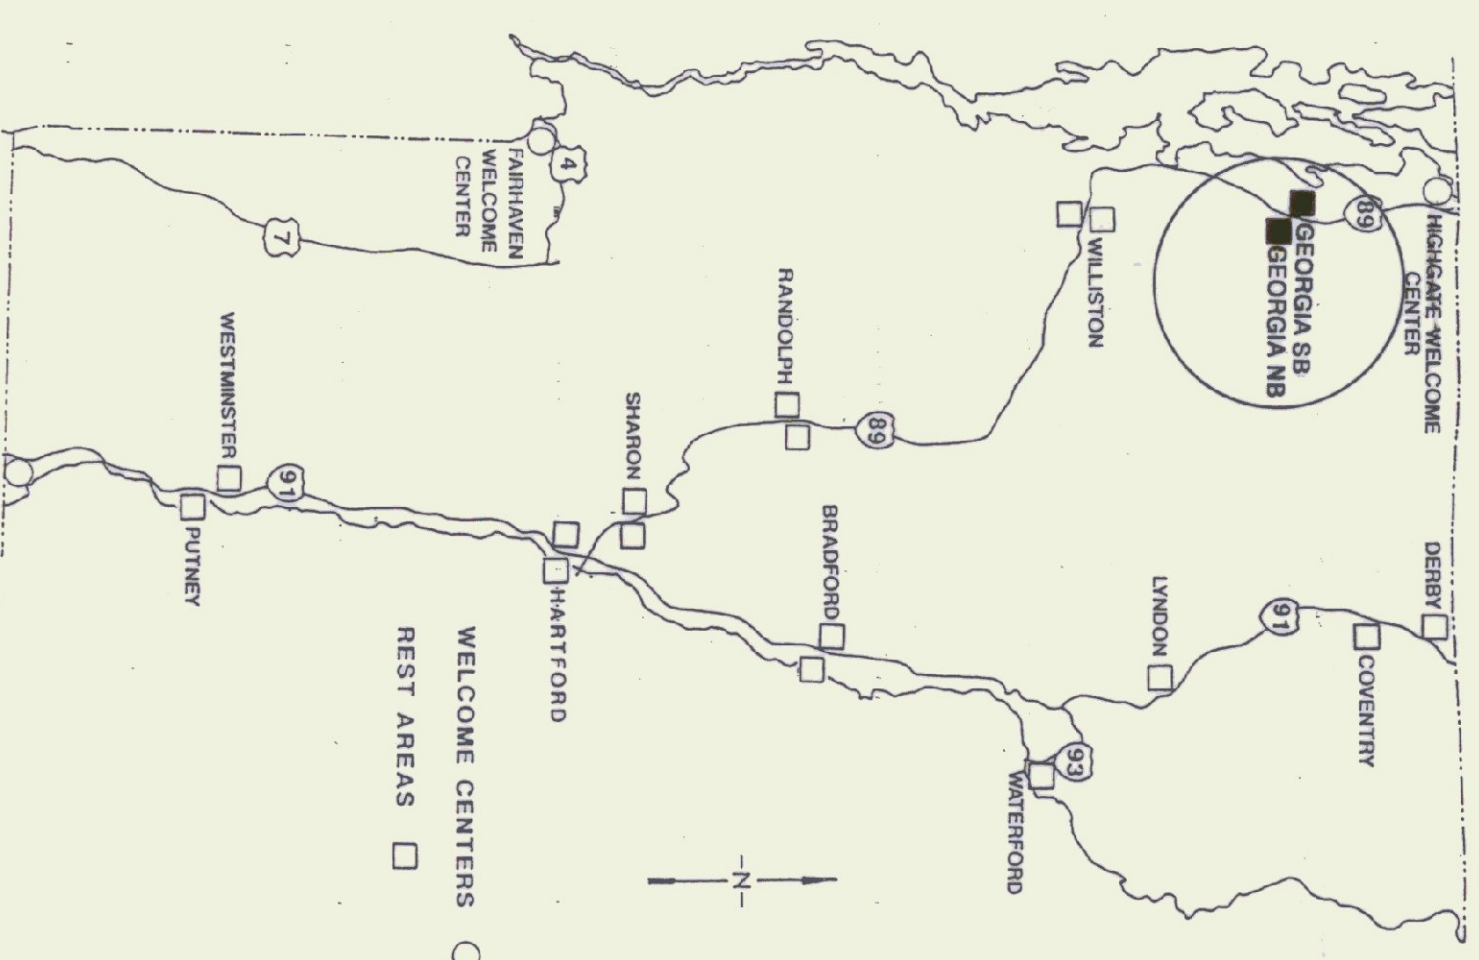

PROJECT LOCATION

PROJECT CONSISTS OF RENOVATIONS TO THE EXISTING FACILITY INCORPORATING ADA COMPLIANCE, ENERGY AND SECURITY ENHANCEMENTS, A FORCED MAIN SEWER LINE AND ASSOCIATED SITE WORK

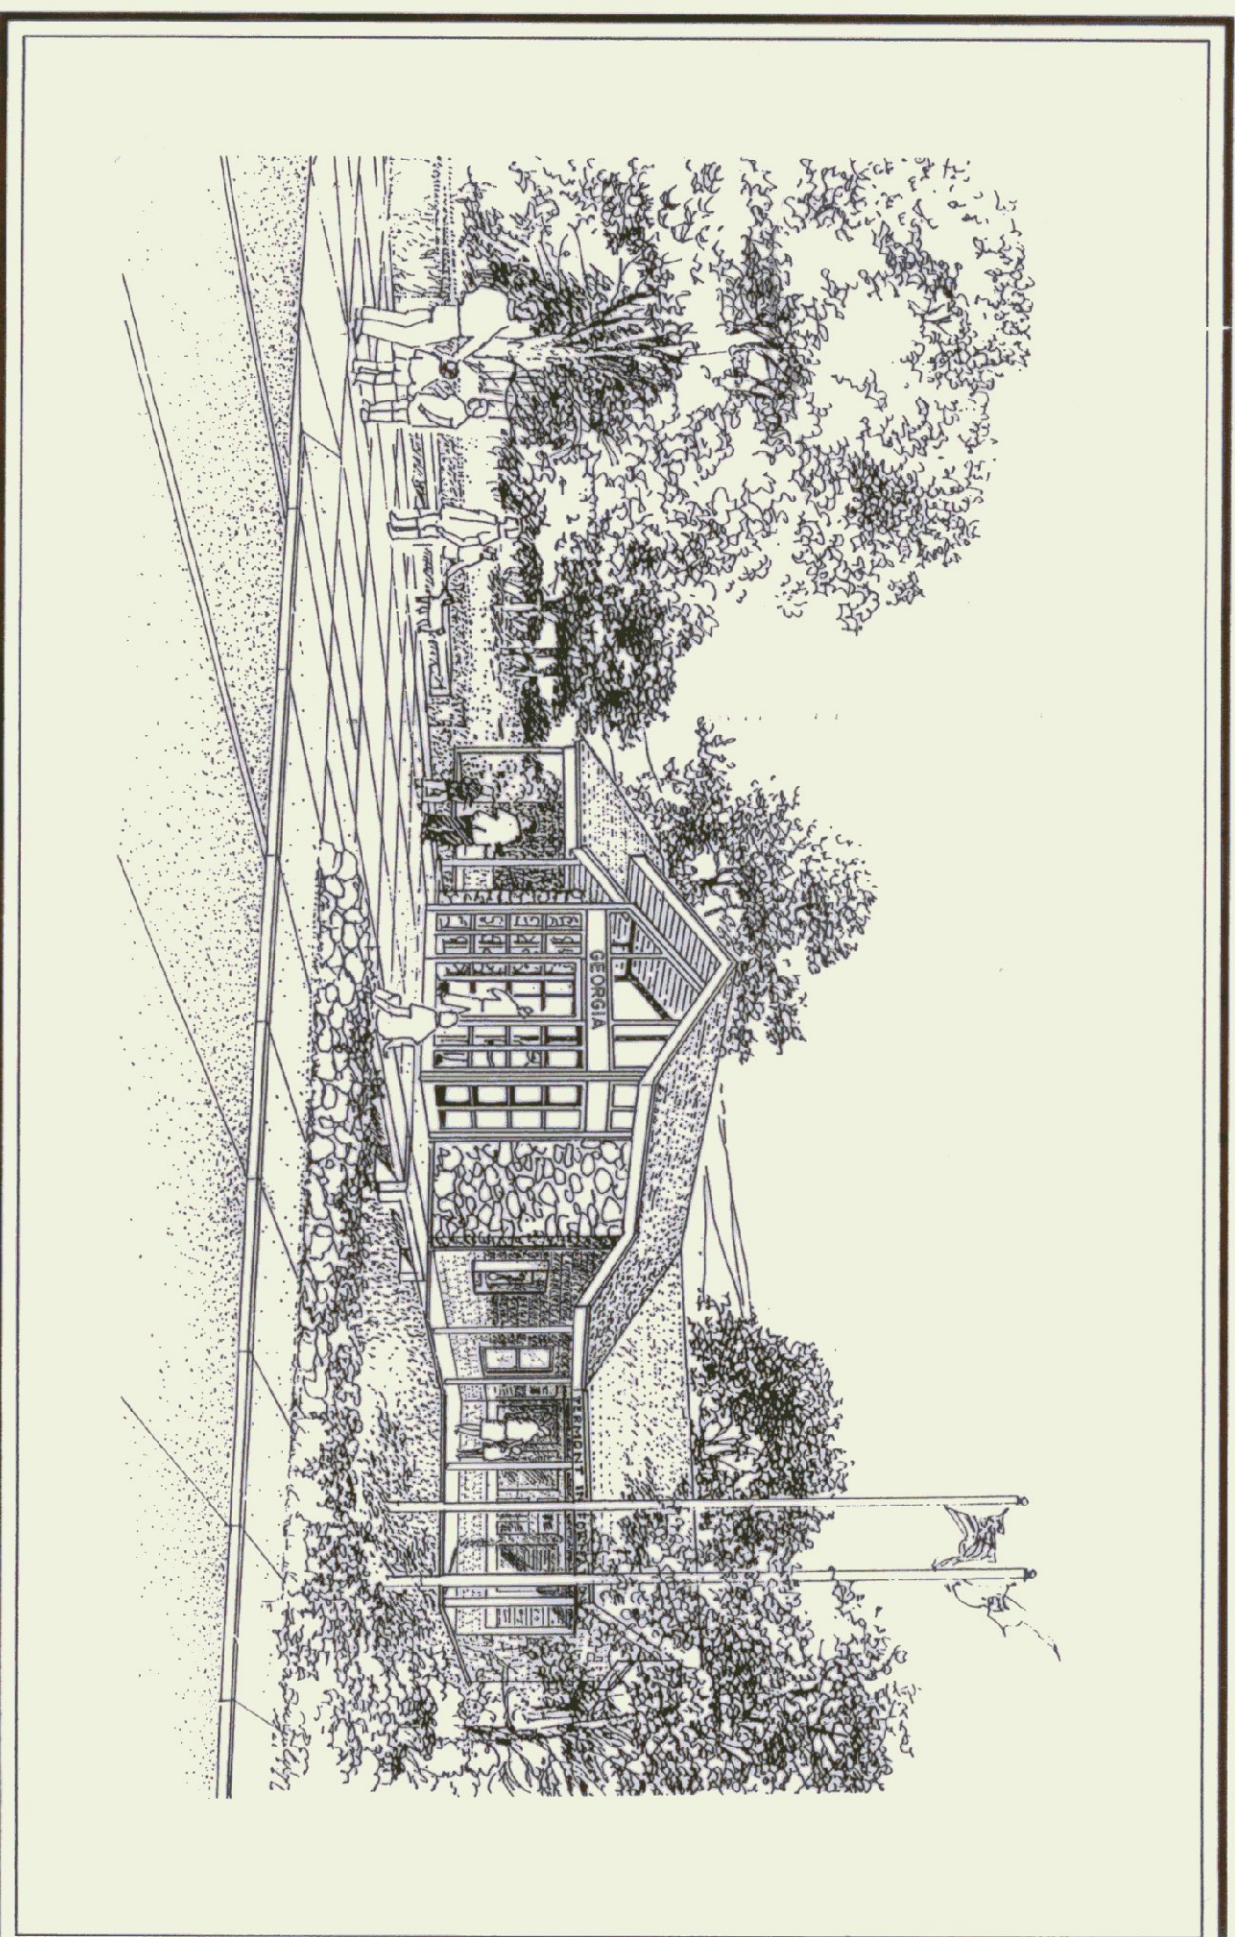

ARCHITECT:

DORE AND WHITTIER INC.
ARCHITECTS • PROJECT MANAGERS

1795 WILLISTON ROAD • SOUTH BURLINGTON • VERMONT
(802)863-1428

MECH./ELEC./PLUMB.:

N.F. LAURENCE & ASSOCIATES
113 WEST MAIN STREET • NORTHBOROUGH • MASSACHUSETTS
(508)393-6412

CIVIL ENGINEERING:

CROSS CONSULTING ENGINEERING
228 NORTH MAIN STREET • ST. ALBANS • VERMONT
(802)524-2113

FHWA: *Mark D. Pickett*
for ADMINISTRATOR

STATE OF VERMONT

AGENCY OF ADMINISTRATION
DEPARTMENT OF BUILDINGS AND GENERAL SERVICES
TWO GOVERNOR AIKEN AVENUE, DRAWER 33
MONTPELIER, VERMONT 05633-5801
(802) 828 3314

GOVERNOR:

HOWARD DEAN, M.D.

COMMISSIONER:

THOMAS W. TORRI

THESE PLANS ARE SUBJECT TO SUCH ENGINEERING CHANGES AS MAY BE REQUIRED BY THE FEDERAL HIGHWAY ADMINISTRATION OR THE DIRECTOR OF CONSTRUCTION AND MAINTENANCE. CONSTRUCTION IS TO BE CARRIED ON IN ACCORDANCE WITH THESE PLANS AND THE STANDARD SPECIFICATIONS FOR CONSTRUCTION DATED MARCH 15, 1990. AS APPROVED BY THE FEDERAL HIGHWAY ADMINISTRATION ON MARCH 15, 1990 FOR USE ON THIS PROJECT. INCLUDING ALL SUBSEQUENT REVISIONS AND SUCH REVISED SPECIFICATIONS AND SPECIAL PROVISION AS ARE INCORPORATED IN THESE PLANS.

DRAWINGS LIST

- S-1.0 NORTHBOUND DEMOLITION PLAN
- S-1.1 NORTHBOUND SITE PLAN
- S-1.2 NORTHBOUND LANDSCAPING PLAN
- S-1.3 DETAILS
- S-1.4 SOUTHBOUND DEMOLITION PLAN
- S-2.0 SOUTHBOUND SITE PLAN
- S-2.1 SOUTHBOUND LANDSCAPING PLAN
- S-2.2 PLAN AND PROFILE
- S-3.0 PLAN AND PROFILE
- S-3.1 PLAN AND PROFILE
- S-3.2 PLAN AND PROFILE
- S-3.3 PLAN AND PROFILE
- S-3.4 PLAN AND PROFILE
- S-3.6 TRAFFIC CONTROL SIGNAGE DETAILS
- A-0.0 SYMBOLS / LEGEND AND NOTES
- A-1.0 NORTHBOUND BUILDING PLAN
- A-1.1 NORTHBOUND BUILDING ELEVATIONS
- A-2.0 SOUTHBOUND BUILDING PLAN
- A-2.1 SOUTHBOUND BUILDING ELEVATIONS
- A-3.0 BUILDING VESTIBULE WOOD FRAME / REFLECT. CIG PLAN
- A-3.1 INTERIOR ELEVATIONS
- A-3.2 FOLDING TABLE / DOOR AND WINDOW SCHED.
- A-3.3 MISCELLANEOUS DETAILS
- A-3.4 MISCELLANEOUS DETAILS
- A-3.5 MISCELLANEOUS DETAILS
- A-3.6 MISCELLANEOUS DETAILS
- P-1.0 NORTHBOUND PLUMBING PLANS
- H-1.0 NORTHBOUND HEATING & VENTILATING PLANS / LEGEND
- P-2.0 NORTHBOUND ELECTRICAL FLOOR PLANS
- H-2.0 SOUTHBOUND HEATING AND VENTILATING PLANS
- P-3.0 SOUTHBOUND ELECTRICAL FLOOR PLANS
- E-2.0 PLUMBING LEGEND / DETAILS
- E-3.0 ELECTRICAL LEGEND / DETAILS
- E-4.0 TEMPORARY RAMP CLOSURE
- E-10.0 CONSTRUCTION APPROACH SIGNS
- E-11.0 TRAFFIC CONTROL MISCELLANEOUS DETAILS
- E-12.0 REGULATORY SIGN DETAILS
- E-13.0 REGULATORY SIGN DETAILS
- E-14.4 REGULATORY SIGN DETAILS
- E-14.5 REGULATORY SIGN DETAILS
- E-14.6 PLANGED CHANNEL STEEL SIGN POST
- E-16.4 PRELIMINARY SQUARE STEEL SIGN POST
- E-18.1 PAVEMENT MARKING DETAILS
- E-18.3 PAVEMENT MARKING DETAILS

AS BUILT
DATE: 7/21/99

BID SET