


019 Tel Box

EXISTING TRAFFIC SIGNAL POLE  
(TO BE REMOVED)

PROPOSED STEI

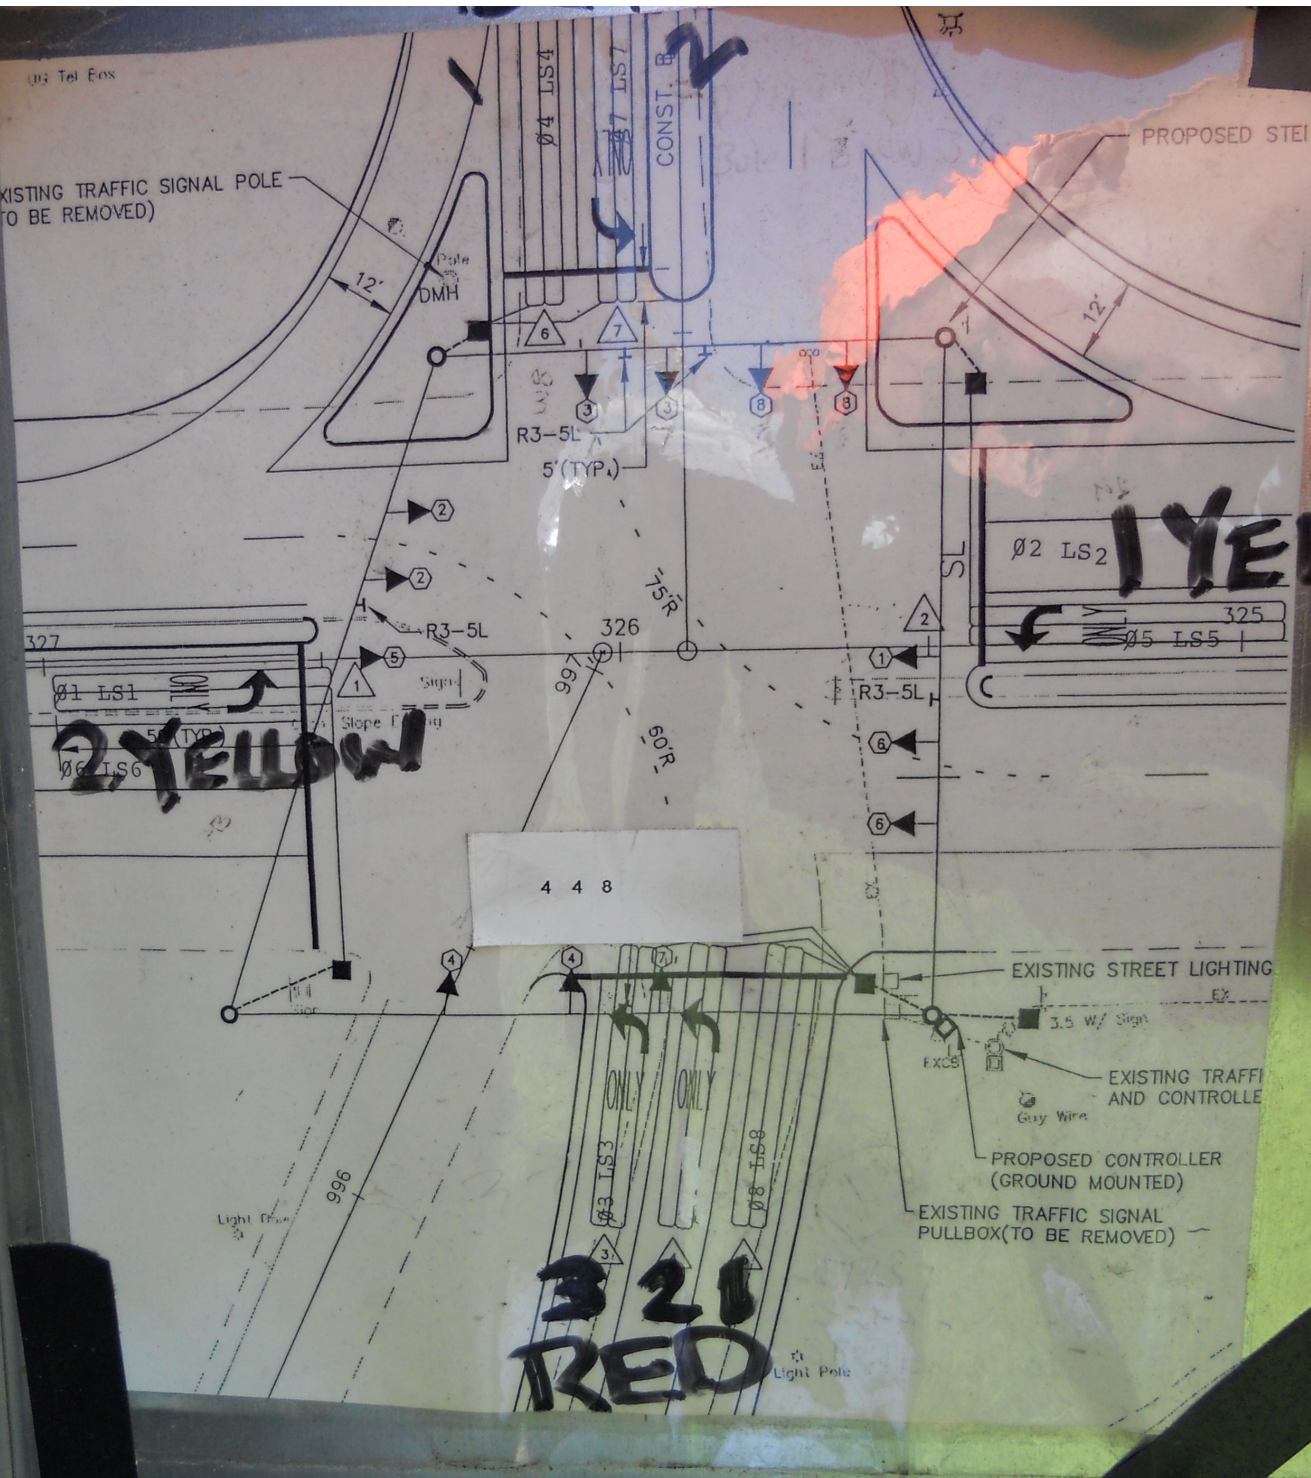

**2 YELLOW**

**1 YELLOW**

**3 2 1  
RED**

4 4 8