

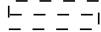








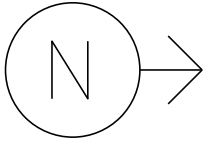






MS # 311

US 4 WEST

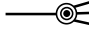


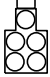CATAMOUNT
PET SUPPLY

-  CONTROL BOX
-  LOOP DETECTION
-  JUNCTION BOX
-  PULL BOX
-  LUMINAIRE
-  STANCHION
-  = 
-  = 

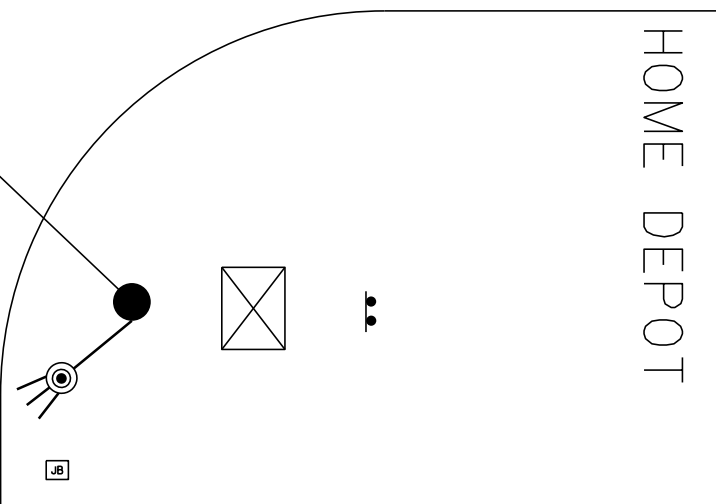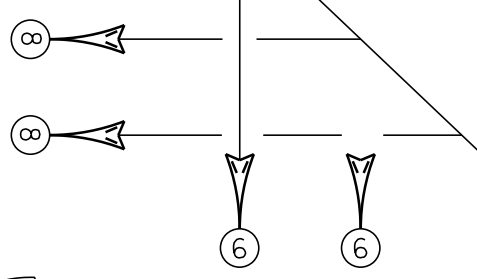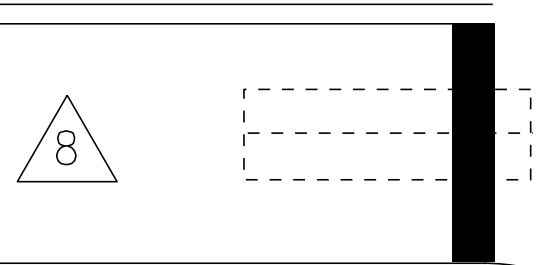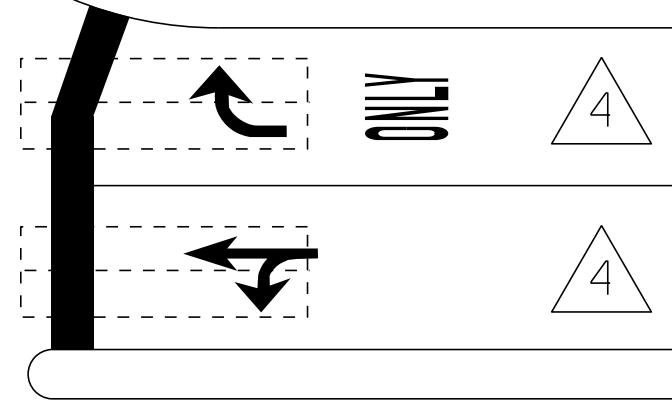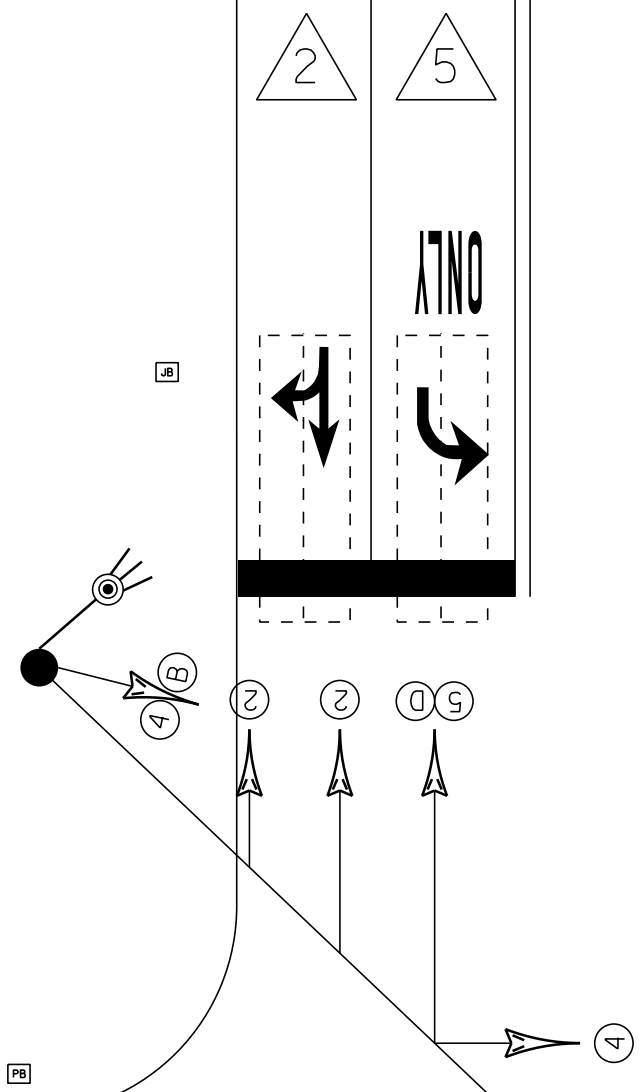

HOME DEPOT

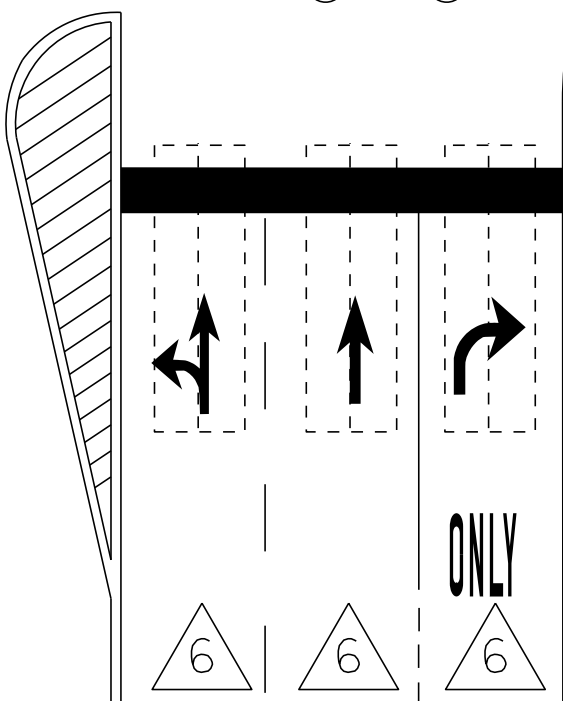

US 4 EAST

NOT TO SCALE