



MS # 313

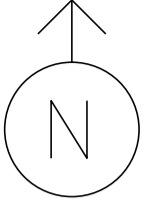

US-7 NORTH

12' | 12' | 12' | 12' | 12'

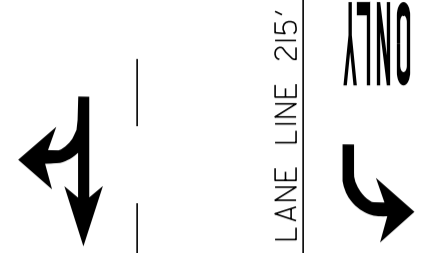

STOP BAR 36'

STOP BAR 27'



17'

12' | LANE LINE 40' | STOP BAR 27'




17'

HOLIDAY INN

STOP BAR 47'

12' | 12'

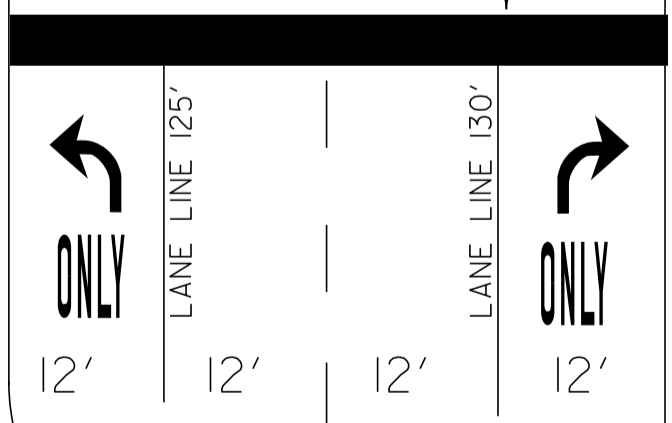

DIAMOND RUN MALL
PONDEROSA

US-7 SOUTH

NOT TO SCALE