


MS # 316

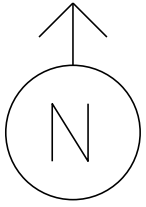


⊙ PEDESTAL POST




⊠ CONTROL BOX

⋯ LOOP DETECTION

●● STANCHION

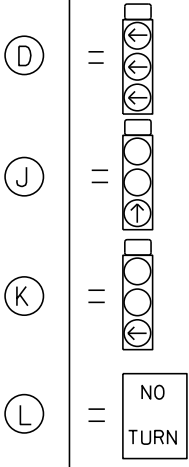

VT 4A WEST

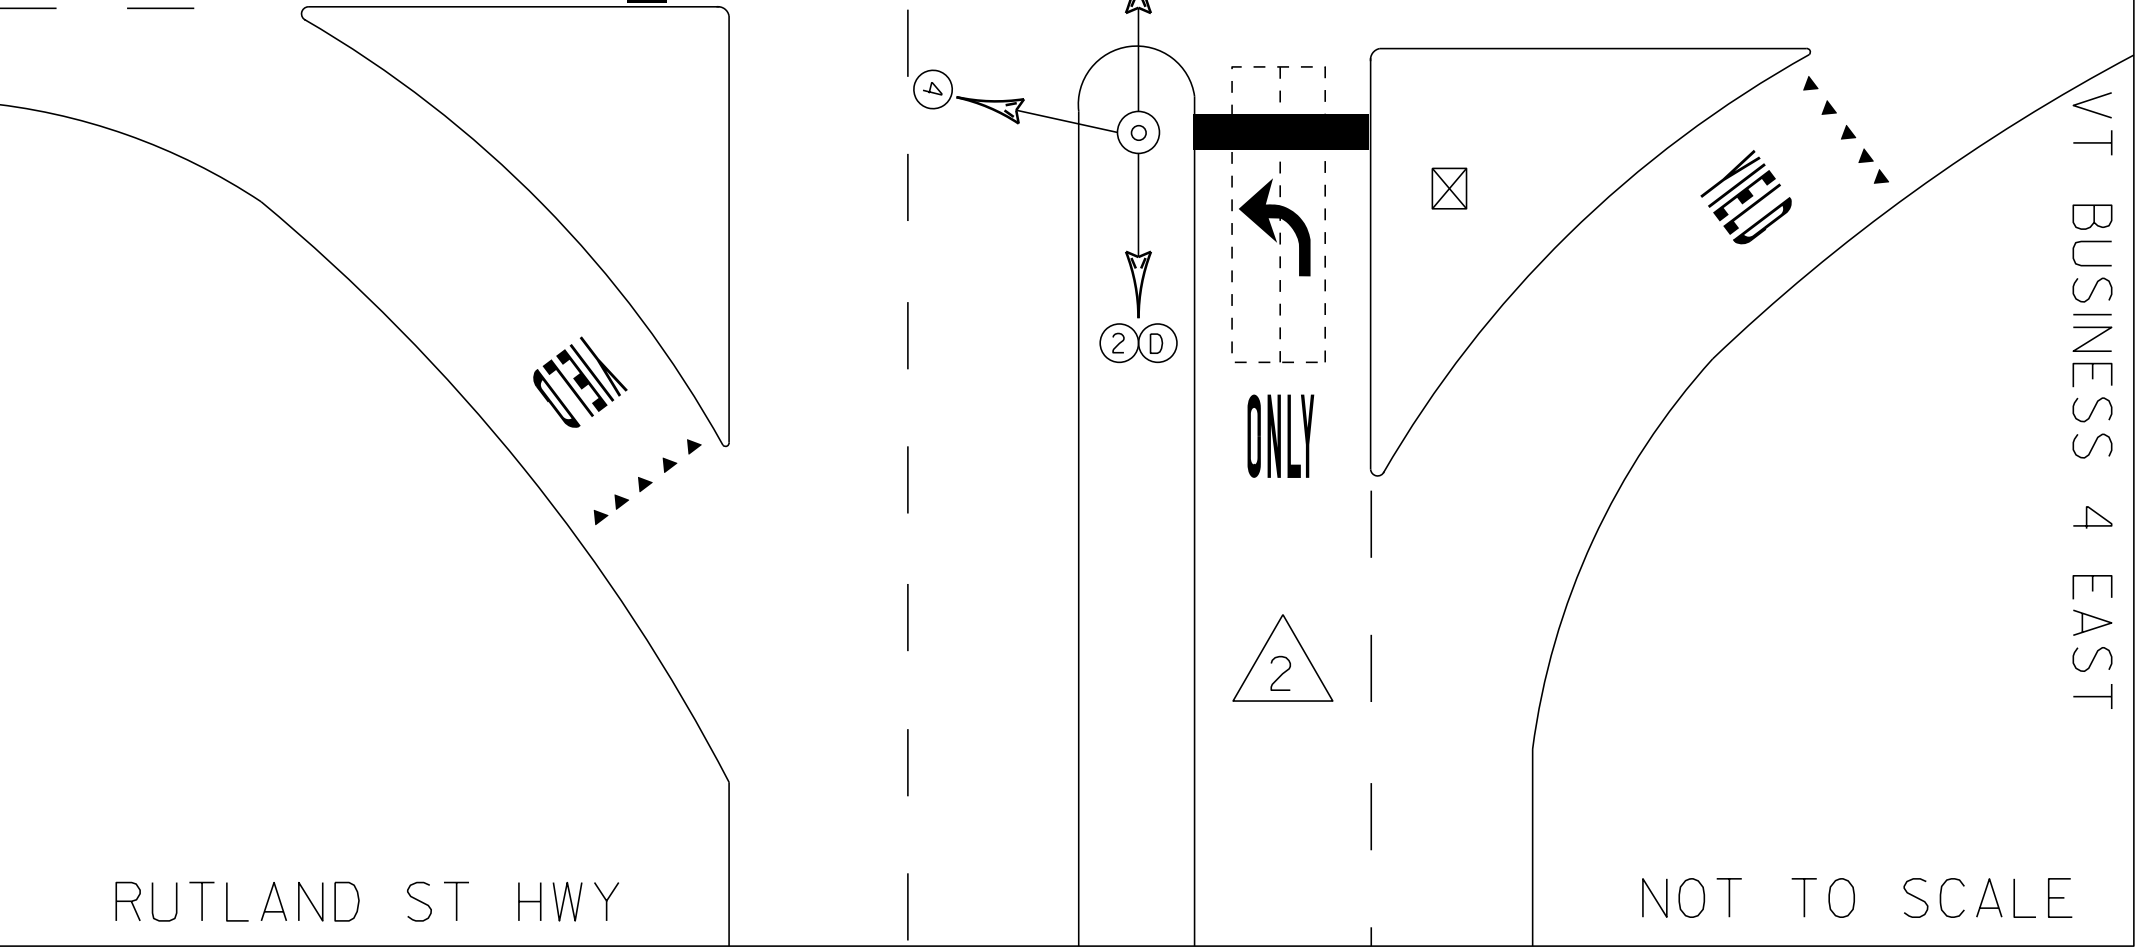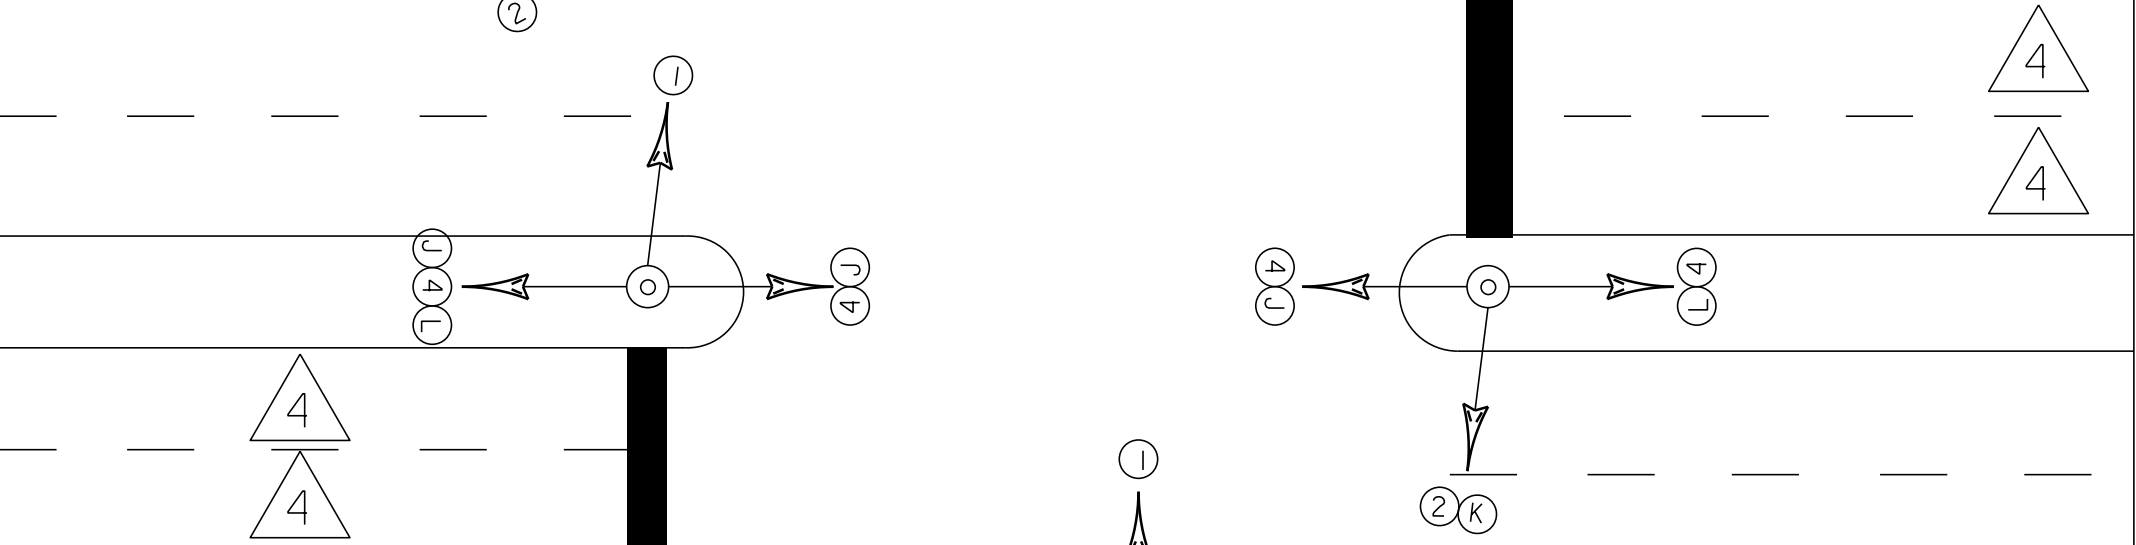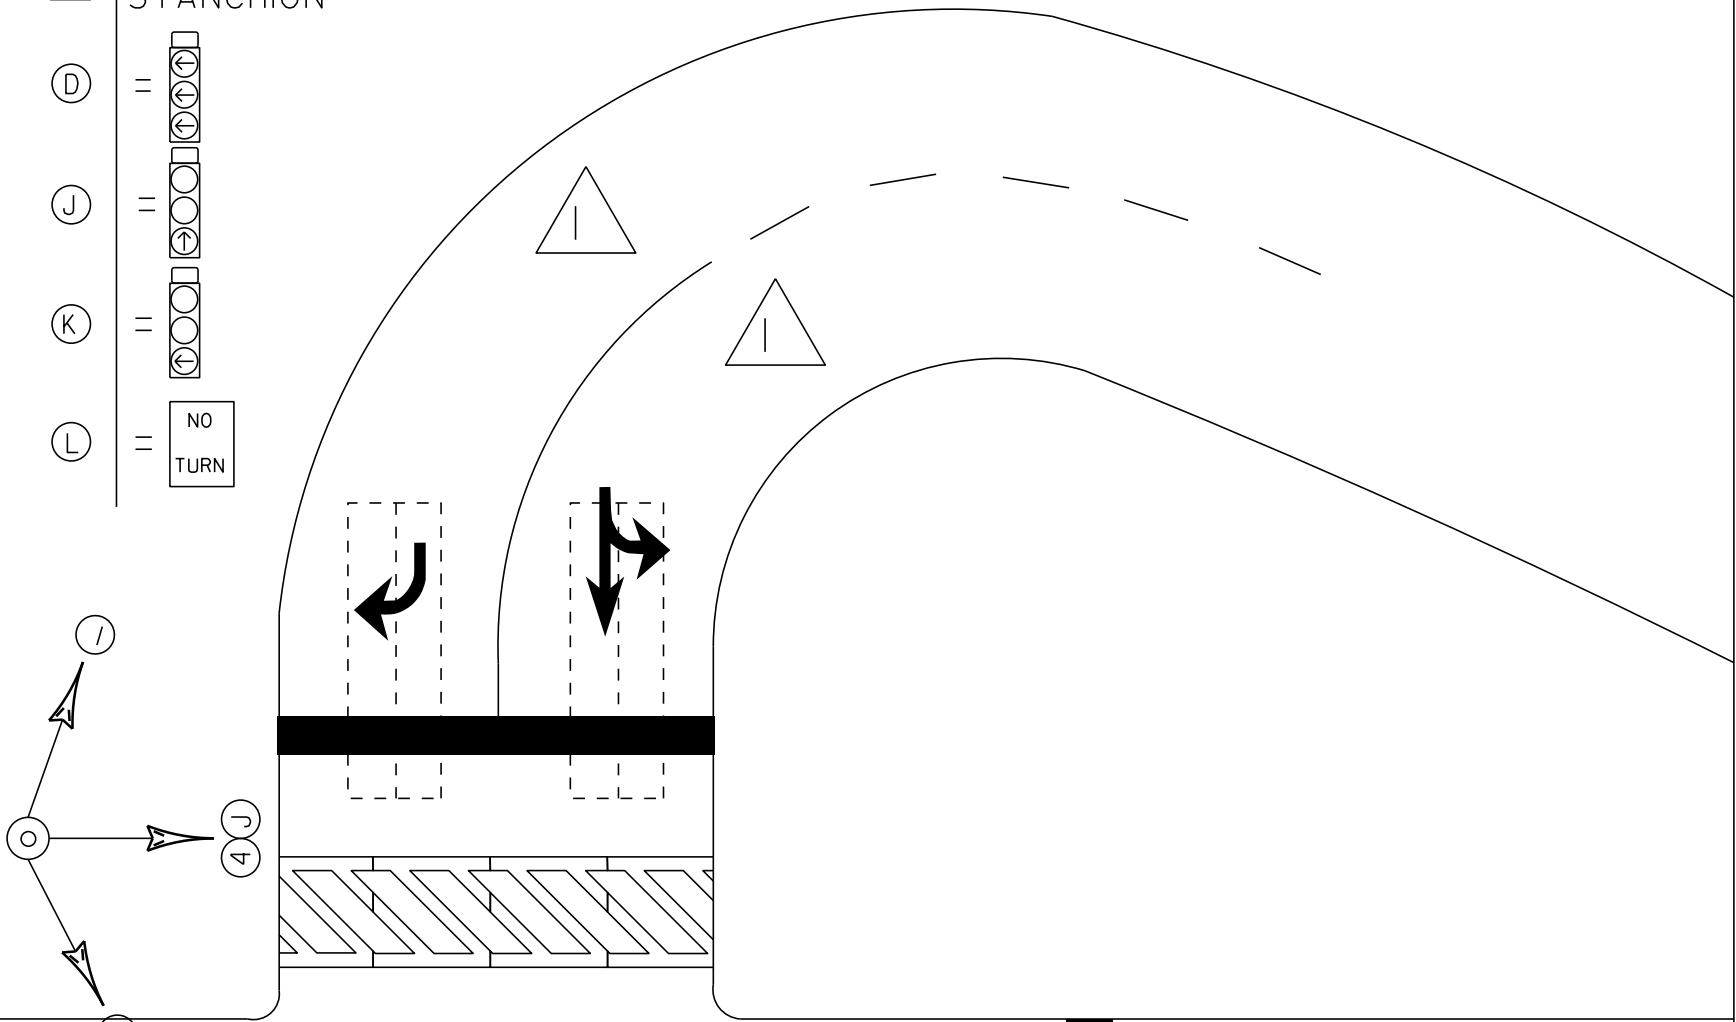

RUTLAND ST HWY

VT BUSINESS 4 EAST

NOT TO SCALE