


Vehicle Loop Detectors							
Lane	Loop No	Size	Type	No. Turns	Call Phase	Mode	Amp.
NB TH	2A	6' X 40'	QUAD	2	2	PRESENCE	NON-DELAYED
NB TH	2B	6' X 40'	QUAD	2	4	PRESENCE	NON-DELAYED
EB TH LT	4A	6' X 40'	QUAD	2	4	PRESENCE	NON-DELAYED
EB RT	4B	6' X 40'	QUAD	2	6	PRESENCE	NON-DELAYED
SB LT	6A	6' X 40'	QUAD	2	6	PRESENCE	NON-DELAYED
SB TH	6B	6' X 40'	QUAD	2	6	PRESENCE	DELAY - 5 SEC
SB RT	6C	6' X 40'	QUAD	2	8	PRESENCE	NON-DELAYED
WB TH LT/RT	8	6' X 40'	QUAD	2	8	PRESENCE	NON-DELAYED

PROPOSED BASE MOUNTED CABINET WITH LOCAL AND FERRY SYSTEM MASTER CONTROLLER

INSTALL METER SOCKET AND DISCONNECT BOX ON STANCHION

POWER SOURCE INSTALL 2" RISER FOR POWER CABLE WITH CONTROLLER

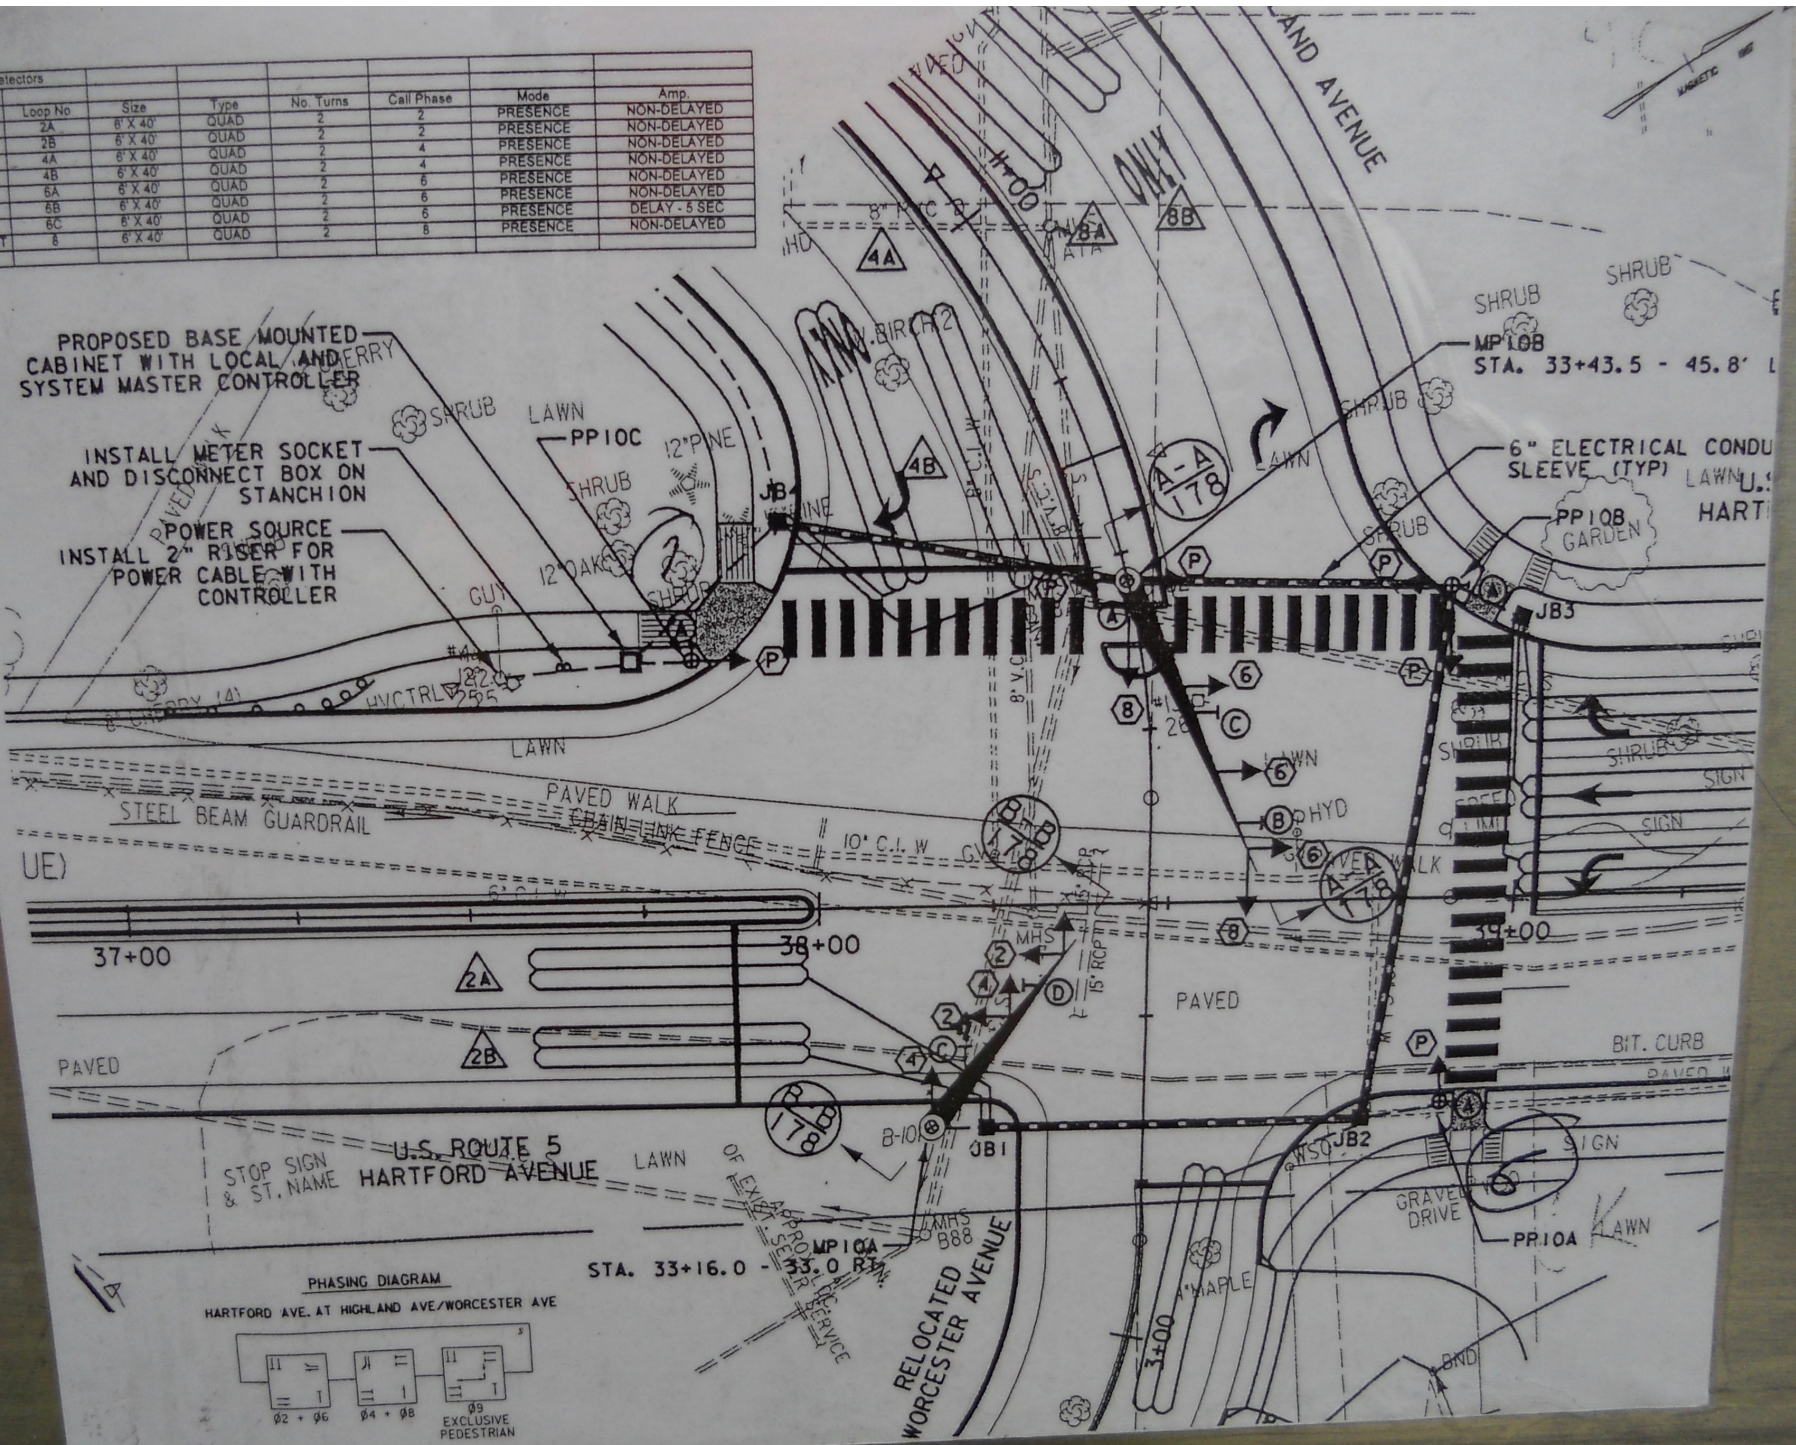

PHASING DIAGRAM
HARTFORD AVE. AT HIGHLAND AVE/WORCESTER AVE

