


MS # 406

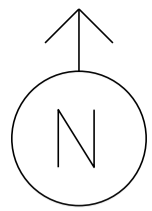

11' ONLY

LANE LINE 80'

11'

LANE LINE 80'


11' ONLY

11'

11'



STOP BAR 34'

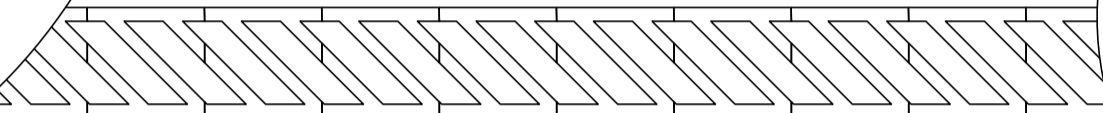

CROSSWALK 70'

12'

12'

12'

12'

CROSSWALK 104'

STOP BAR 36'

LANE LINE 70'

ONLY



STOP BAR 15'

15'

13'

STOP BAR 22'

11'

11'

11'

11'

NOT TO SCALE