



MS # 501

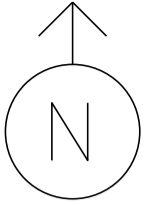


US-7 NORTH

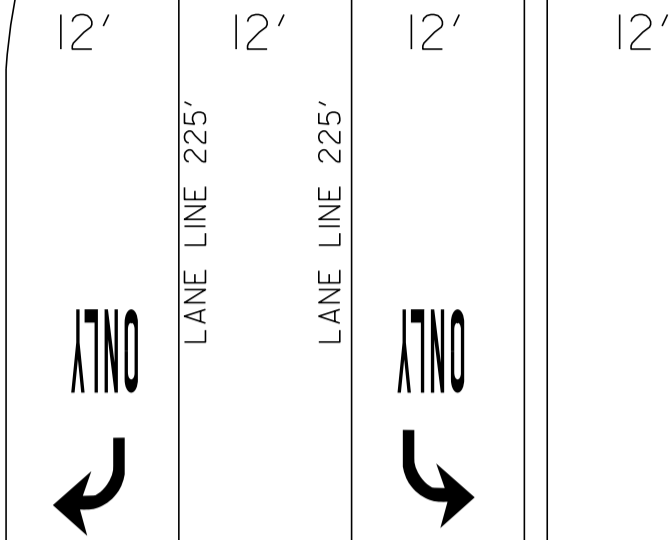

24'

CROSSWALK 51'

STOP BAR 22'

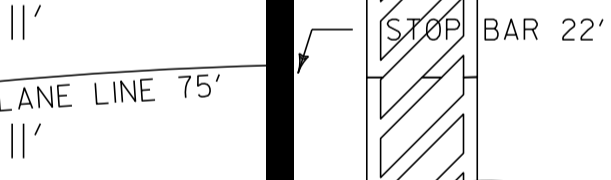


CROSSWALK 12'

12'

MACDONALDS

STOP BAR 25'

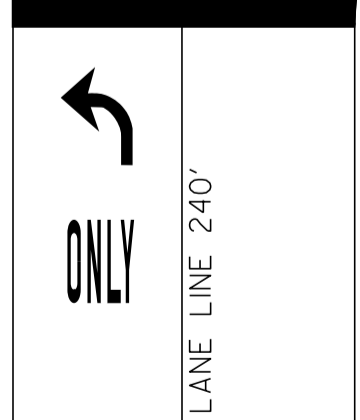

12'

12'

13'

US-7 SOUTH NOT TO SCALE