

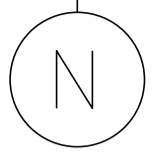
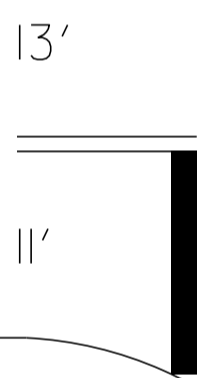


MS # 509

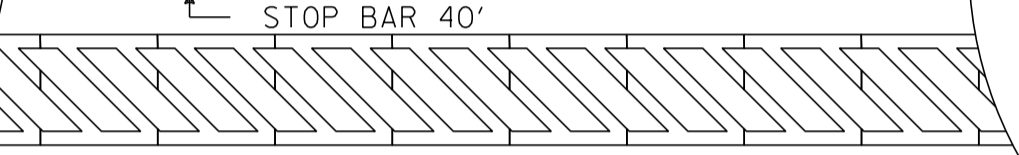

US-7 NORTH

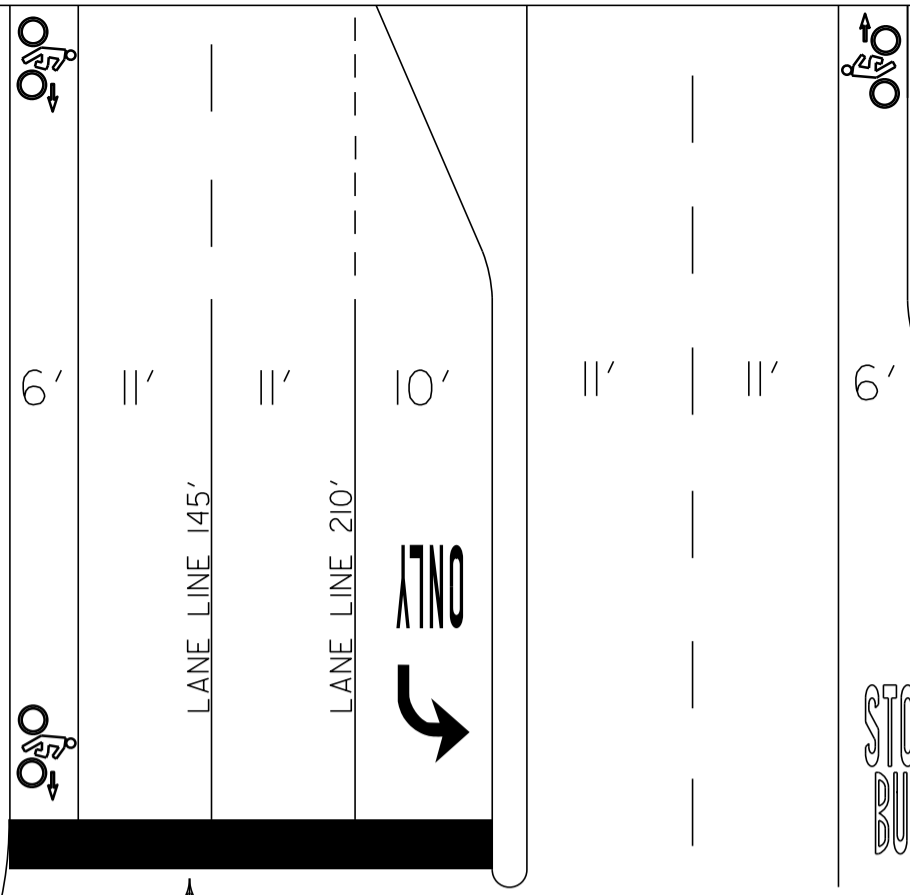

CROSSWALK 63'

STOP BAR 19'

STOP BAR 14'

CROSSWALK 54'

12'


12'

PINE HAVEN SHORE ROAD

LOCUST HILL ROAD

STOP BUS

STOP BAR 40'

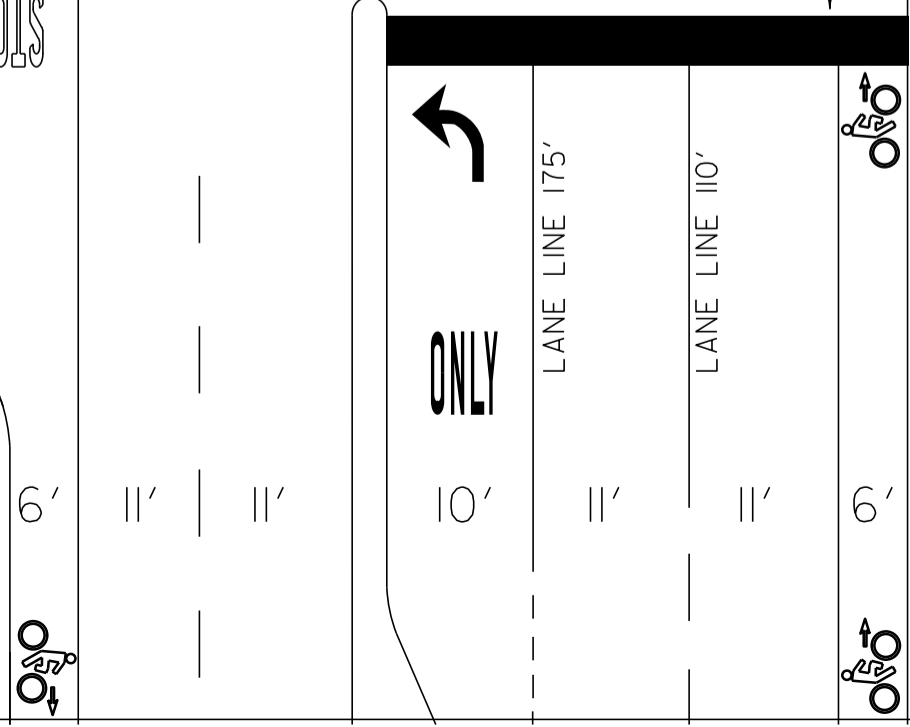

US-7 SOUTH