


SLEEVE LOCATIONS	
265+1, 26.7' LT.	265-53, 29.1' LT.
265+3, 33.0' RT.	265-62, 33.5' RT.
265-63, 21.6' LT.	265-63, 24.1' RT.
266-46, 30.2' RT.	266-58, 49.3' RT.



FROM	TO	ITEM 678.2 (MOD.) INTERCONNECT CONDUIT 3
POWER SOURCE	STATION	
POWER SOURCE	STATION	
STANCHION	JH	
STANCHION	PB	
STANCHION	PB	
B-2	JH	
B-2	JH	
PB-2	PB	35
PB-2	PB	
PB-2	PB	
PB-1	CONTROLLER	
PB-1	CONTROLLER	70
PB-1	PB S-1	
PB S-1	CONTROLLER	
PB S-1	CONTROLLER	
LOOP #8	PB S-1	
CANTILEVER #2	PB	
CANTILEVER #2	PB	
CANTILEVER #2	PB	
PED POLE	PB	
CANTILEVER #4	PB	
CANTILEVER #4	PB	
CANTILEVER #4	PB	
PB S-1	PB	
PB S-1	PB	
PB S-1	PB	
PB S-1	PB	
CANTILEVER #3	PB	
CANTILEVER #3	PB	
PED POLE	PB	
LOOP #4	PB	
PB S-2A	PB	
PB S-2A	PB	
PB S-2A	PB	
PB S-2A	PB	
CANTILEVER #1	PB S-2A	
CANTILEVER #1	PB S-2A	
CANTILEVER #1	PB S-2A	
TOTAL		

- INTERCONNECT ITEM
- ITEM 678.25 - PULL
- 5+62, 7' RT. (I-1)
- 5+62, 23' LT. (I-2)
- LIGHTING ITEMS
- ITEM 678.26 - JUNCTION
- 5+58, 7' RT. (L-1)
- 5+59, 22' LT. (L-2)

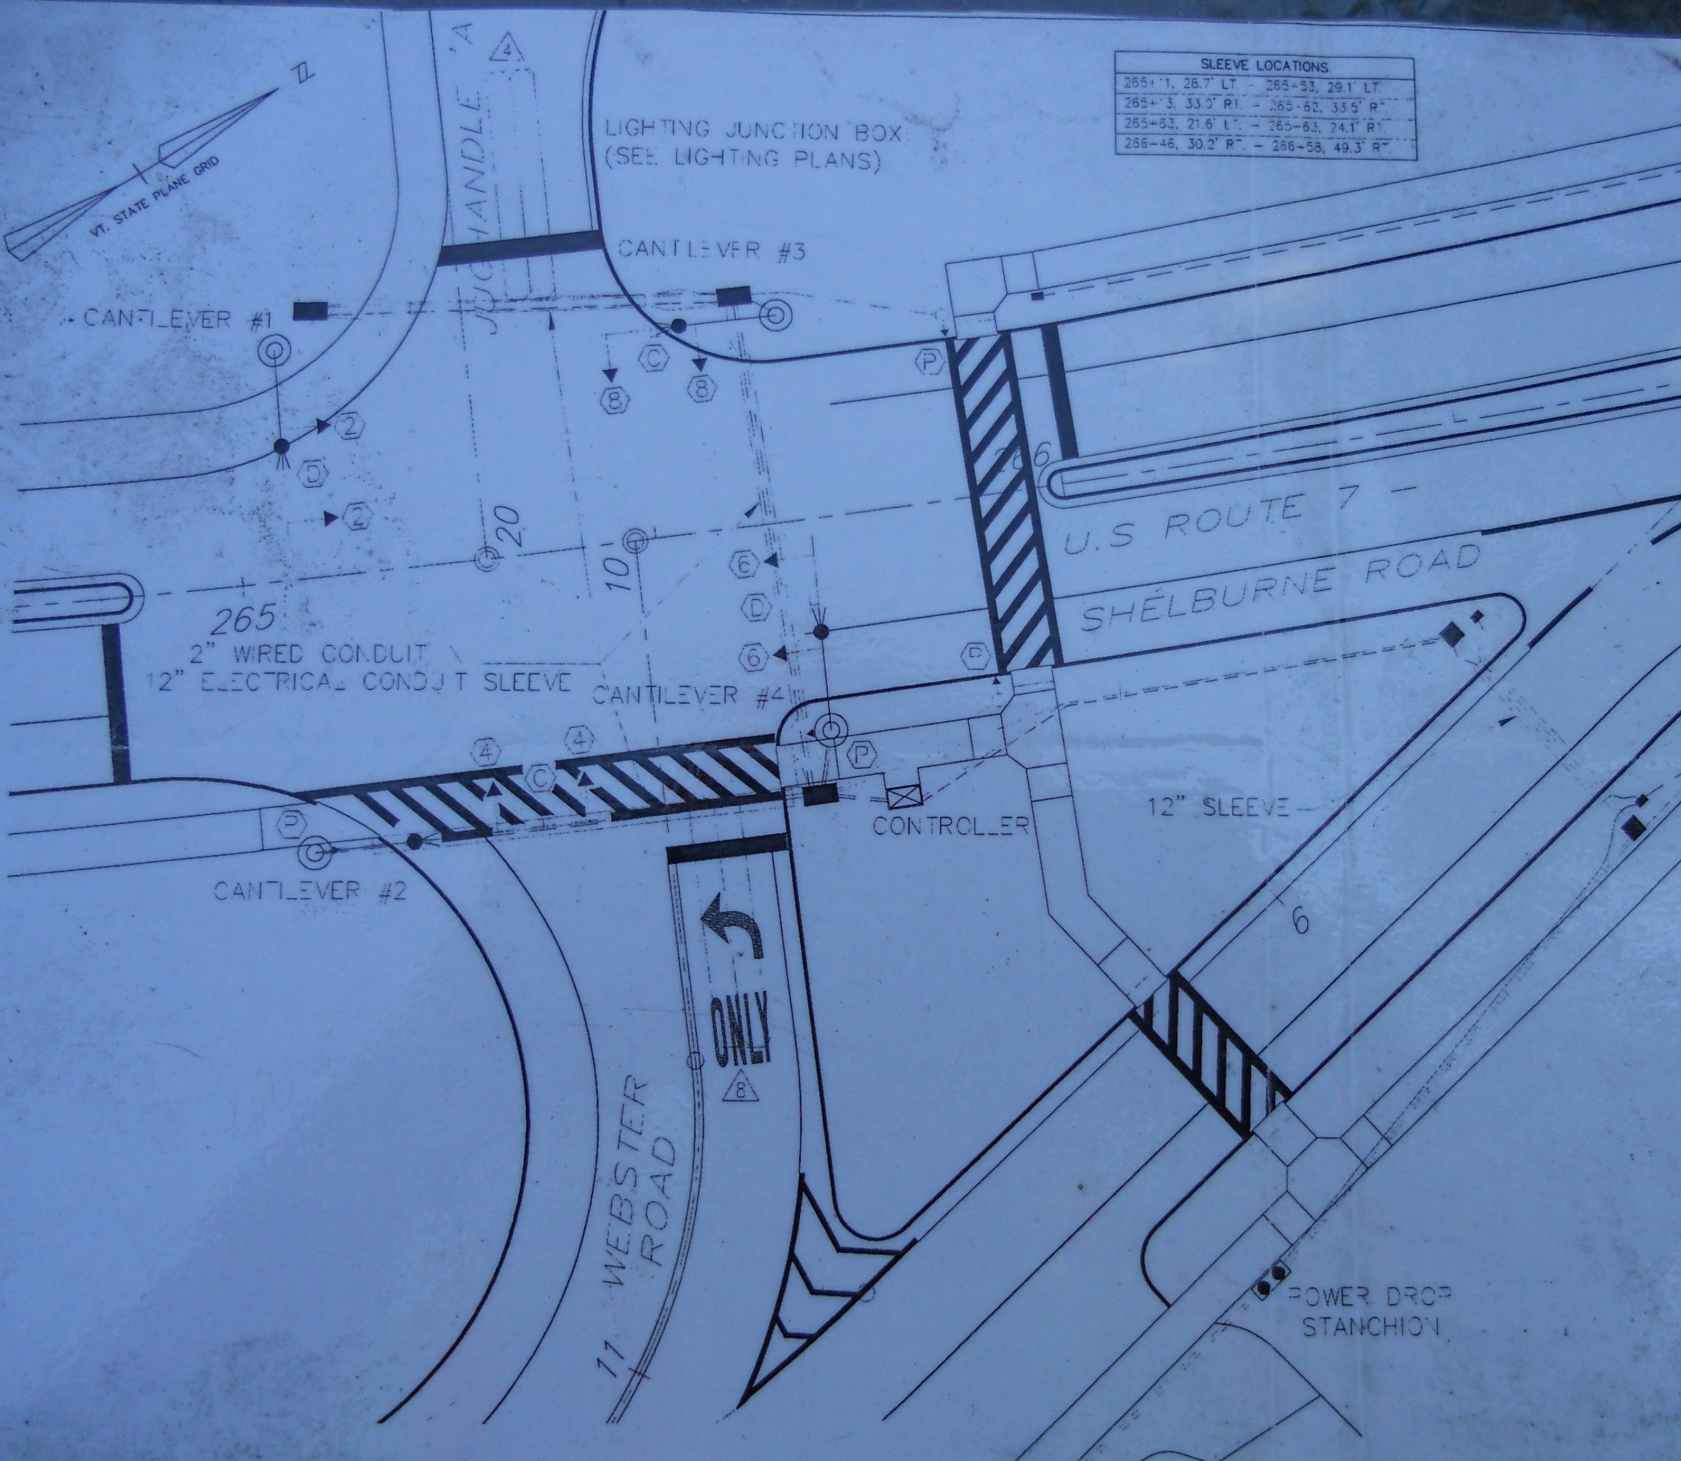