


85	SIGNAL SPARE
	SOUTH BURLINGTON LIGHTING LOOP #4 / PRE-EMPTION
37	SIGNAL LOOP #4
	VAOT LIGHTING
	SIGNAL LOOP #5
	SOUTH BURLINGTON LIGHTING LOOP #4, #5 / PRE-EMPTION
	VAOT LIGHTING
82	SIGNAL SPARE
	PRE-EMPTION
	VAOT LIGHTING
	SIGNAL LOOP #1, #4 & #5 / PRE-EMPTION
	SIGNAL LOOP #8A & #8B
	VAOT LIGHTING
	SOUTH BURLINGTON LIGHTING SIGNAL
	SOUTH BURLINGTON LIGHTING SIGNAL / VAOT LIGHTING INTERCONNECT
204	

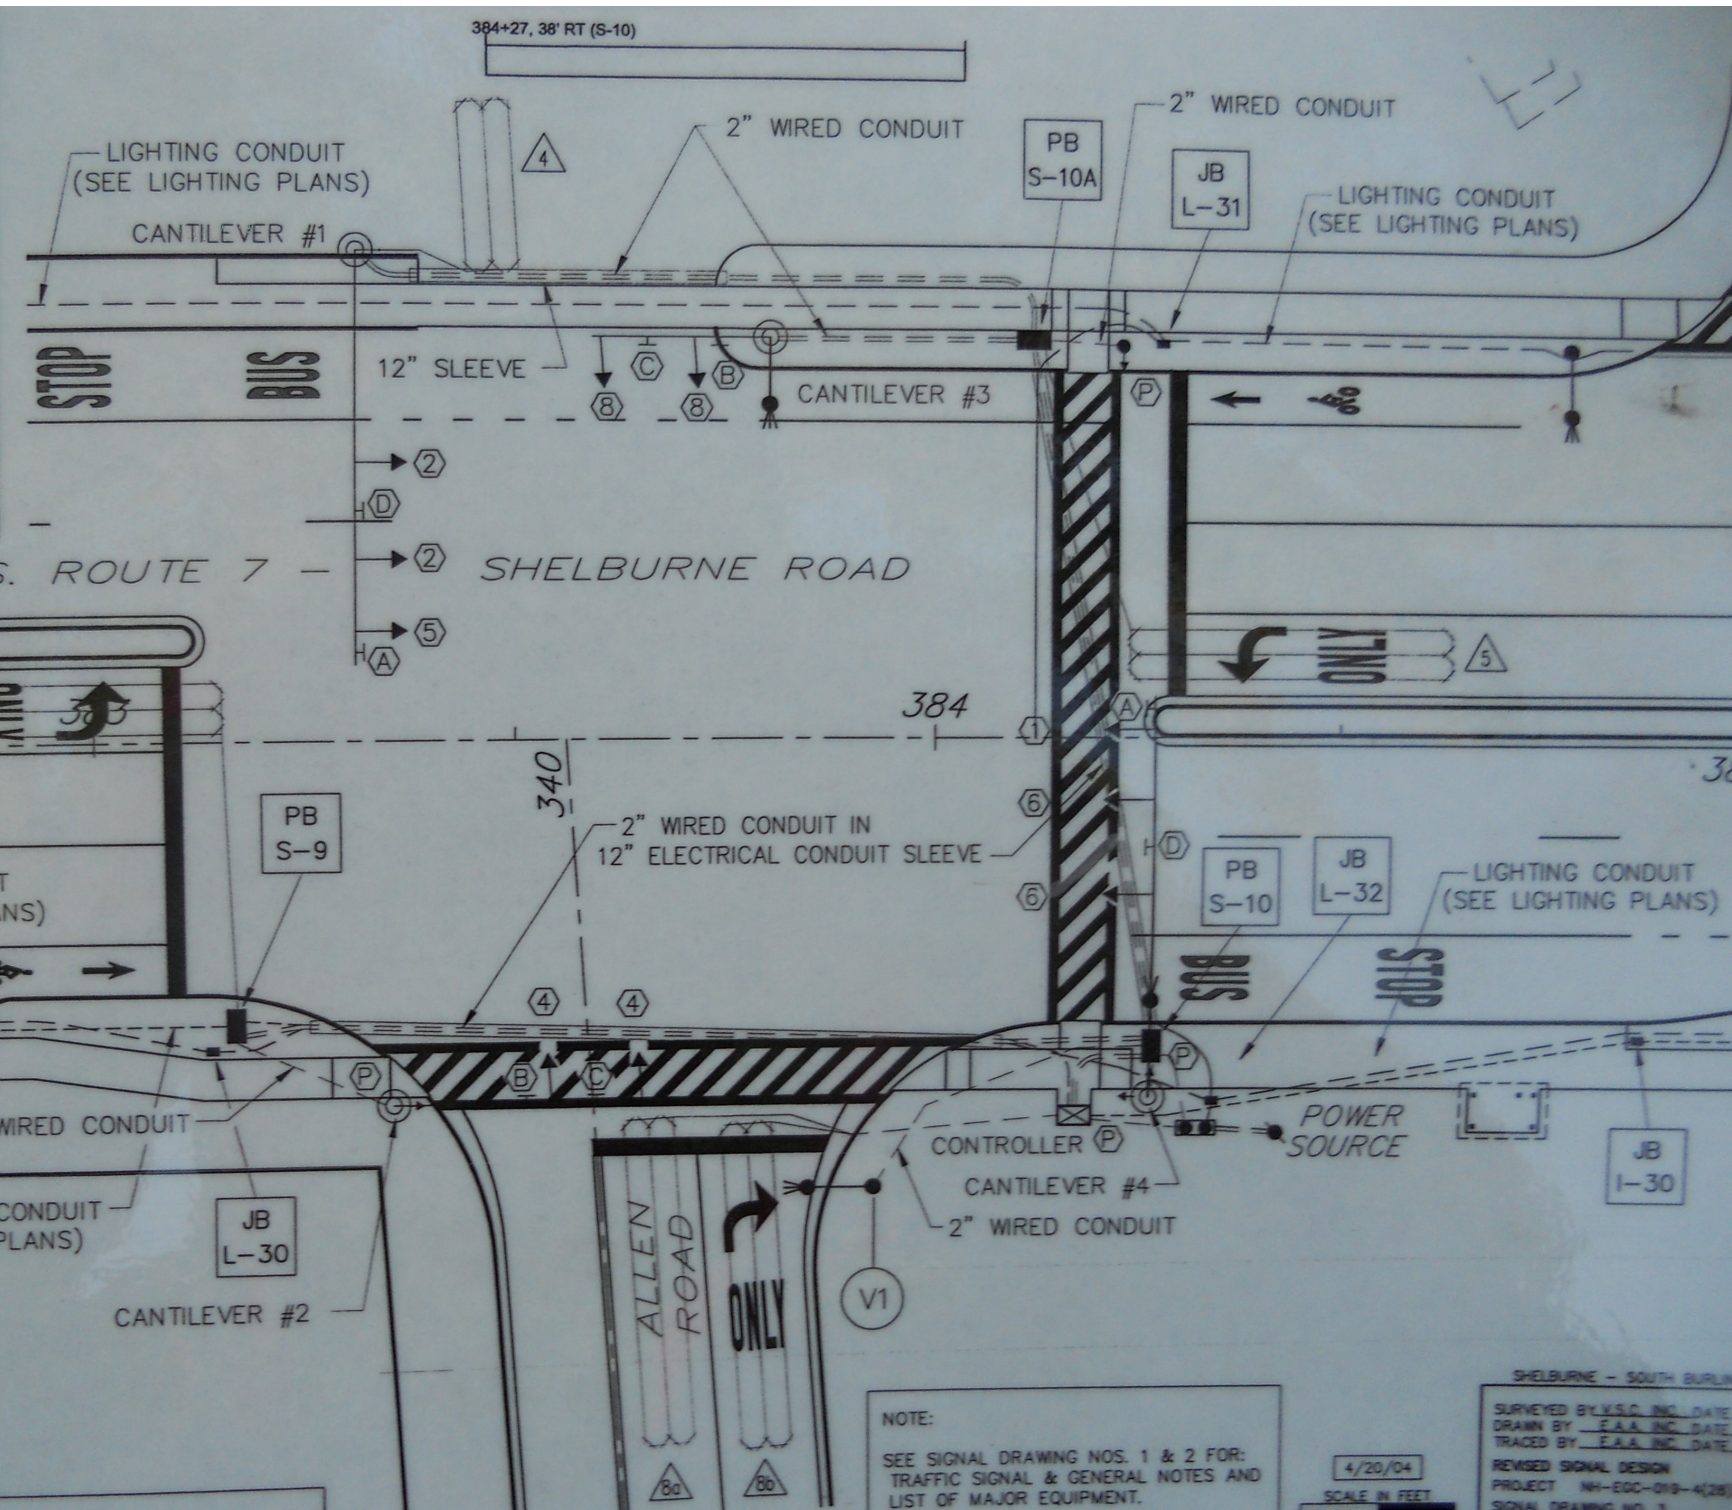

NOTE:  
 SEE SIGNAL DRAWING NOS. 1 & 2 FOR:  
 TRAFFIC SIGNAL & GENERAL NOTES AND  
 LIST OF MAJOR EQUIPMENT.

4/20/04  
 SCALE IN FEET  
 0 10 20

SHELBURNE - SOUTH BURLINGTON  
 SURVEYED BY V.S.C. INC. DATE  
 DRAWN BY F.A.A. INC. DATE  
 TRACED BY F.A.A. INC. DATE  
 REVISED SIGNAL DESIGN  
 PROJECT NH-EDC-018-4(28)  
 SIGNAL DRAWING NO. 3  
 SHEET NO. 128A OF 283

NO. MS-515 (US 7 - ALLEN ROAD)