



MS # 517

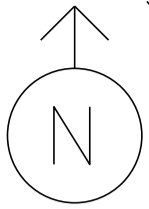


US-7 NORTH

HOLMES ROAD

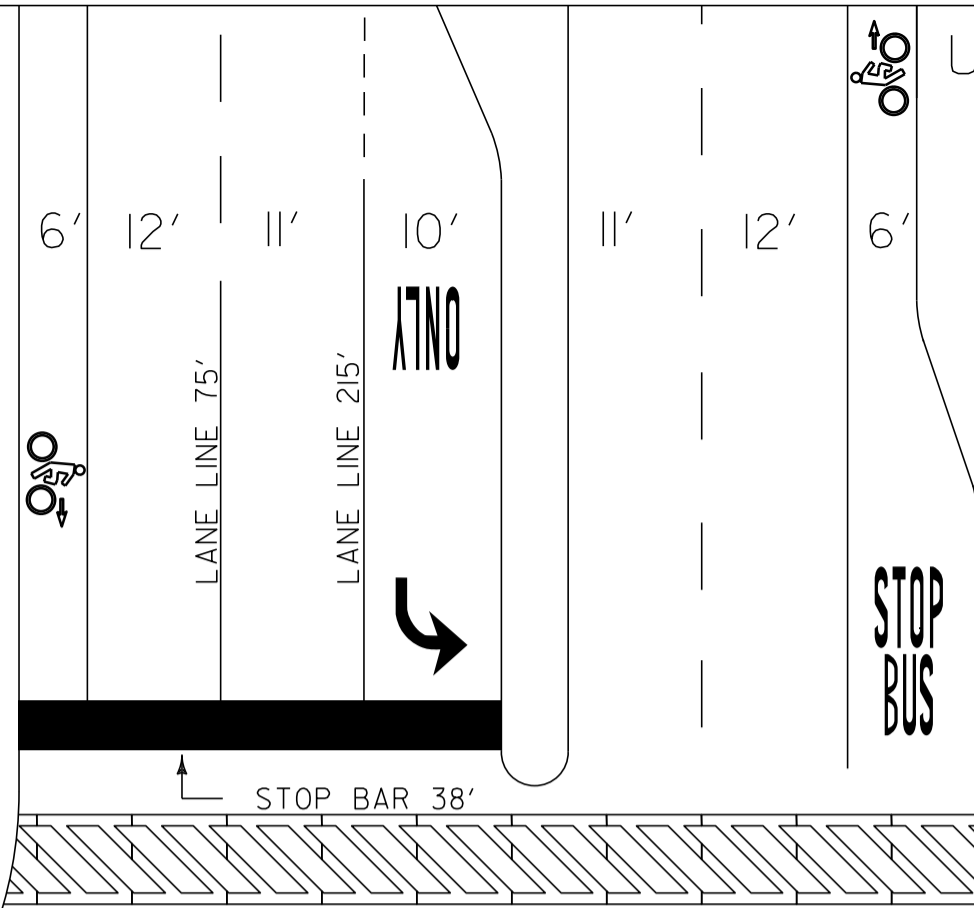

CROSSWALK 75'

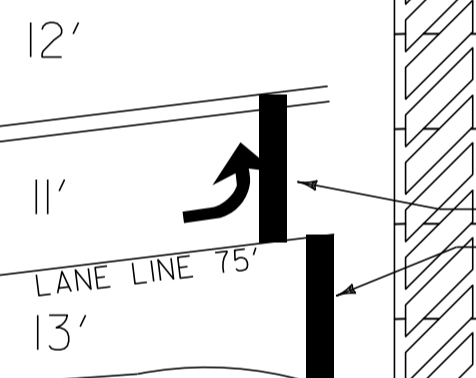


CROSSWALK 76'


STOP BAR 11'  
STOP BAR 19'

STOP BAR 26'

CROSSWALK 65'

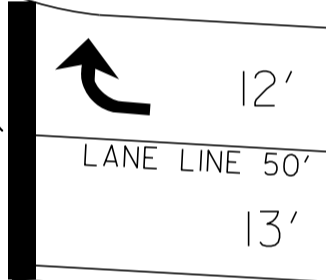

IDX DRIVE

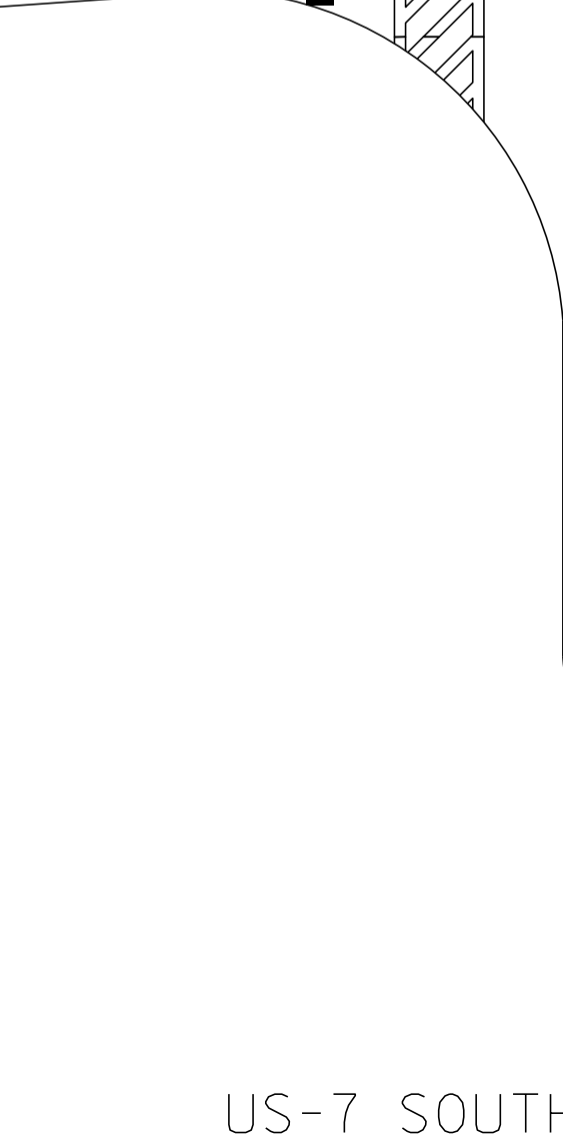

STOP BAR 38'

LANE LINE 160'

LANE LINE 135'

US-7 SOUTH

NOT TO SCALE