



MS # 519

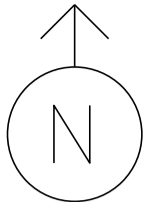

US 7 NORTH

SATURN WAY

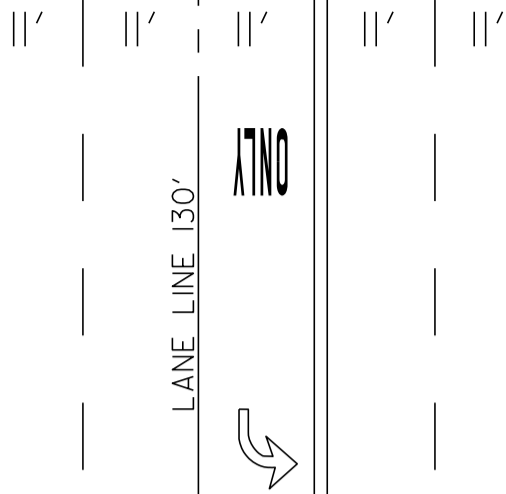

STOP BAR 34'

17'

17'

CROSSWALK 46'

STOP BAR 18'

STOP BAR 14'


14'

14'

CROSSWALK 30'

BALDWIN AVE

STOP BAR 36'

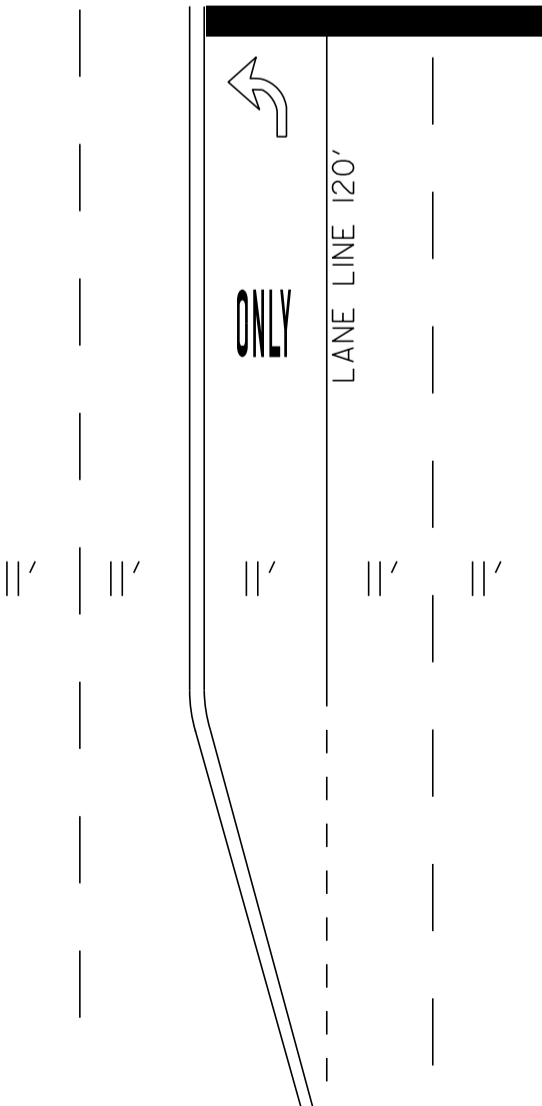

US 7 SOUTH

NOT TO SCALE