



MS # 524

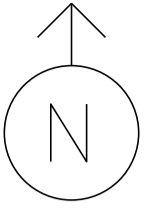

US 7 NORTH

HANNAFORDS

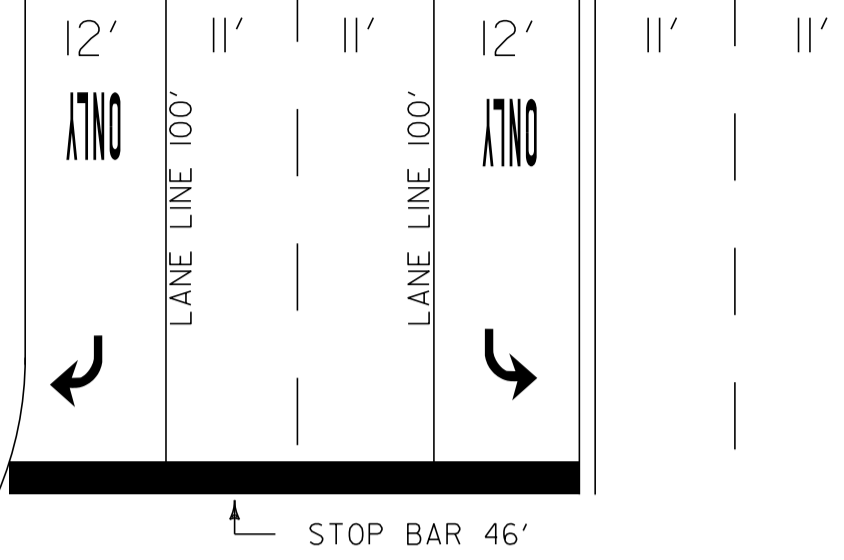

17'

12'

LANE LINE 90'

11'

LANE LINE 90'

11'

CROSSWALK 84'

STOP BAR 35'

STOP BAR 21'

CROSSWALK 68'

10'
LANE LINE 70'

11'

14'

CROSSWALK 75'

STOP BAR 35'

LANE LINE 85'

12' 12'

ONLY

11' 11' 11'

US 7 SOUTH

LAUREL HILL DRIVE

NOT TO SCALE