



FORT ETHAN ALLEN

VT 15 EAST

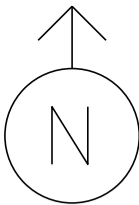

MS # 542

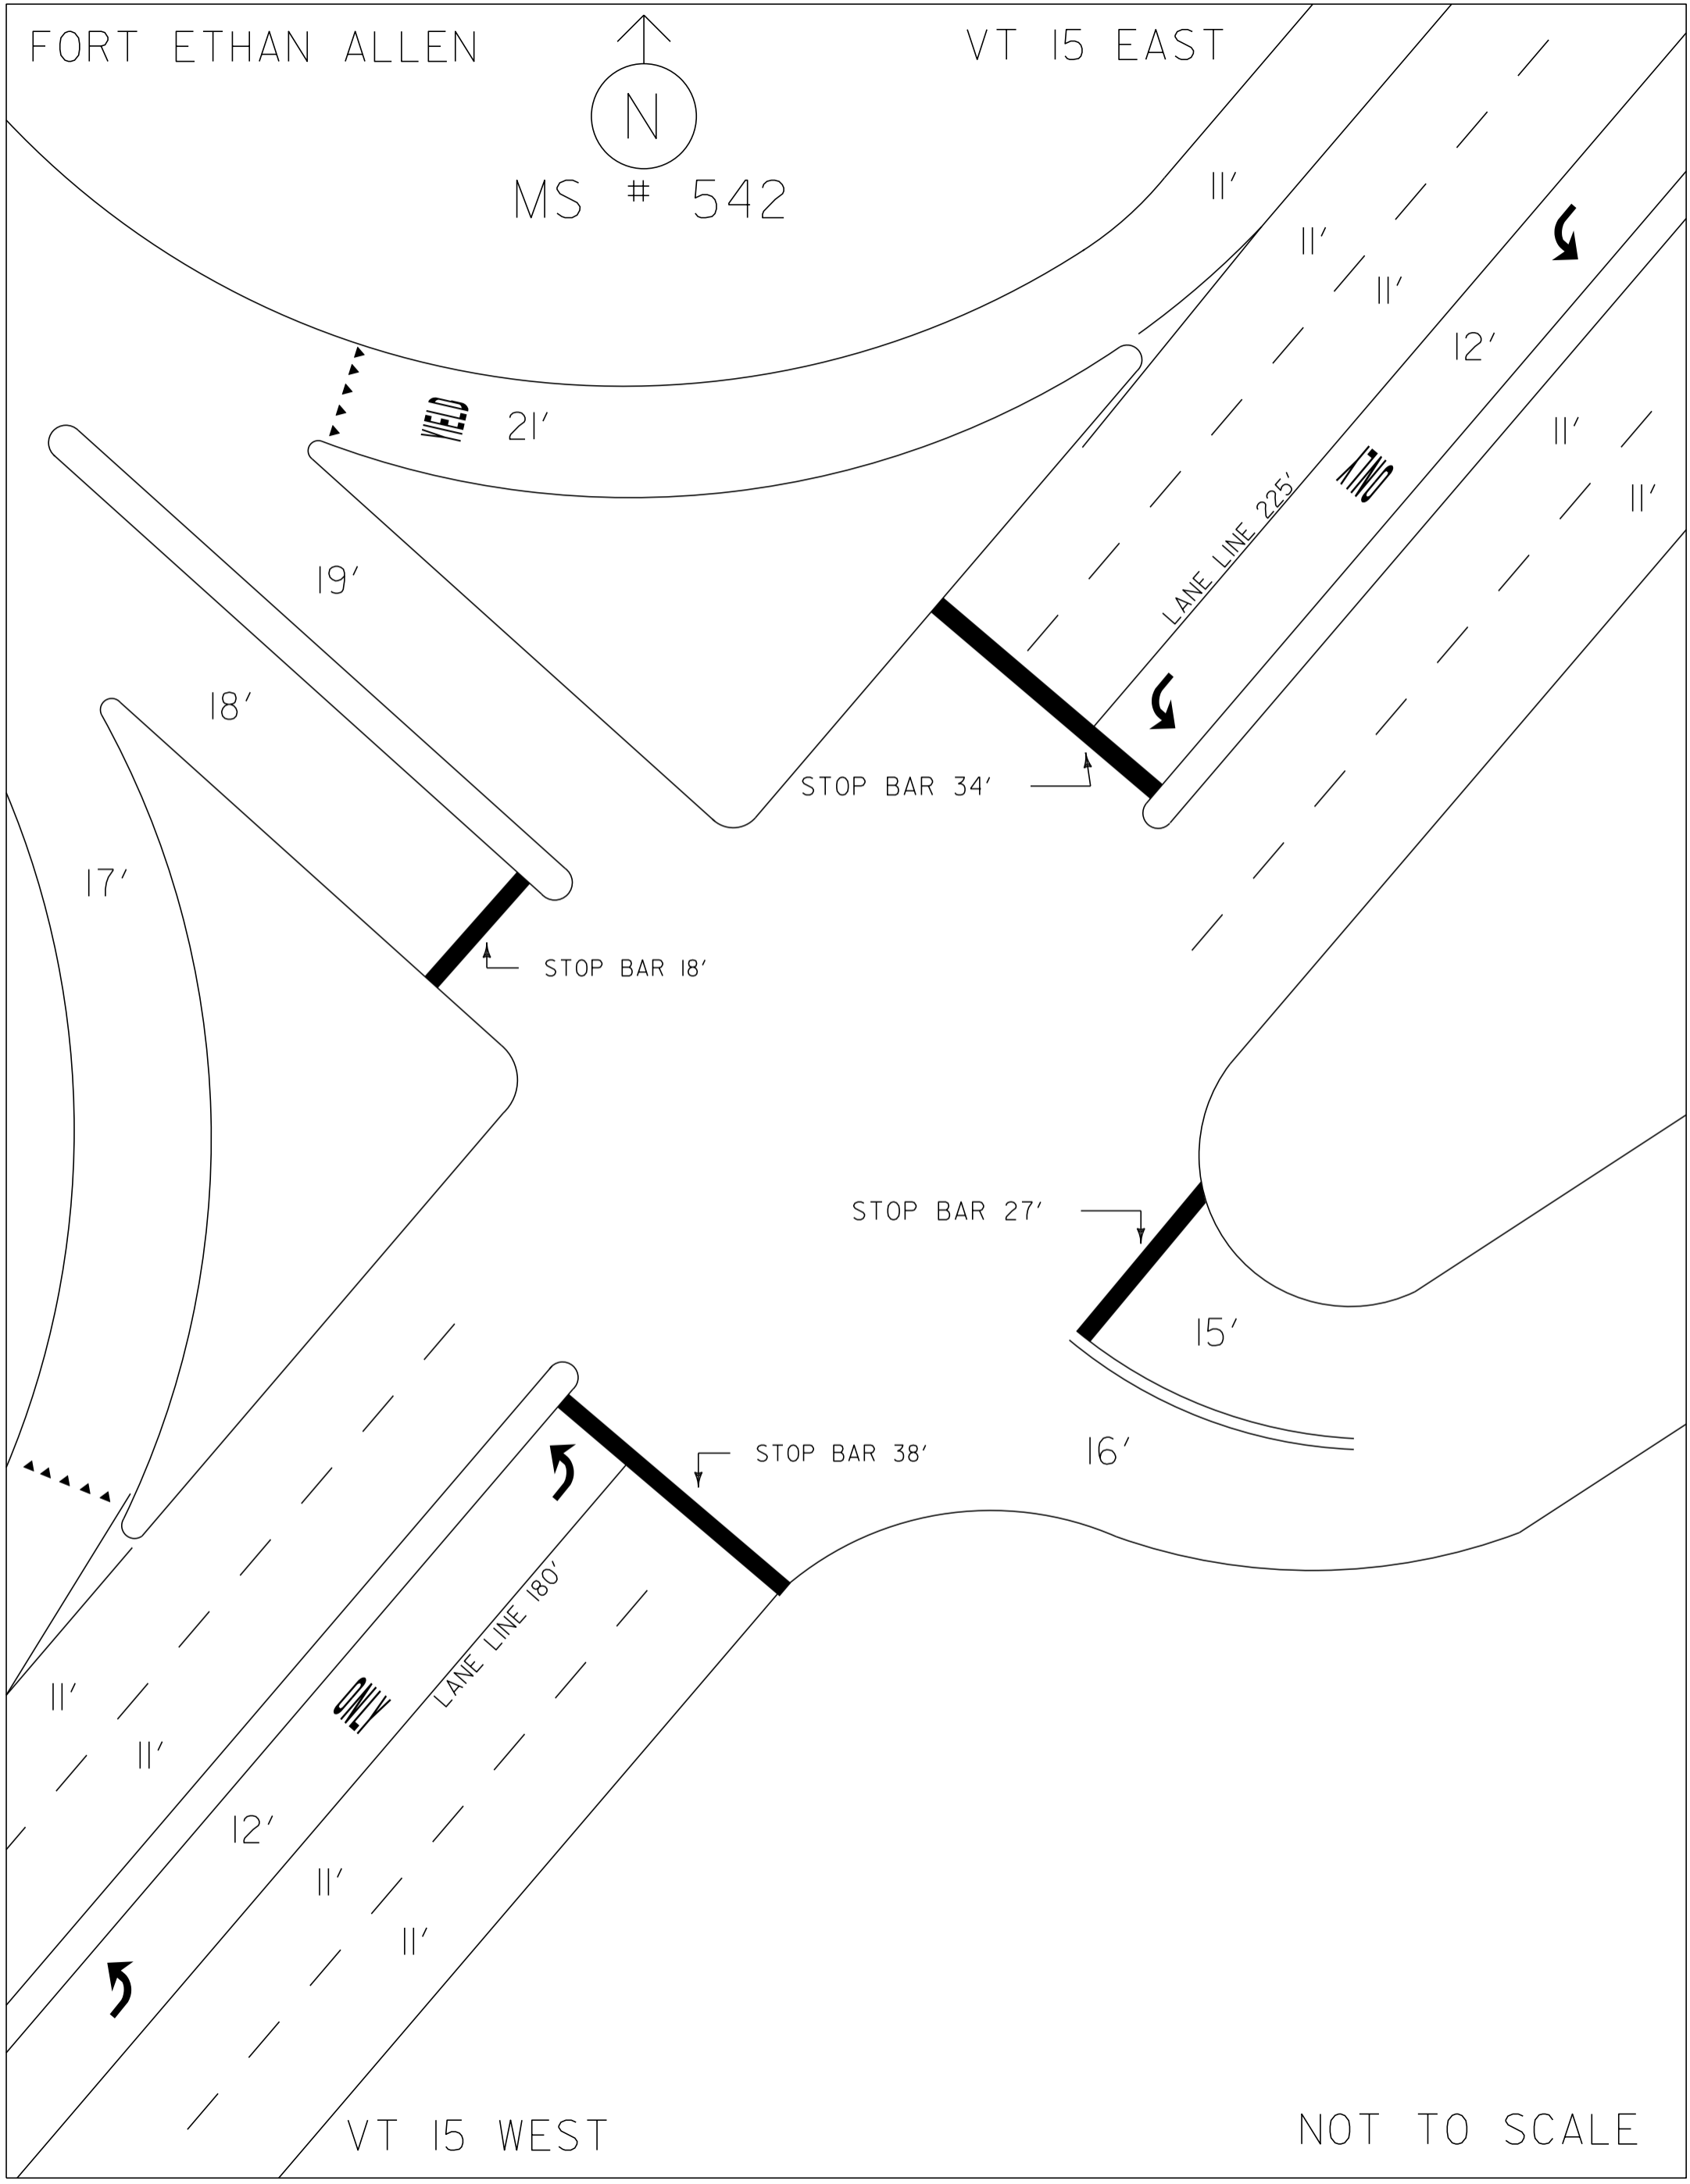

NOT TO SCALE