



MS # 554

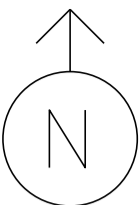

VT 289 WB ON RAMP

VT 15 WEST

VT 15 EAST

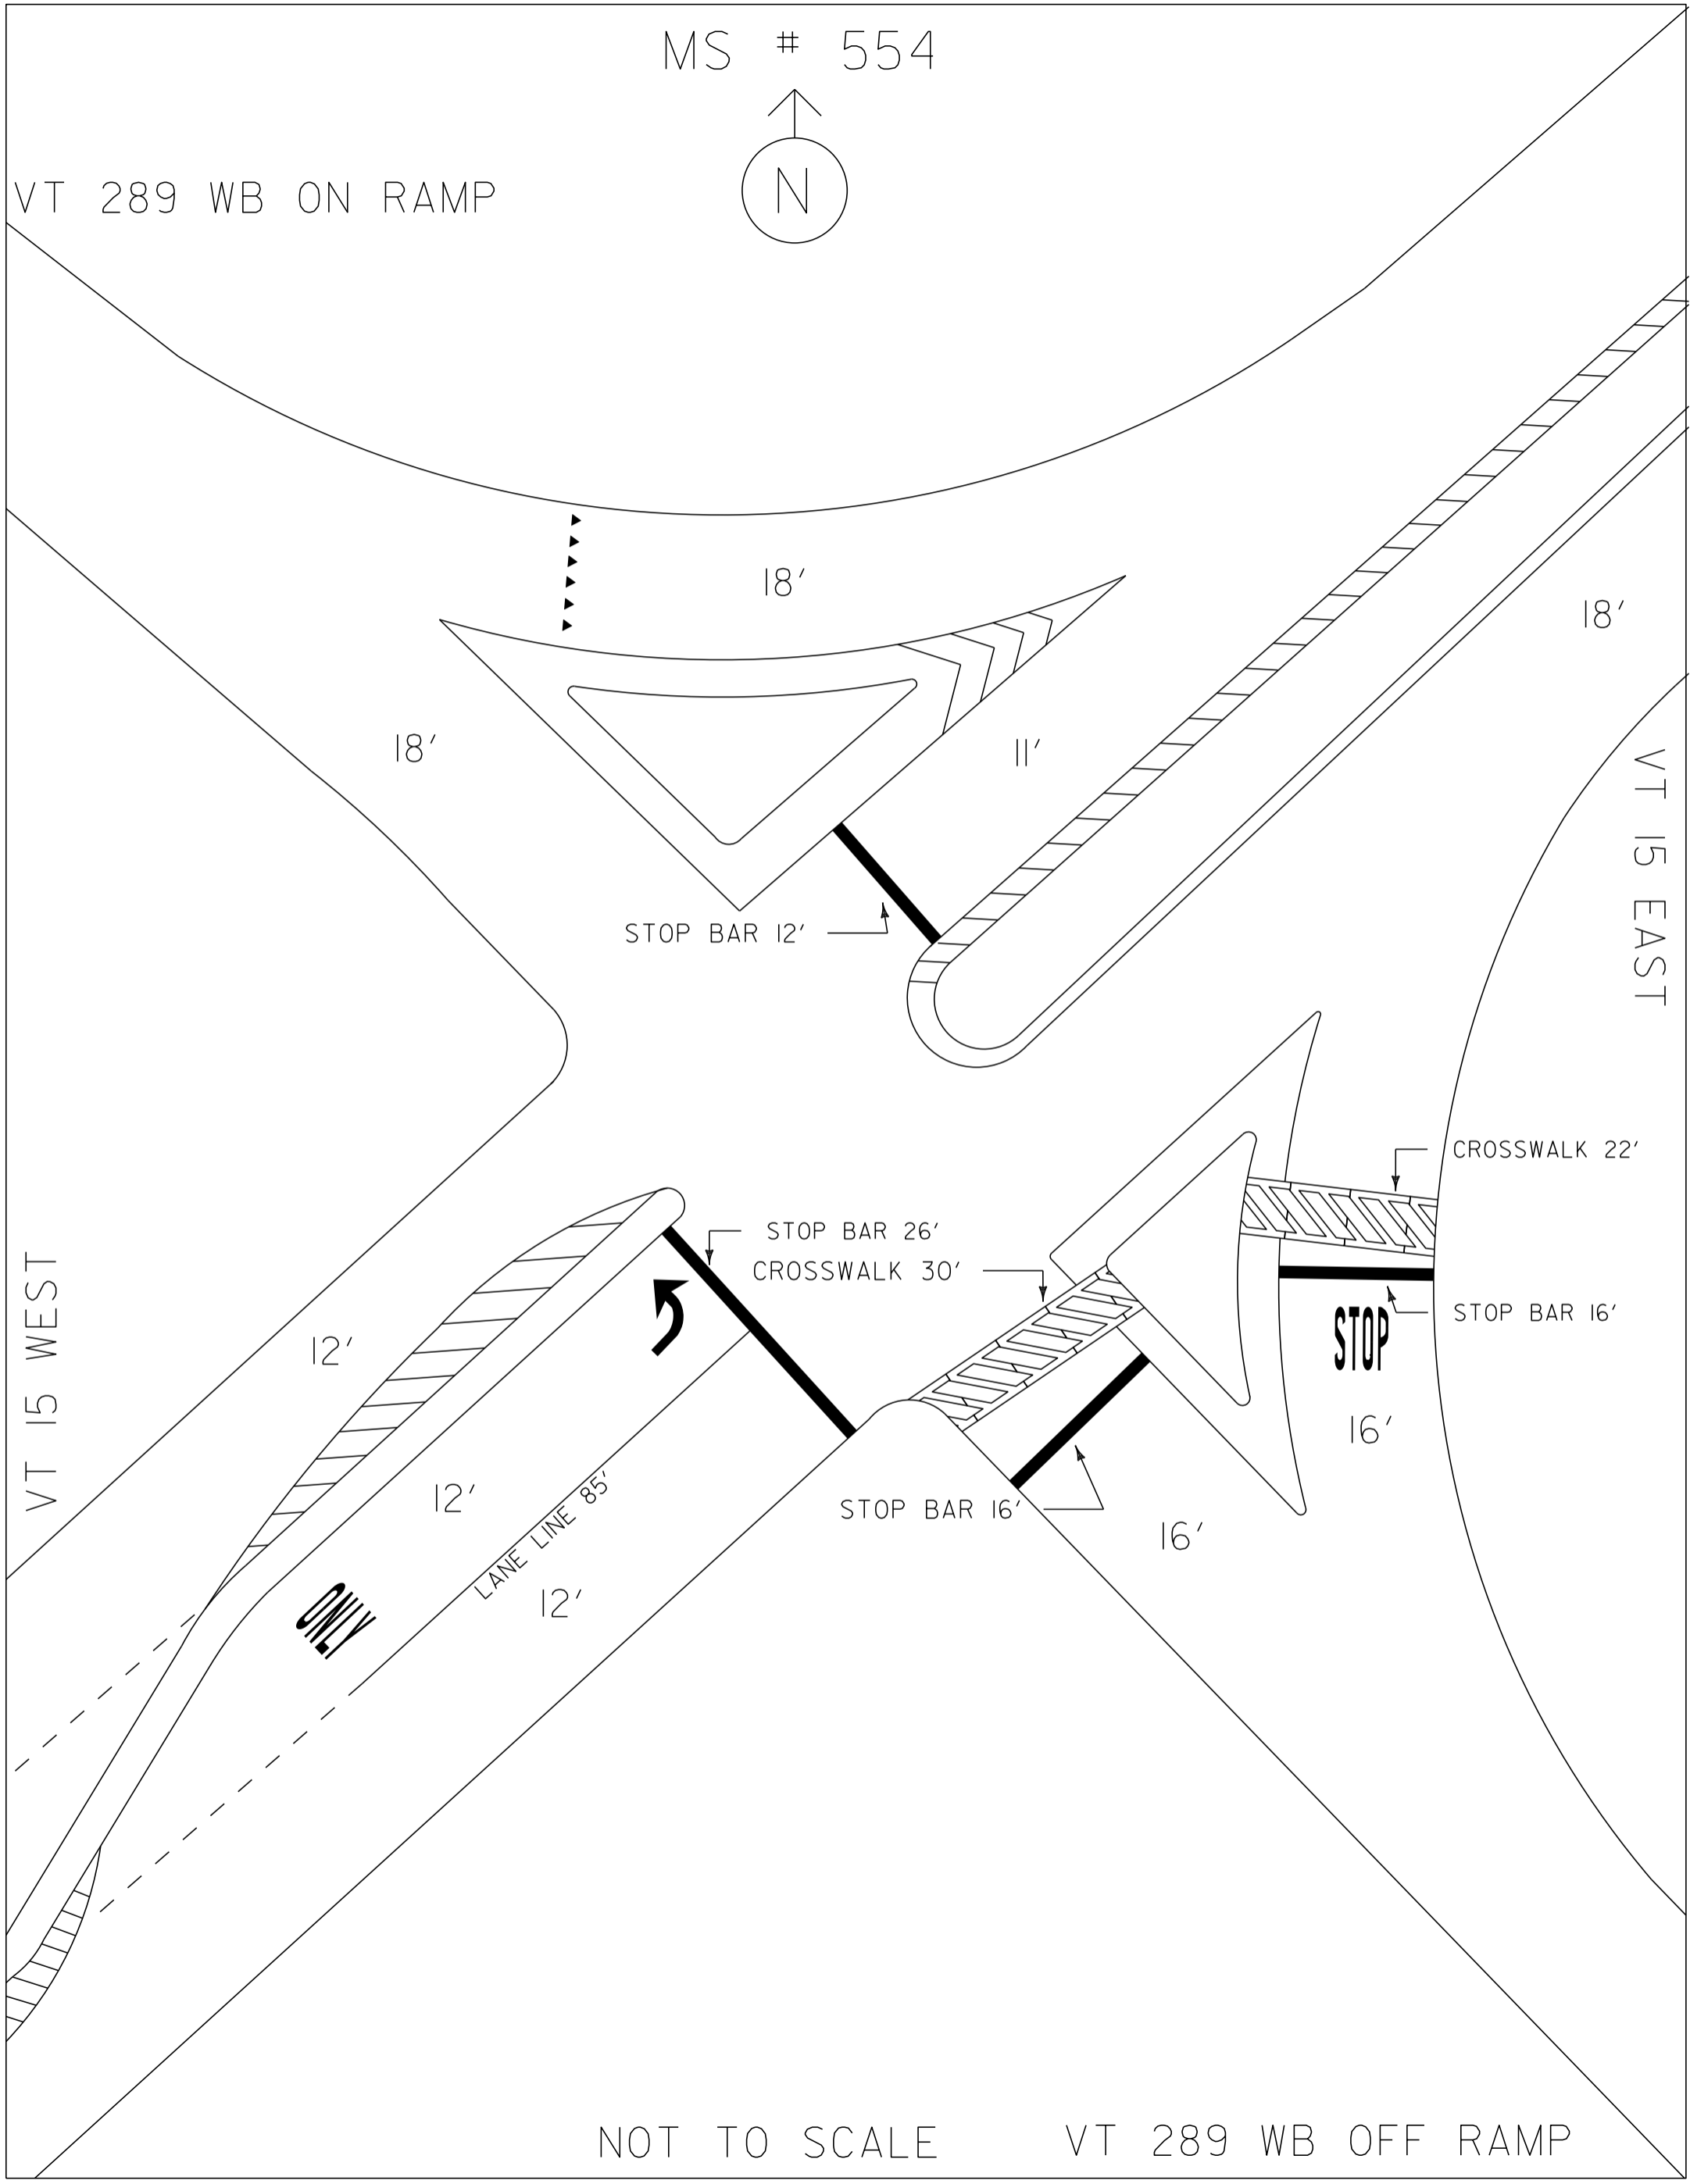

18'

18'

18'

18'

11'

STOP BAR 12'

CROSSWALK 22'

STOP BAR 26'  
CROSSWALK 30'

STOP BAR 16'

**STOP**

16'

12'

12'

LANE LINE 85'

12'

STOP BAR 16'

16'

**ONLY**

NOT TO SCALE

VT 289 WB OFF RAMP